



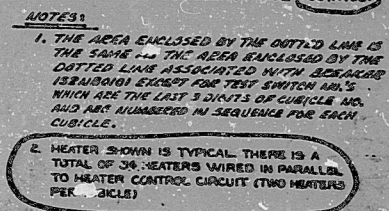

CONTACT NUMBER AND	POSITIONS			OFF
	MAIN FOR BACK	ALT. FOR BACK	O-O FOR BACK	
10-11-32			X	
30-11-00		X		
50-11-06	X			
76-11-00	X	X	X	

TERA
APERTURE
CARD

[illegible]

DATE: 1-29-72 BECHTEL (SAN FRANCISCO, CALIFORNIA) SNUPPS LOWER MEDIUM VOLTAGE SYSTEM CLASS I.E 4.16 KV THREE LINE METER AND RELAY DIAGRAM	
10468	E-03NB01013

RIDS-PDR

8104130574

