

34

22

17

11

5.8


15

11


17

22

34

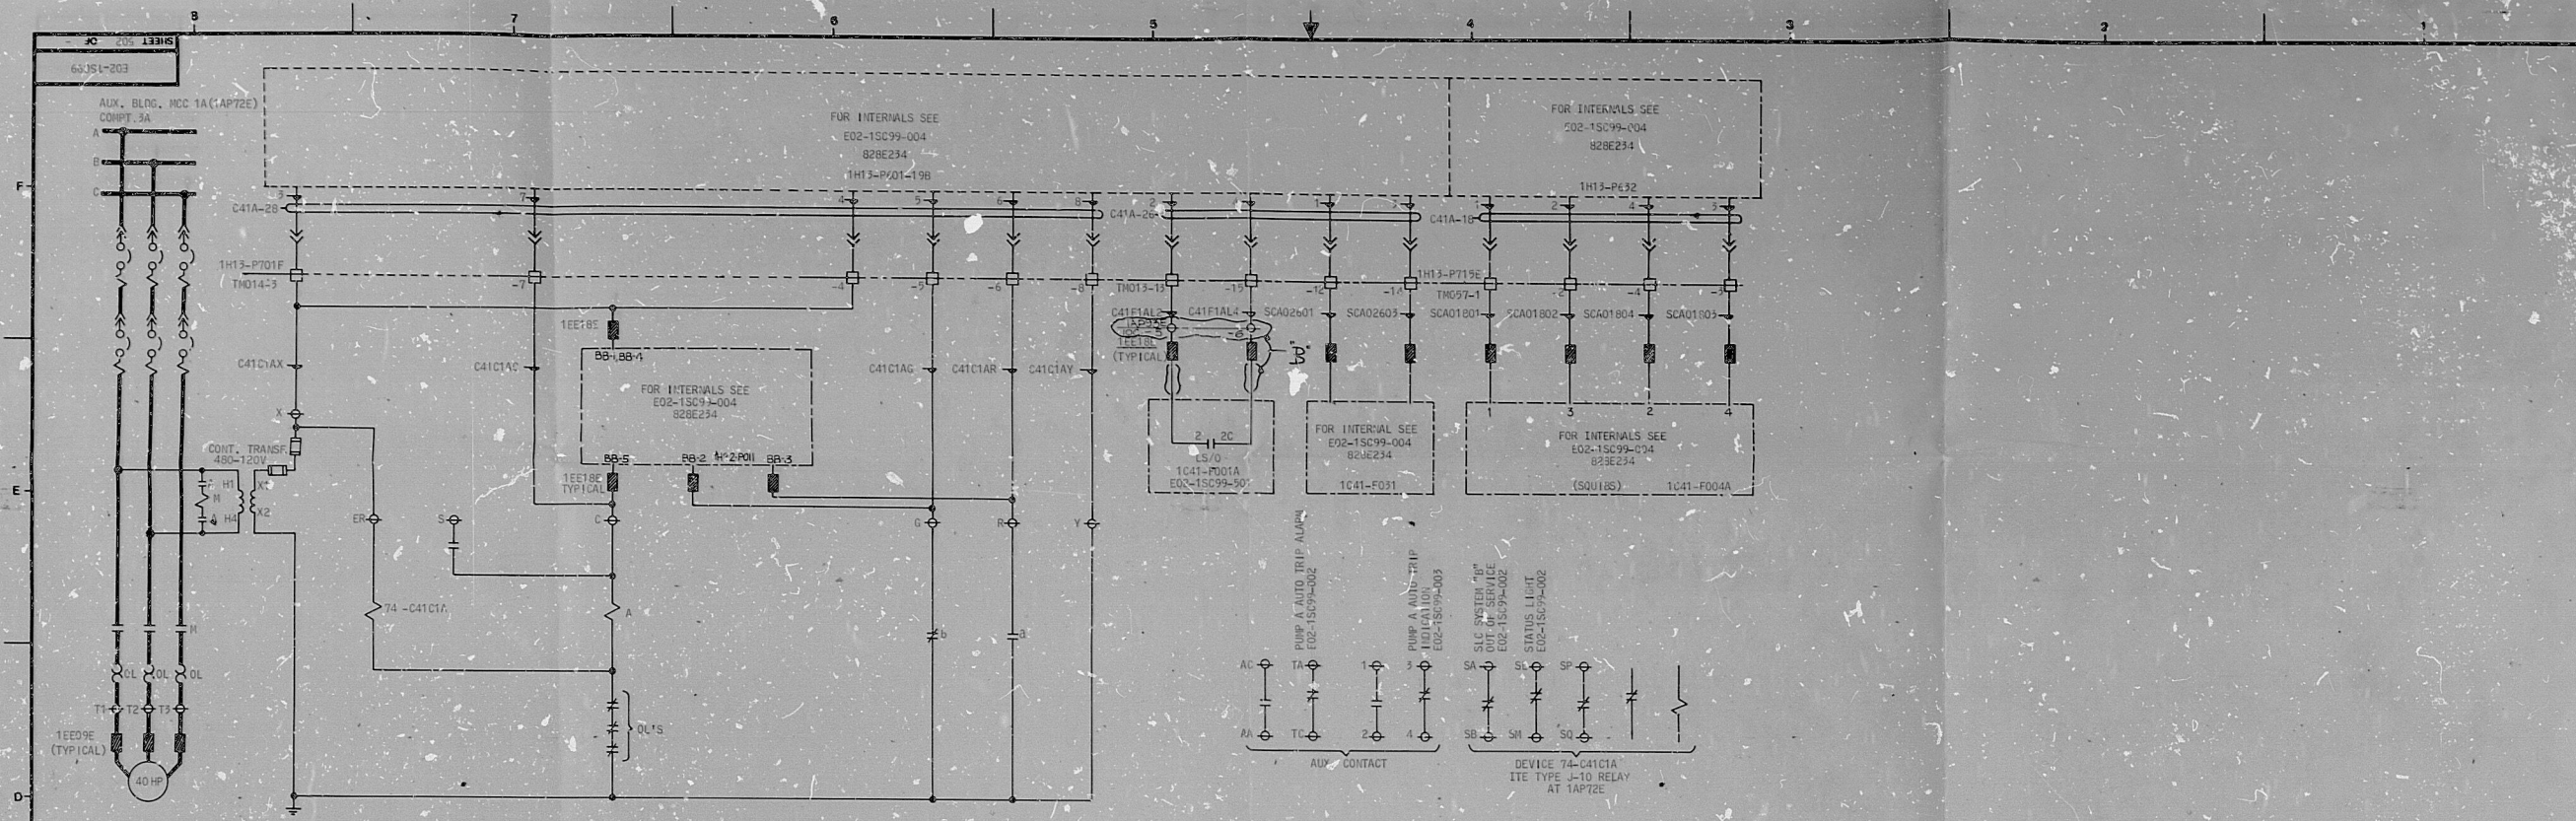

STANDBY LIQUID CONTROL PUMP 1A (1C41-C001A) (1E)  
 DEVICE C41C1A, WIRING DIAGRAM DWG. E02-1A772E-003

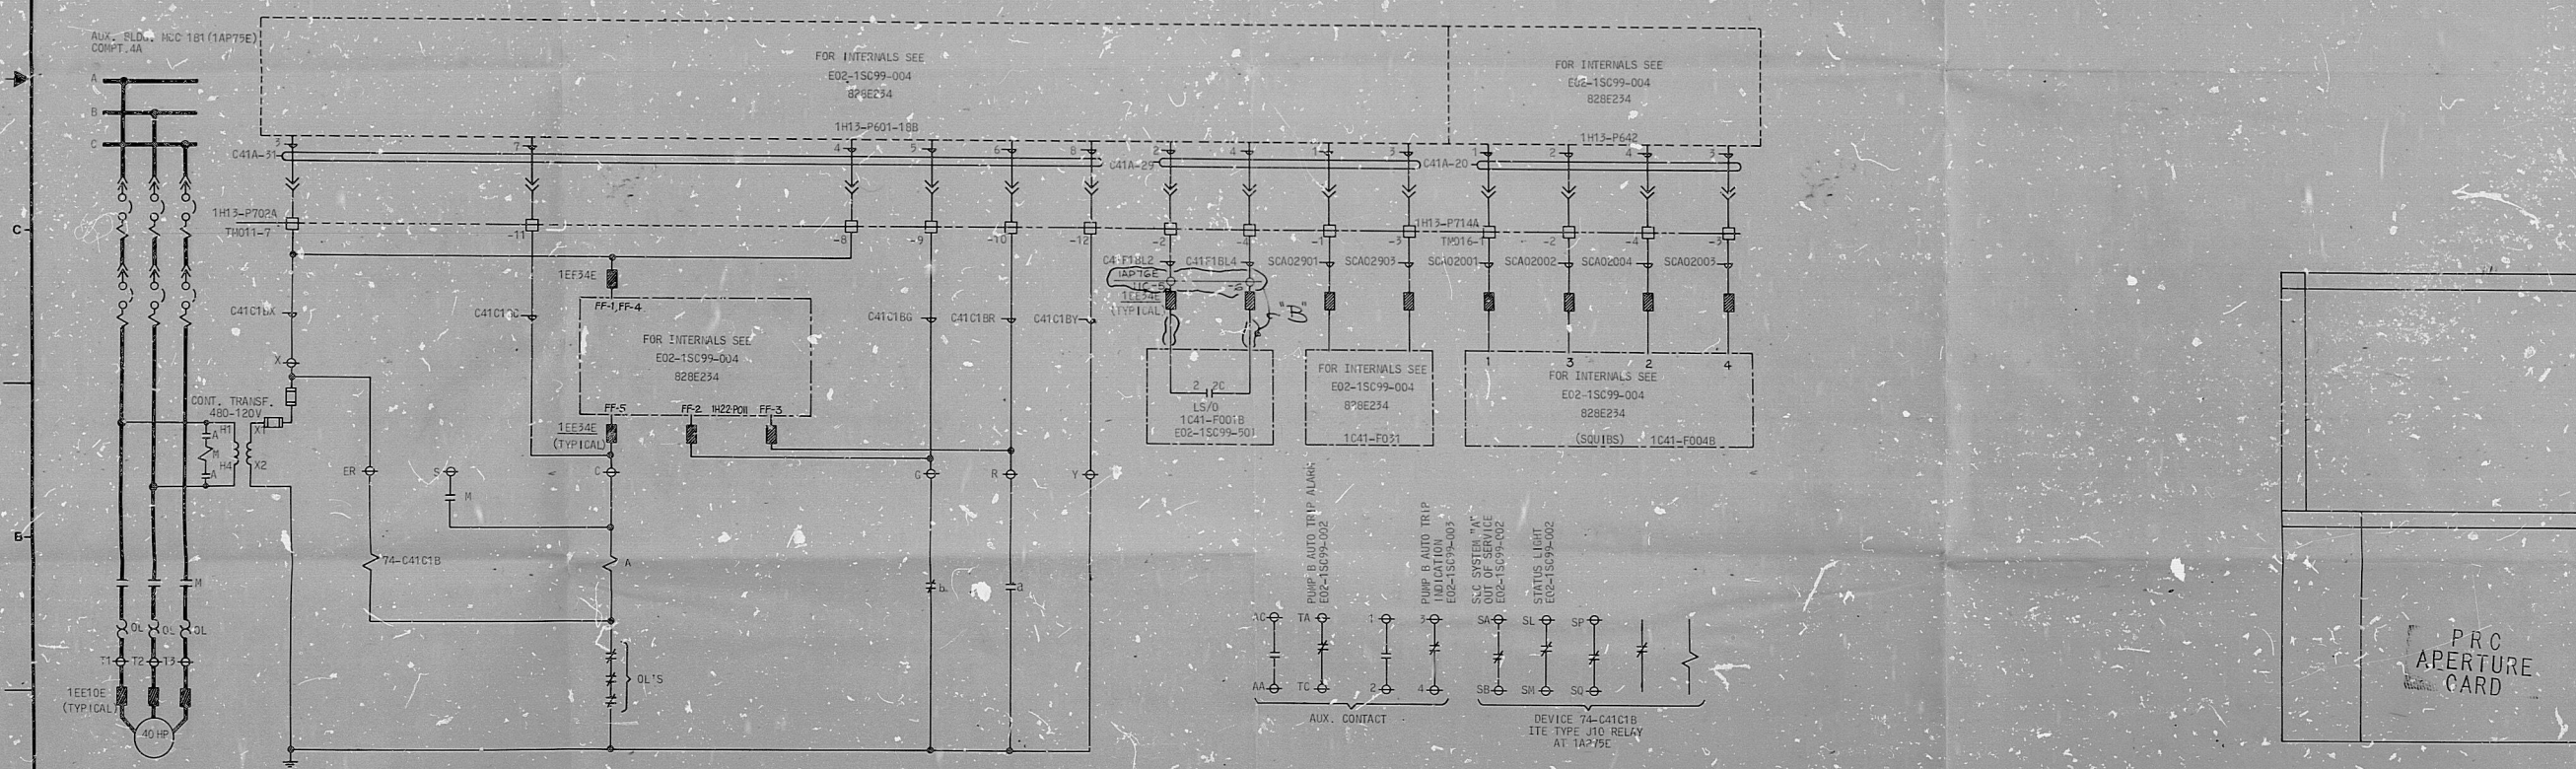

STANDBY LIQUID CONTROL PUMP 1B (1C41-C001B) (2E)  
 DEVICE C41C1B, WIRING DIAGRAM DWG. E02-1A772E-004

LINE CODES USED C41A - 18, 20, 26, 28, 27, 31  
 FOR NOTES AND REFERENCE DATA SEE E02-15C99-001

DRAWING RELEASE RECORD					DRAWING RELEASE RECORD								
REV.	DATE RECD.	PREPARED	REVIEWED	APPROVED	PURPOSE	FILM	REV.	DATE RECD.	PREPARED	REVIEWED	APPROVED	PURPOSE	FILM
							A	12-23-76	J. J. [unclear]	[unclear]	[unclear]	RELEASED FOR CONSTRUCTION, SPEC. K-2999	
							B	3-26-81	[unclear]	[unclear]	[unclear]	MISC. REV. FOR CONSTRUCTION, SPEC. K-2999	



SCALE  
 PRODUCT NUMBER

**NUCLEAR SAFETY RELATED**  
 EQUIPMENT IS SHOWN ON THIS DRAWING.  
 (FOR SAFETY CLASSIFICATION SEE EQUIPMENT, VALVE, OR INSTRUMENT LISTS.)

SCHEMATIC DIAGRAM  
 STANDBY LIQUID CONTROL SYSTEM (SC)  
 STANDBY LIQUID CONTROL PUMPS 1A, 1B  
 1C41-C001A & 1C41-C001B  
 CLINTON POWER STATION UNIT 1  
 ILLINOIS POWER COMPANY  
 CLINTON, ILLINOIS

**SARGENT & LUNDY**  
 ENGINEERS  
 CHICAGO

DRAWING NO. E02-15C99  
 REV. B  
 SHEET 202 OF 202





RIDS

8210120060

