


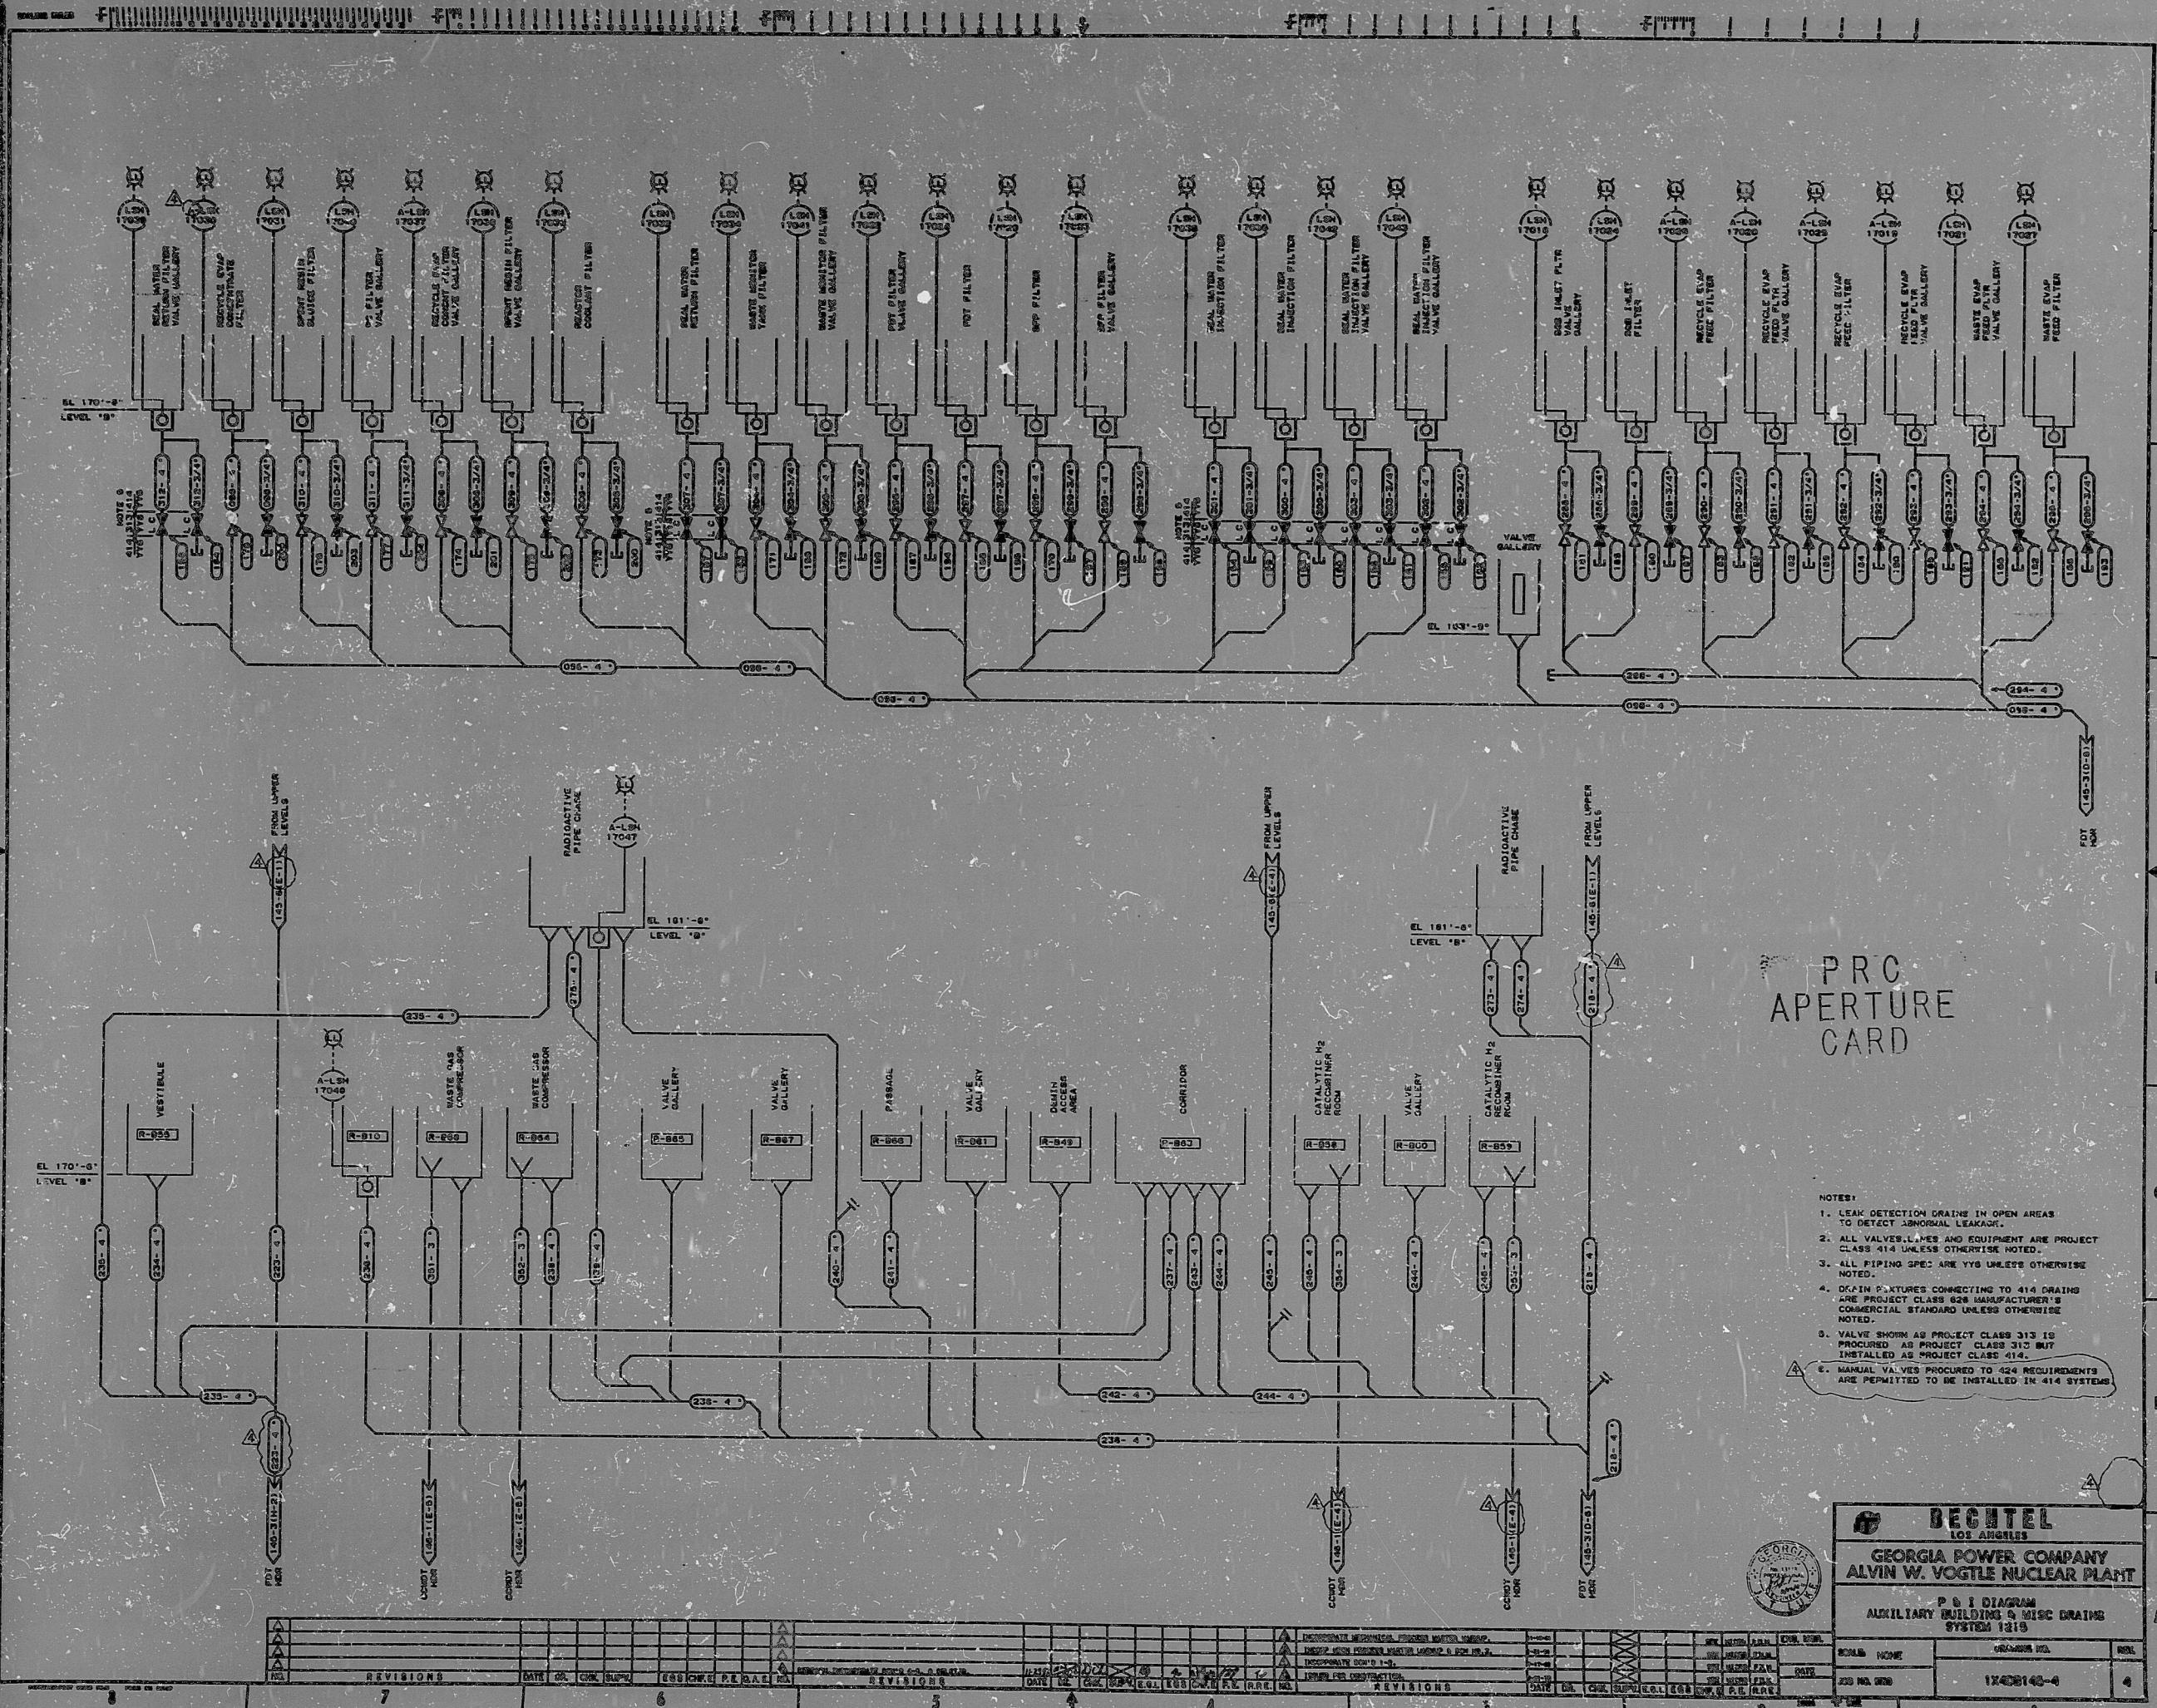

RIDS

8309260168

