
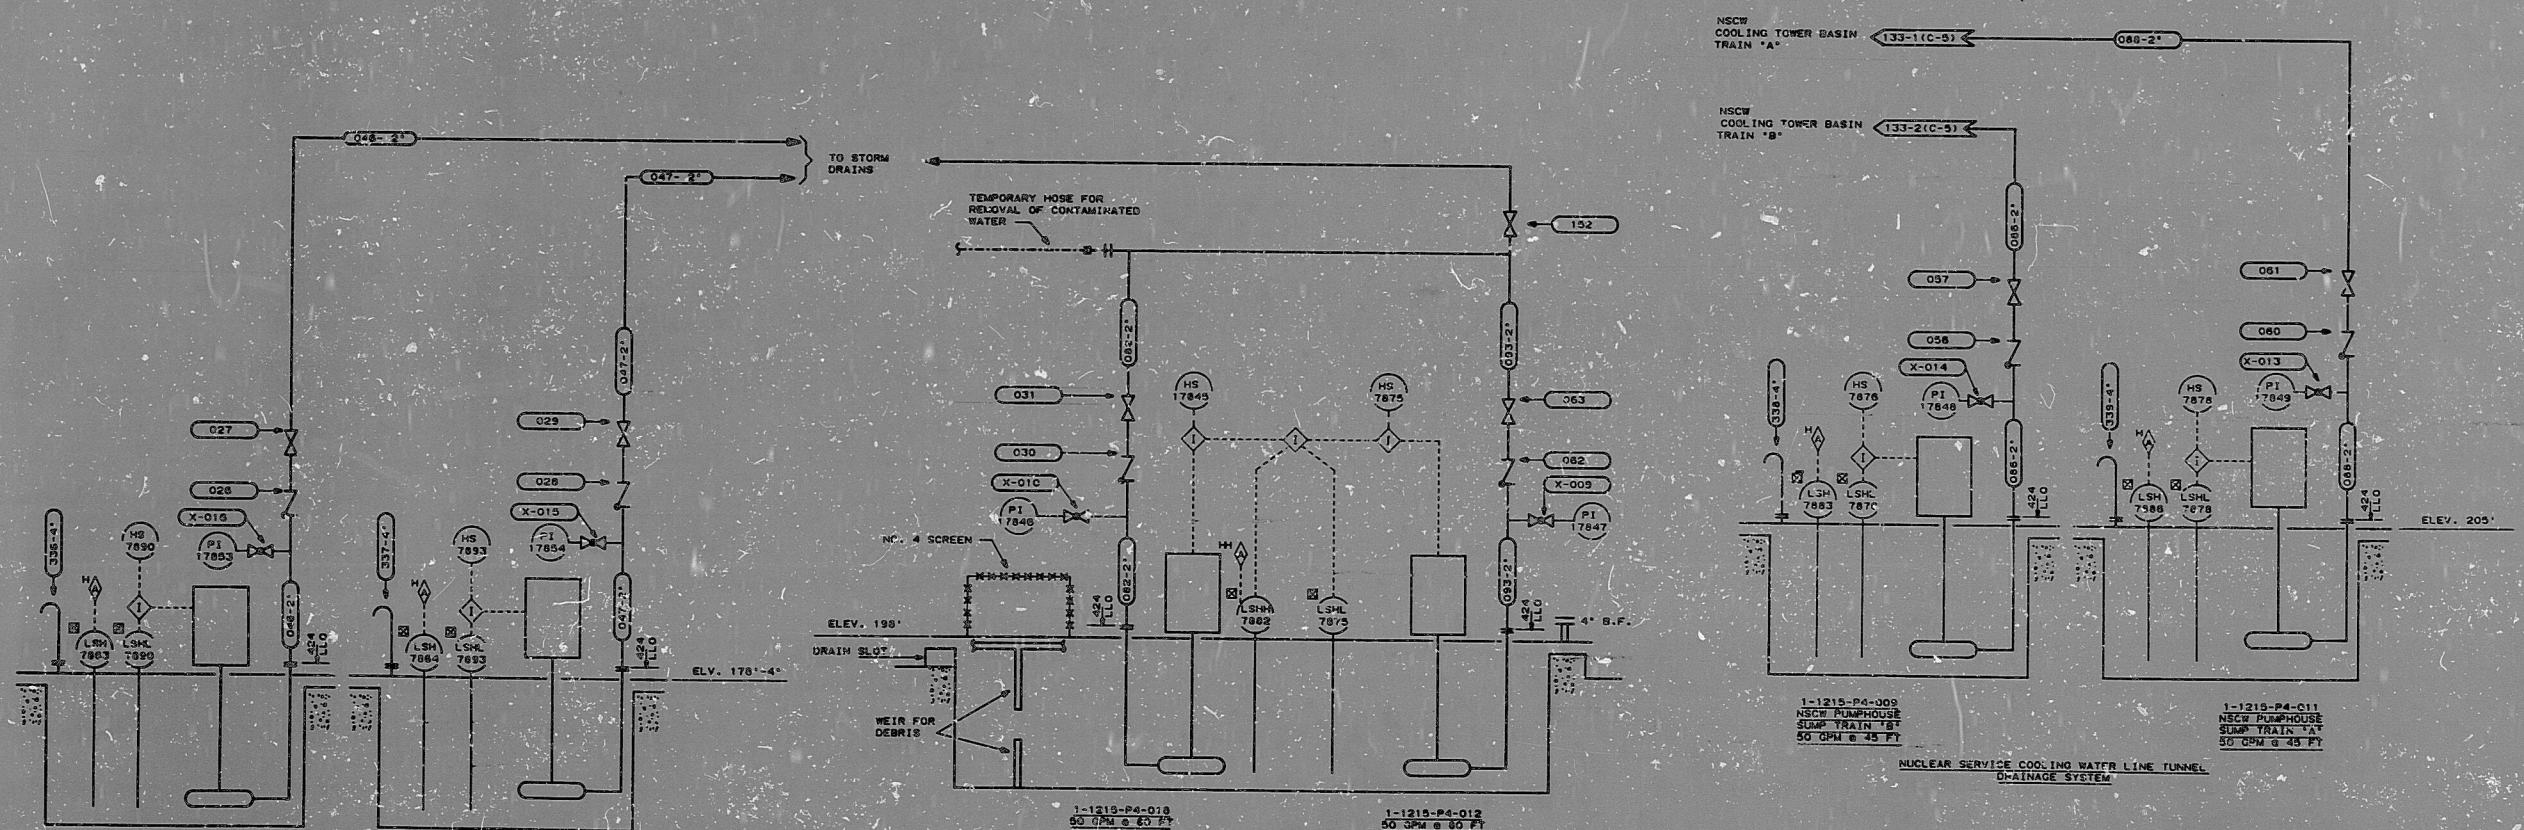


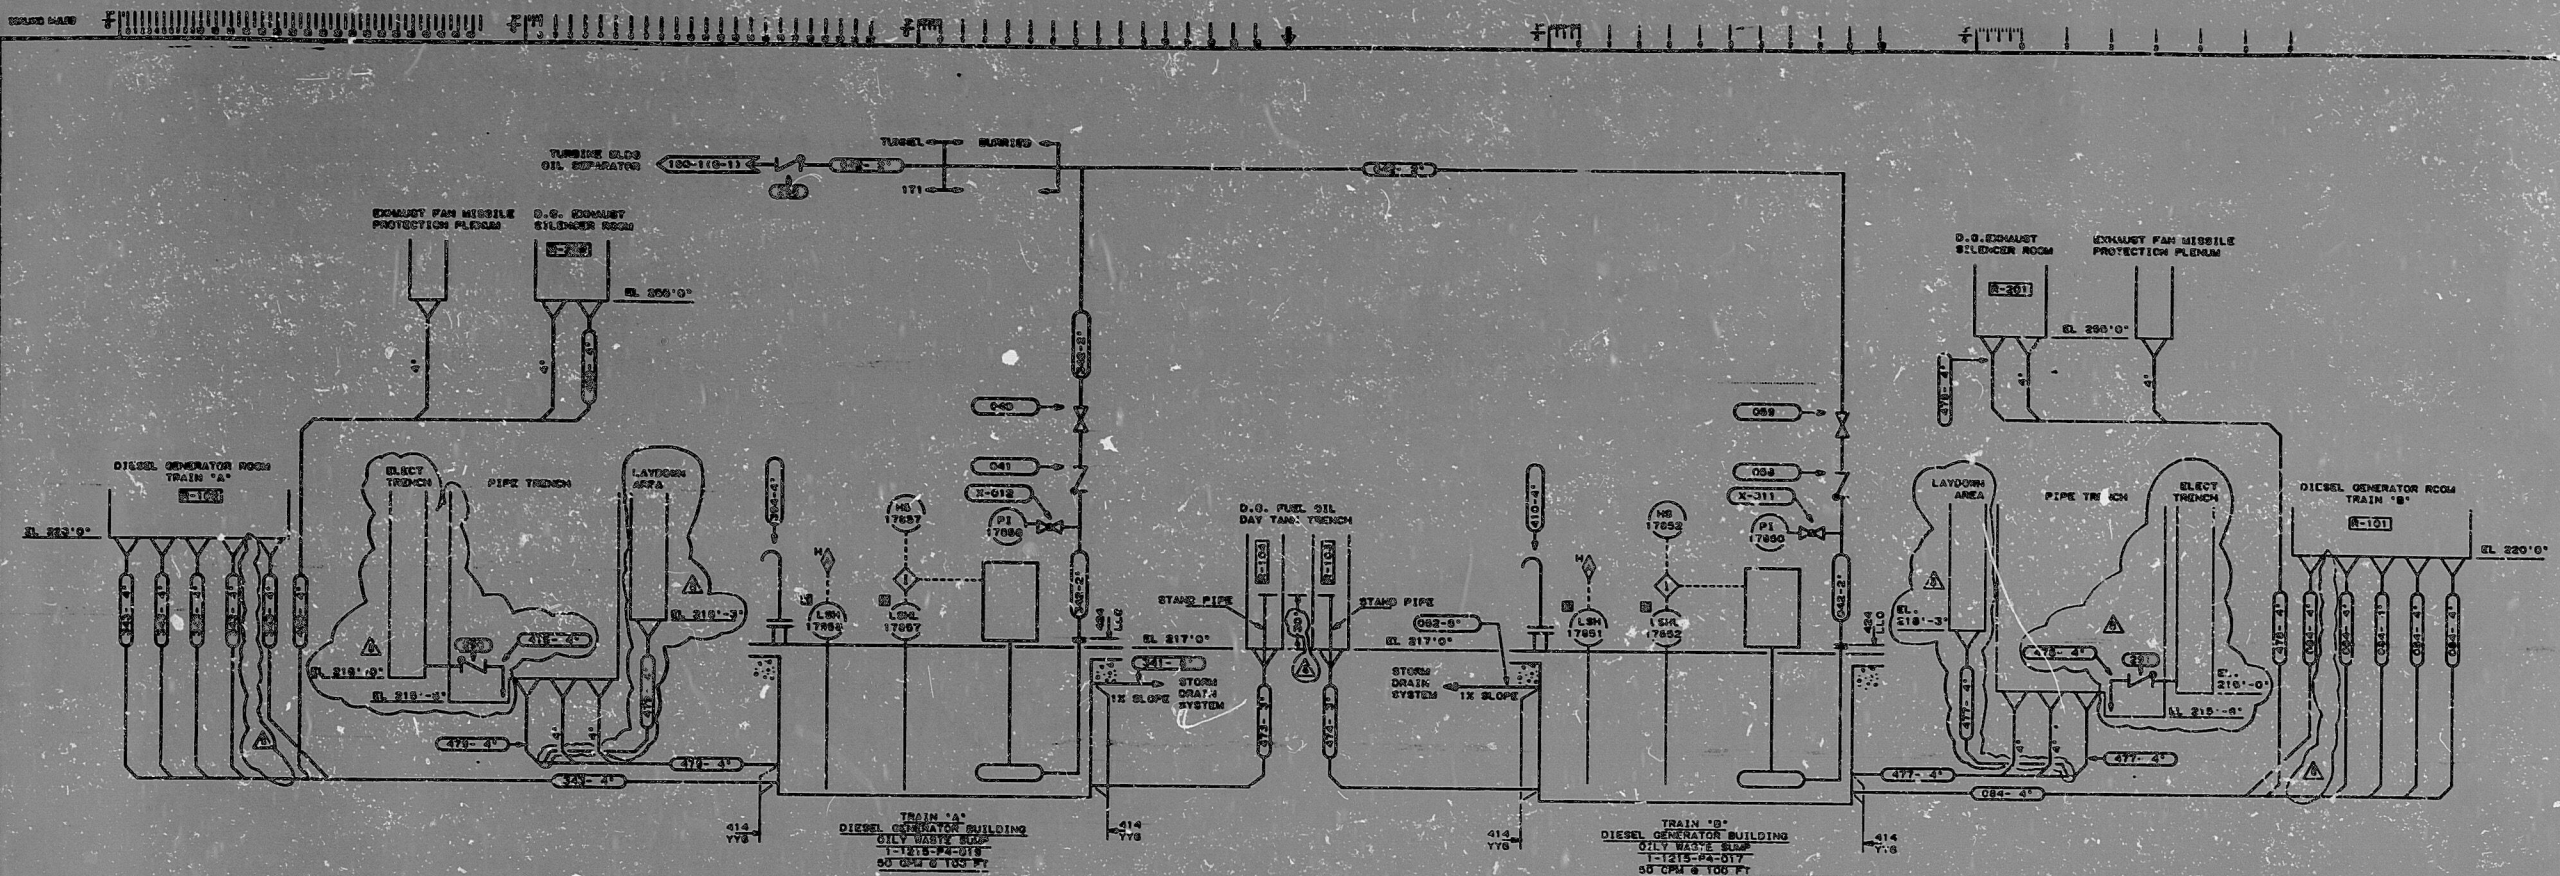

PRC
APERTURE
CARD

NOTES.

1. MANUAL VALVES PROCURED TO 424 REQUIREMENTS ARE PERMITTED TO BE INSTALLED IN 414 SYSTEMS.

 BECHTEL LOS ANGELES		
GEORGIA POWER COMPANY ALVIN W. VOGTE NUCLEAR PLANT		
P & I DIAGRAM AUXILIARY BUILDING & MISC. DRAINS SYSTEM NO. 1215		
SCALE: NONE	DRAWING NO.	REV.
JOB NO. 5133	1X400143-2	\$

RIDS

8309260184

