

34

22

11

11


58

85

11

17

22

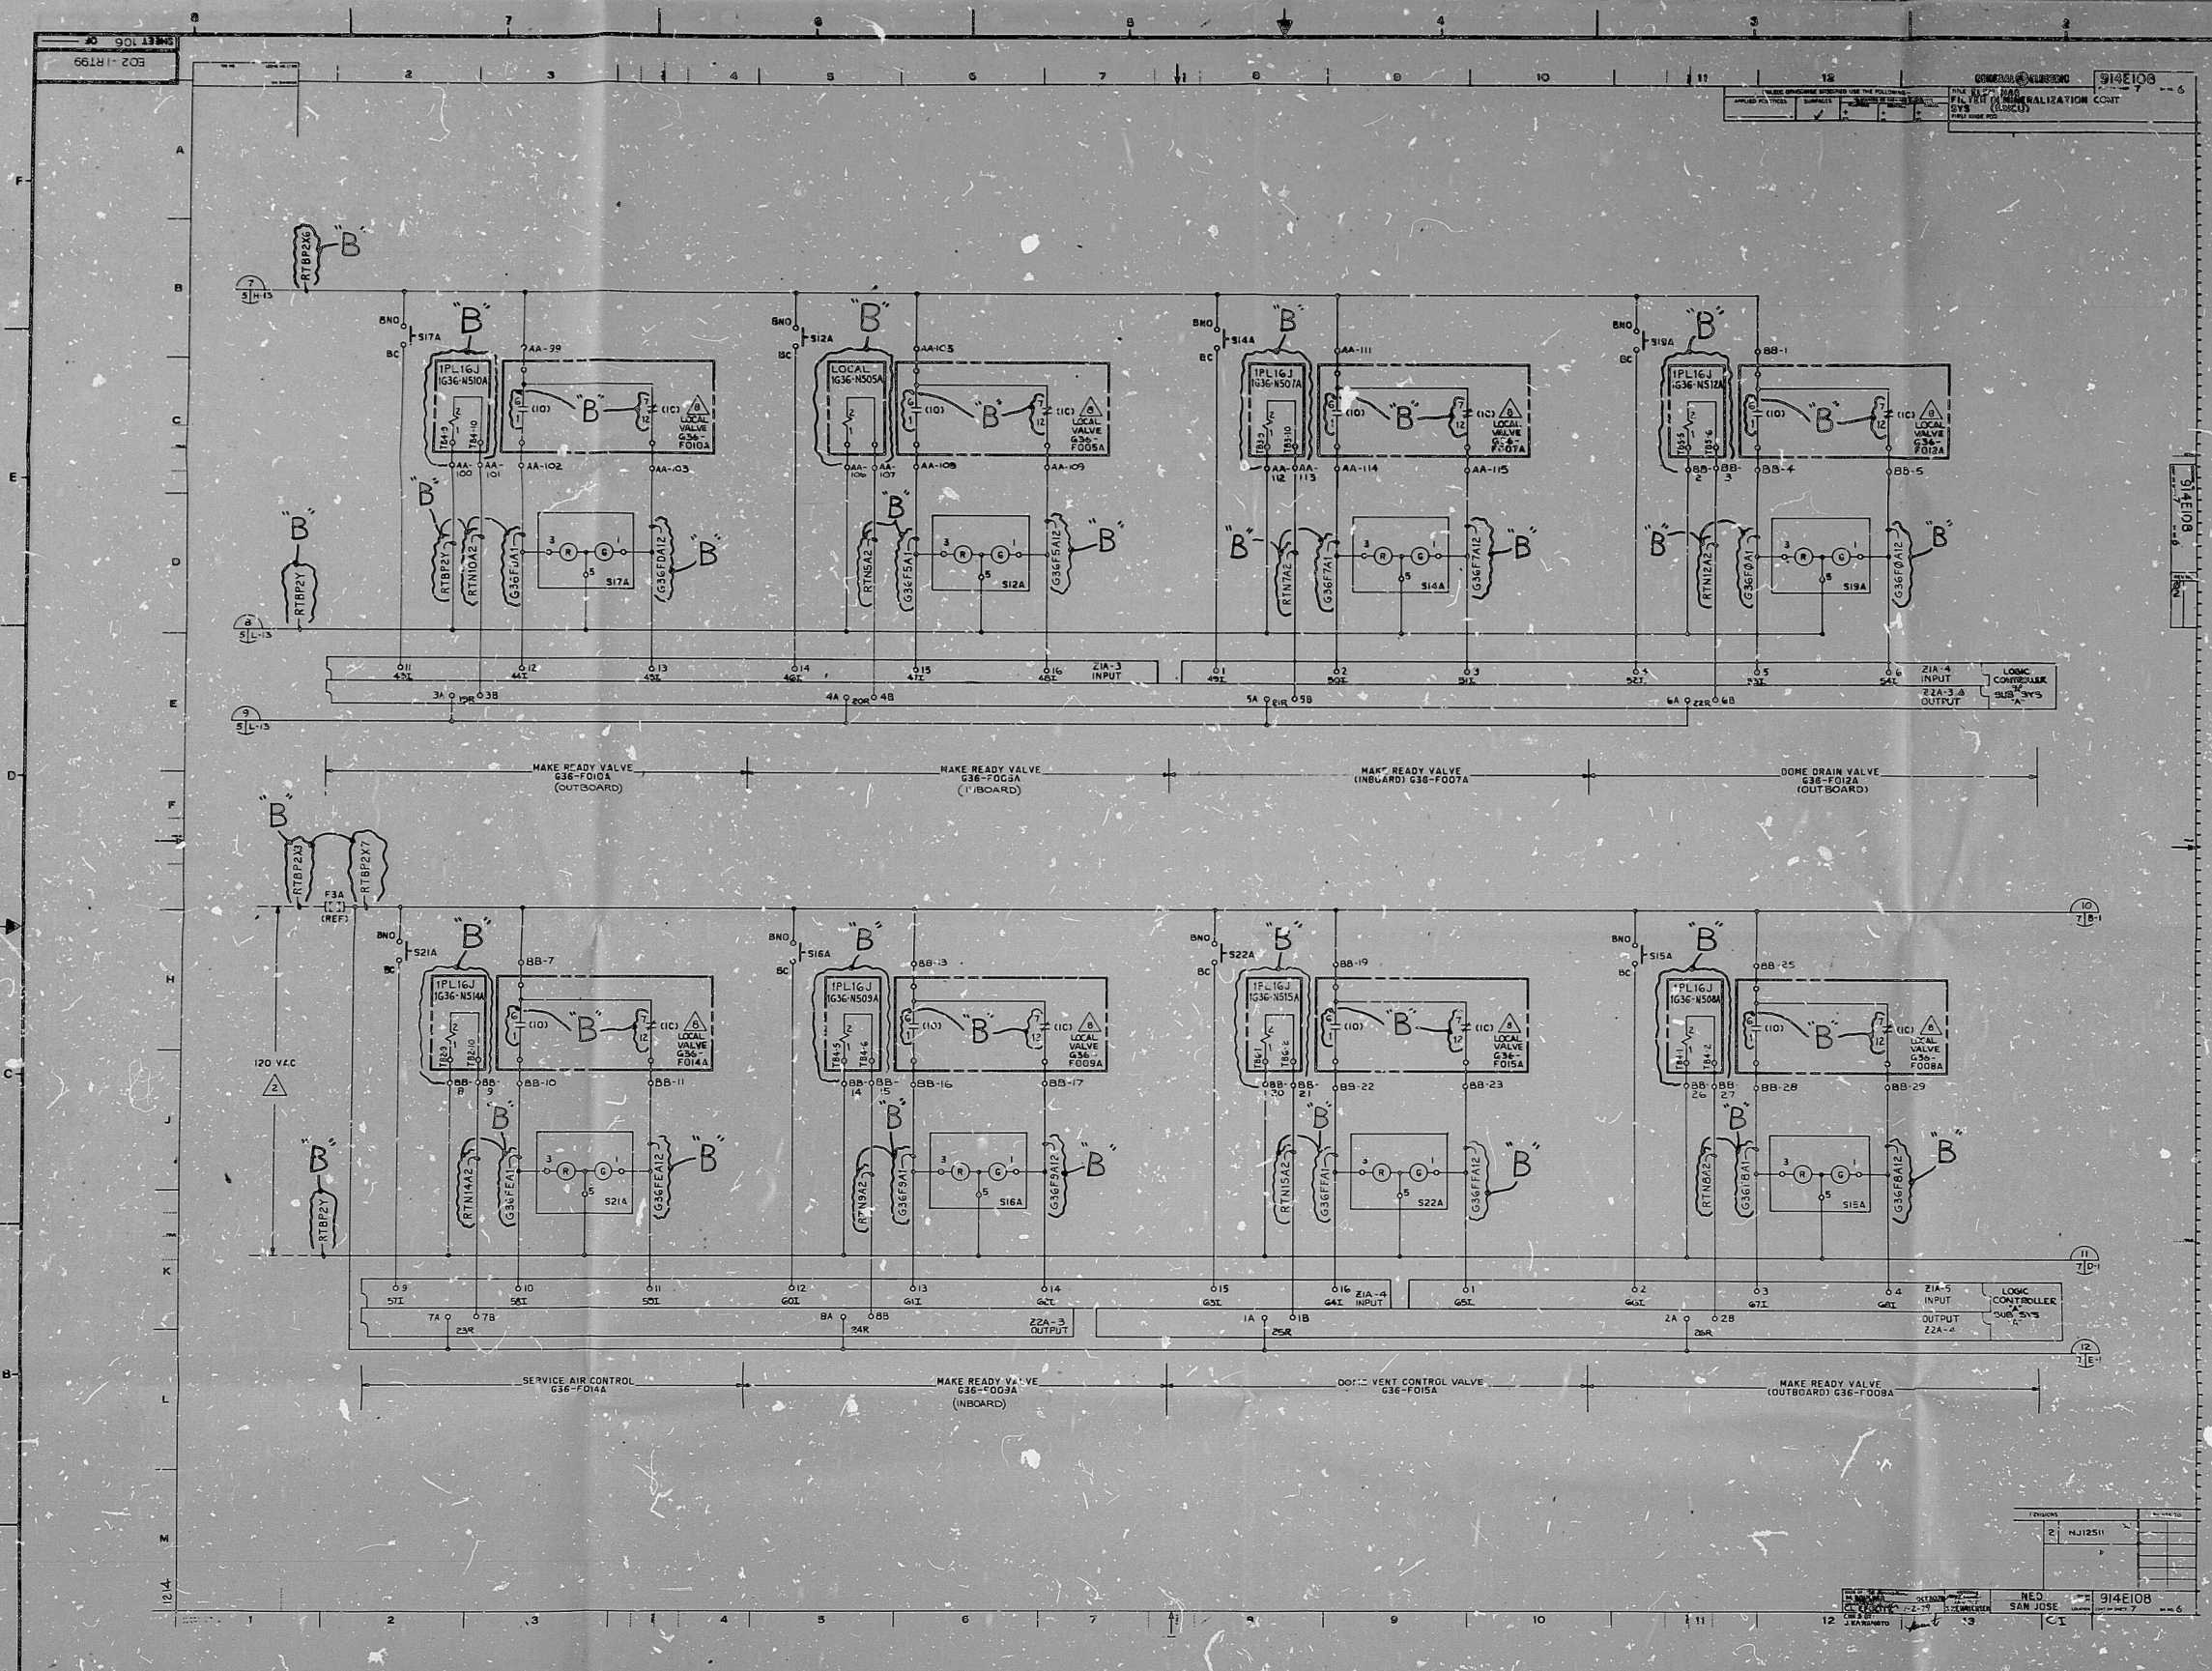

914E108
 FILTER DEMINERALIZATION CONT.
 (RT)

NEO
 SAN JOSE
 914E108
 C-1

PROC
 APERTURE
 CARD

DRAWING RELEASE RECORD				DRAWING RELEASE RECORD				SCALE		PROJECT		DRAWING NO.	
REV.	DATE	REL'D.	PREPARED	REVIEWED	APPROVED	PURPOSE	FILM	SCALE	PROJECT NUMBER	CLINTON POWER STATION UNIT 1	DRAWING NO.	REV.	
A	2-28-61		<i>R. N. Taylor</i>	<i>Adrian J. Miller</i>	<i>W. J. ...</i>	RELEASED FOR CONSTRUCTION SPEC. NO. 2999			4556	ILLINOIS POWER COMPANY	E02-1R199	B	
B	8-29-65		<i>Ch. G. ...</i>	<i>Adrian J. Miller</i>	<i>W. J. ...</i>	REVISED FOR CONSTRUCTION & MISC. CHANGES, SPEC. K-2999				CLINTON, ILLINOIS	E02-1R199	B	

SARGENT & LUDY
 CHICAGO
 DRAWING NO. E02-1R199
 REV. B
 SHEET 106 OF

RIDS

8210120076

