
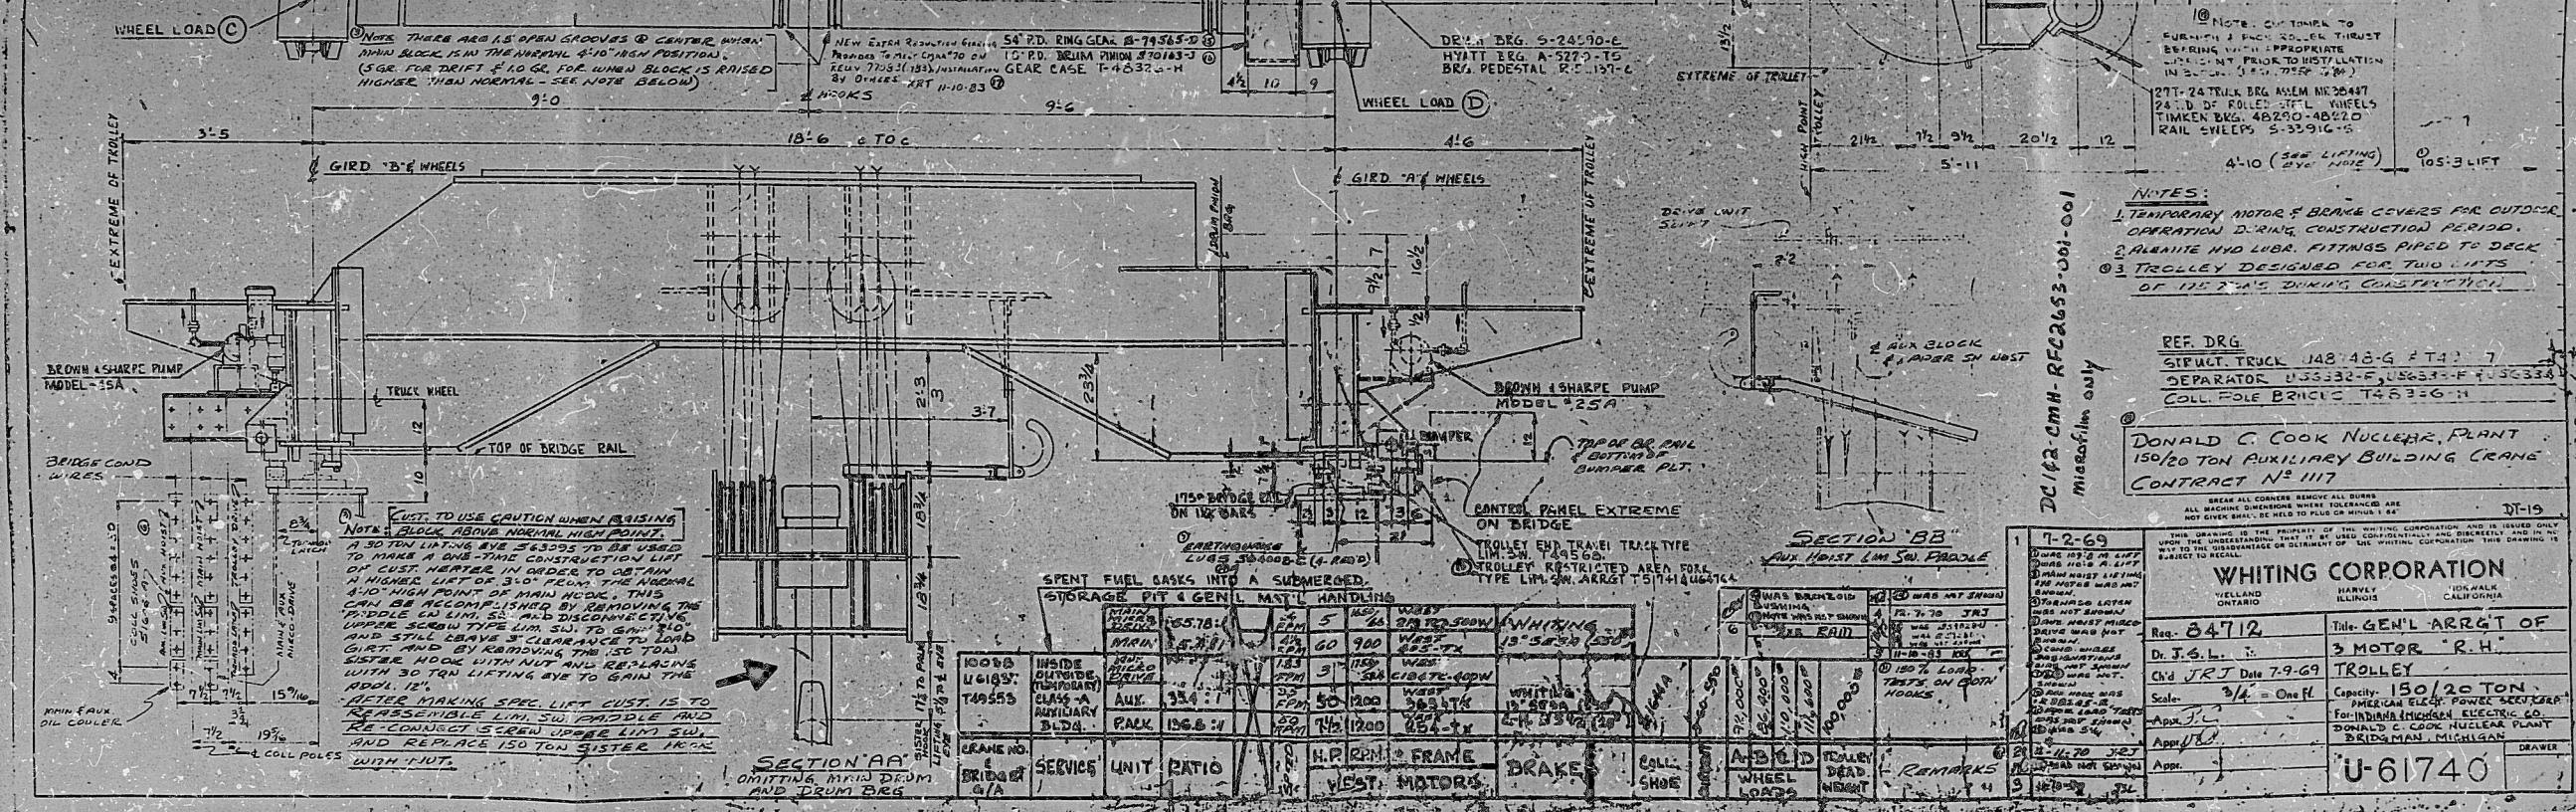


U-61740-1

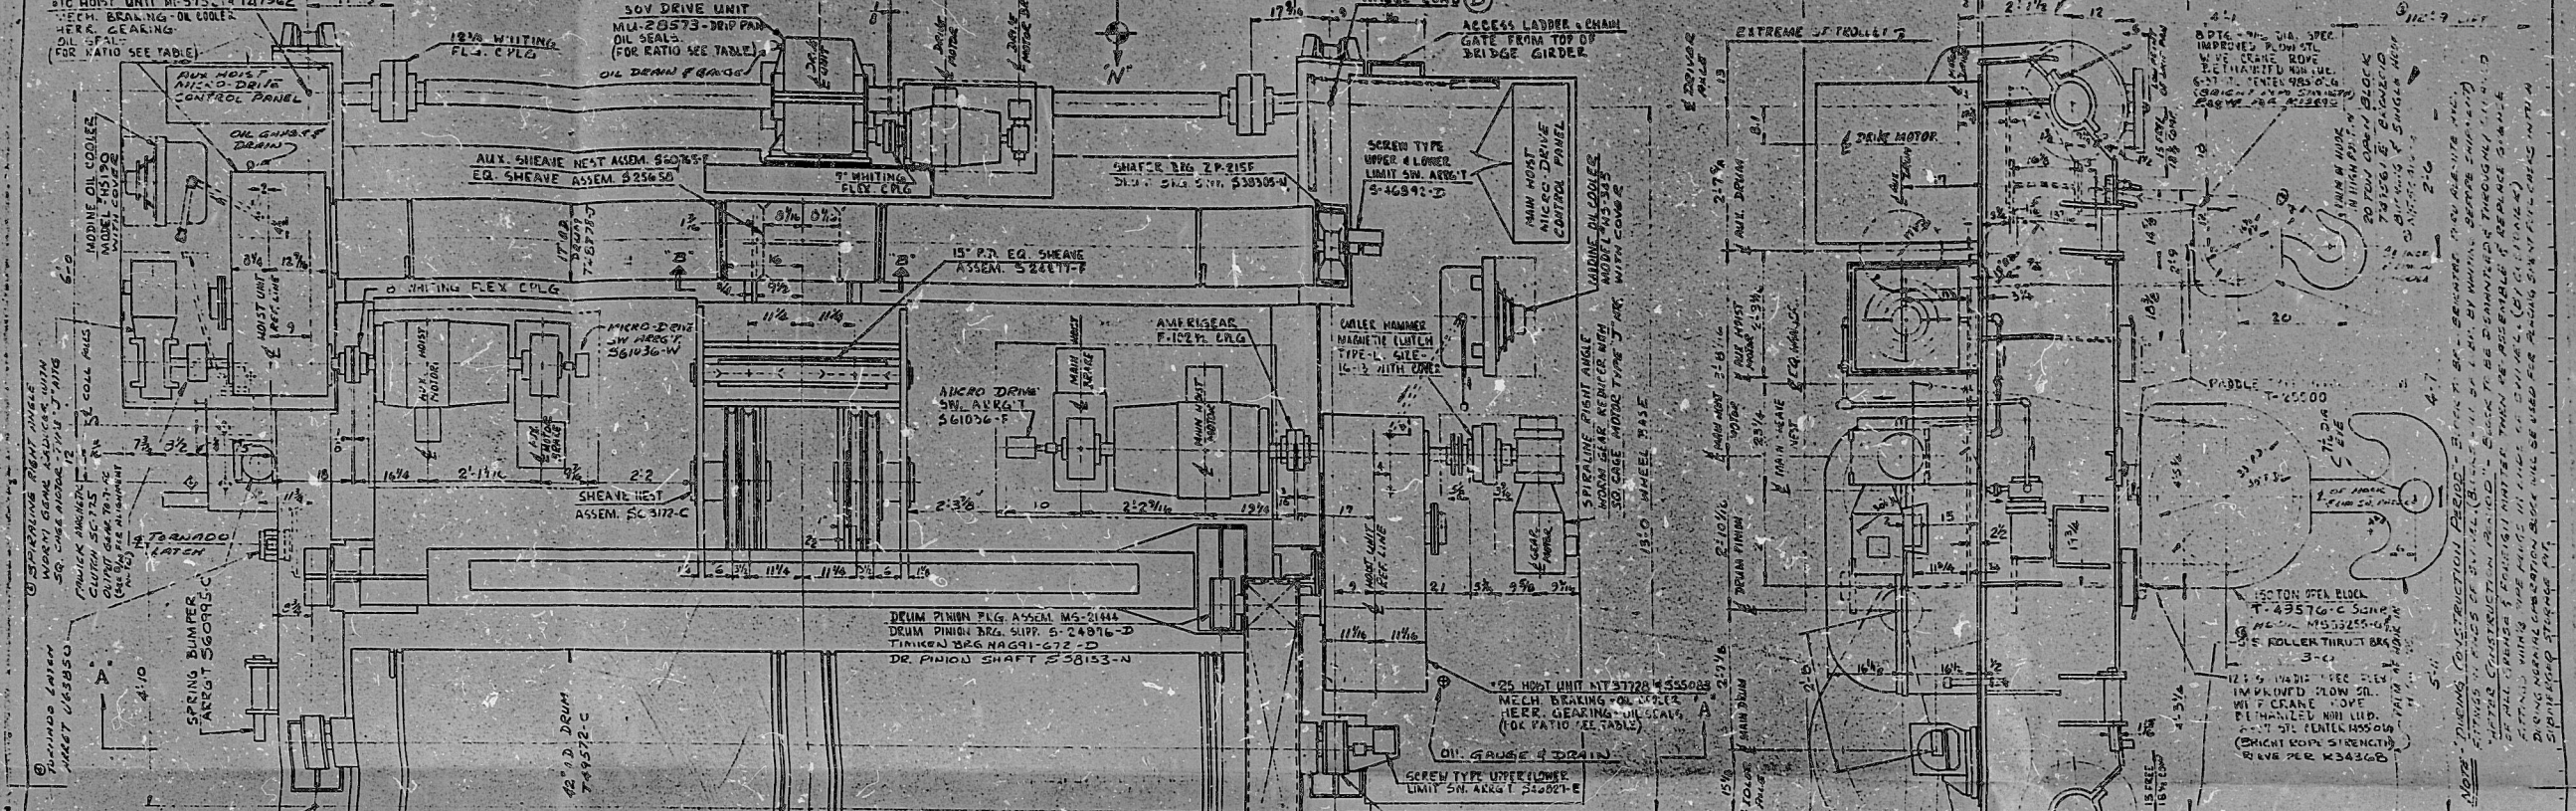

**NOTES:**  

REF. DRG.  
 SEPARATOR U-35330-F, U-35331-F, U-35332-F  
 COLL. FOLE BRACKETS T-4630-G-H

DONALD C. COOK NUCLEAR PLANT  
 150/20 TON AUXILIARY BUILDING CRANE  
 CONTRACT N° 1117

CRANE NO.	SERVICE	UNIT	RATIO	H.P. OR H.P. FRAME	VEST. MOTORS	BRACKETS	COLL. SHOES	A-B-L-D WHEEL LOADS	TROLLEY WEAR HEIGHT	REMARKS
10005	INSIDE									
U-6193	INSIDE									
T-4955	INSIDE									
	AUX.									
	PACK									

TI  
 APERTURE  
 CARD

8509190071

PDR RIDS

8509190071

