


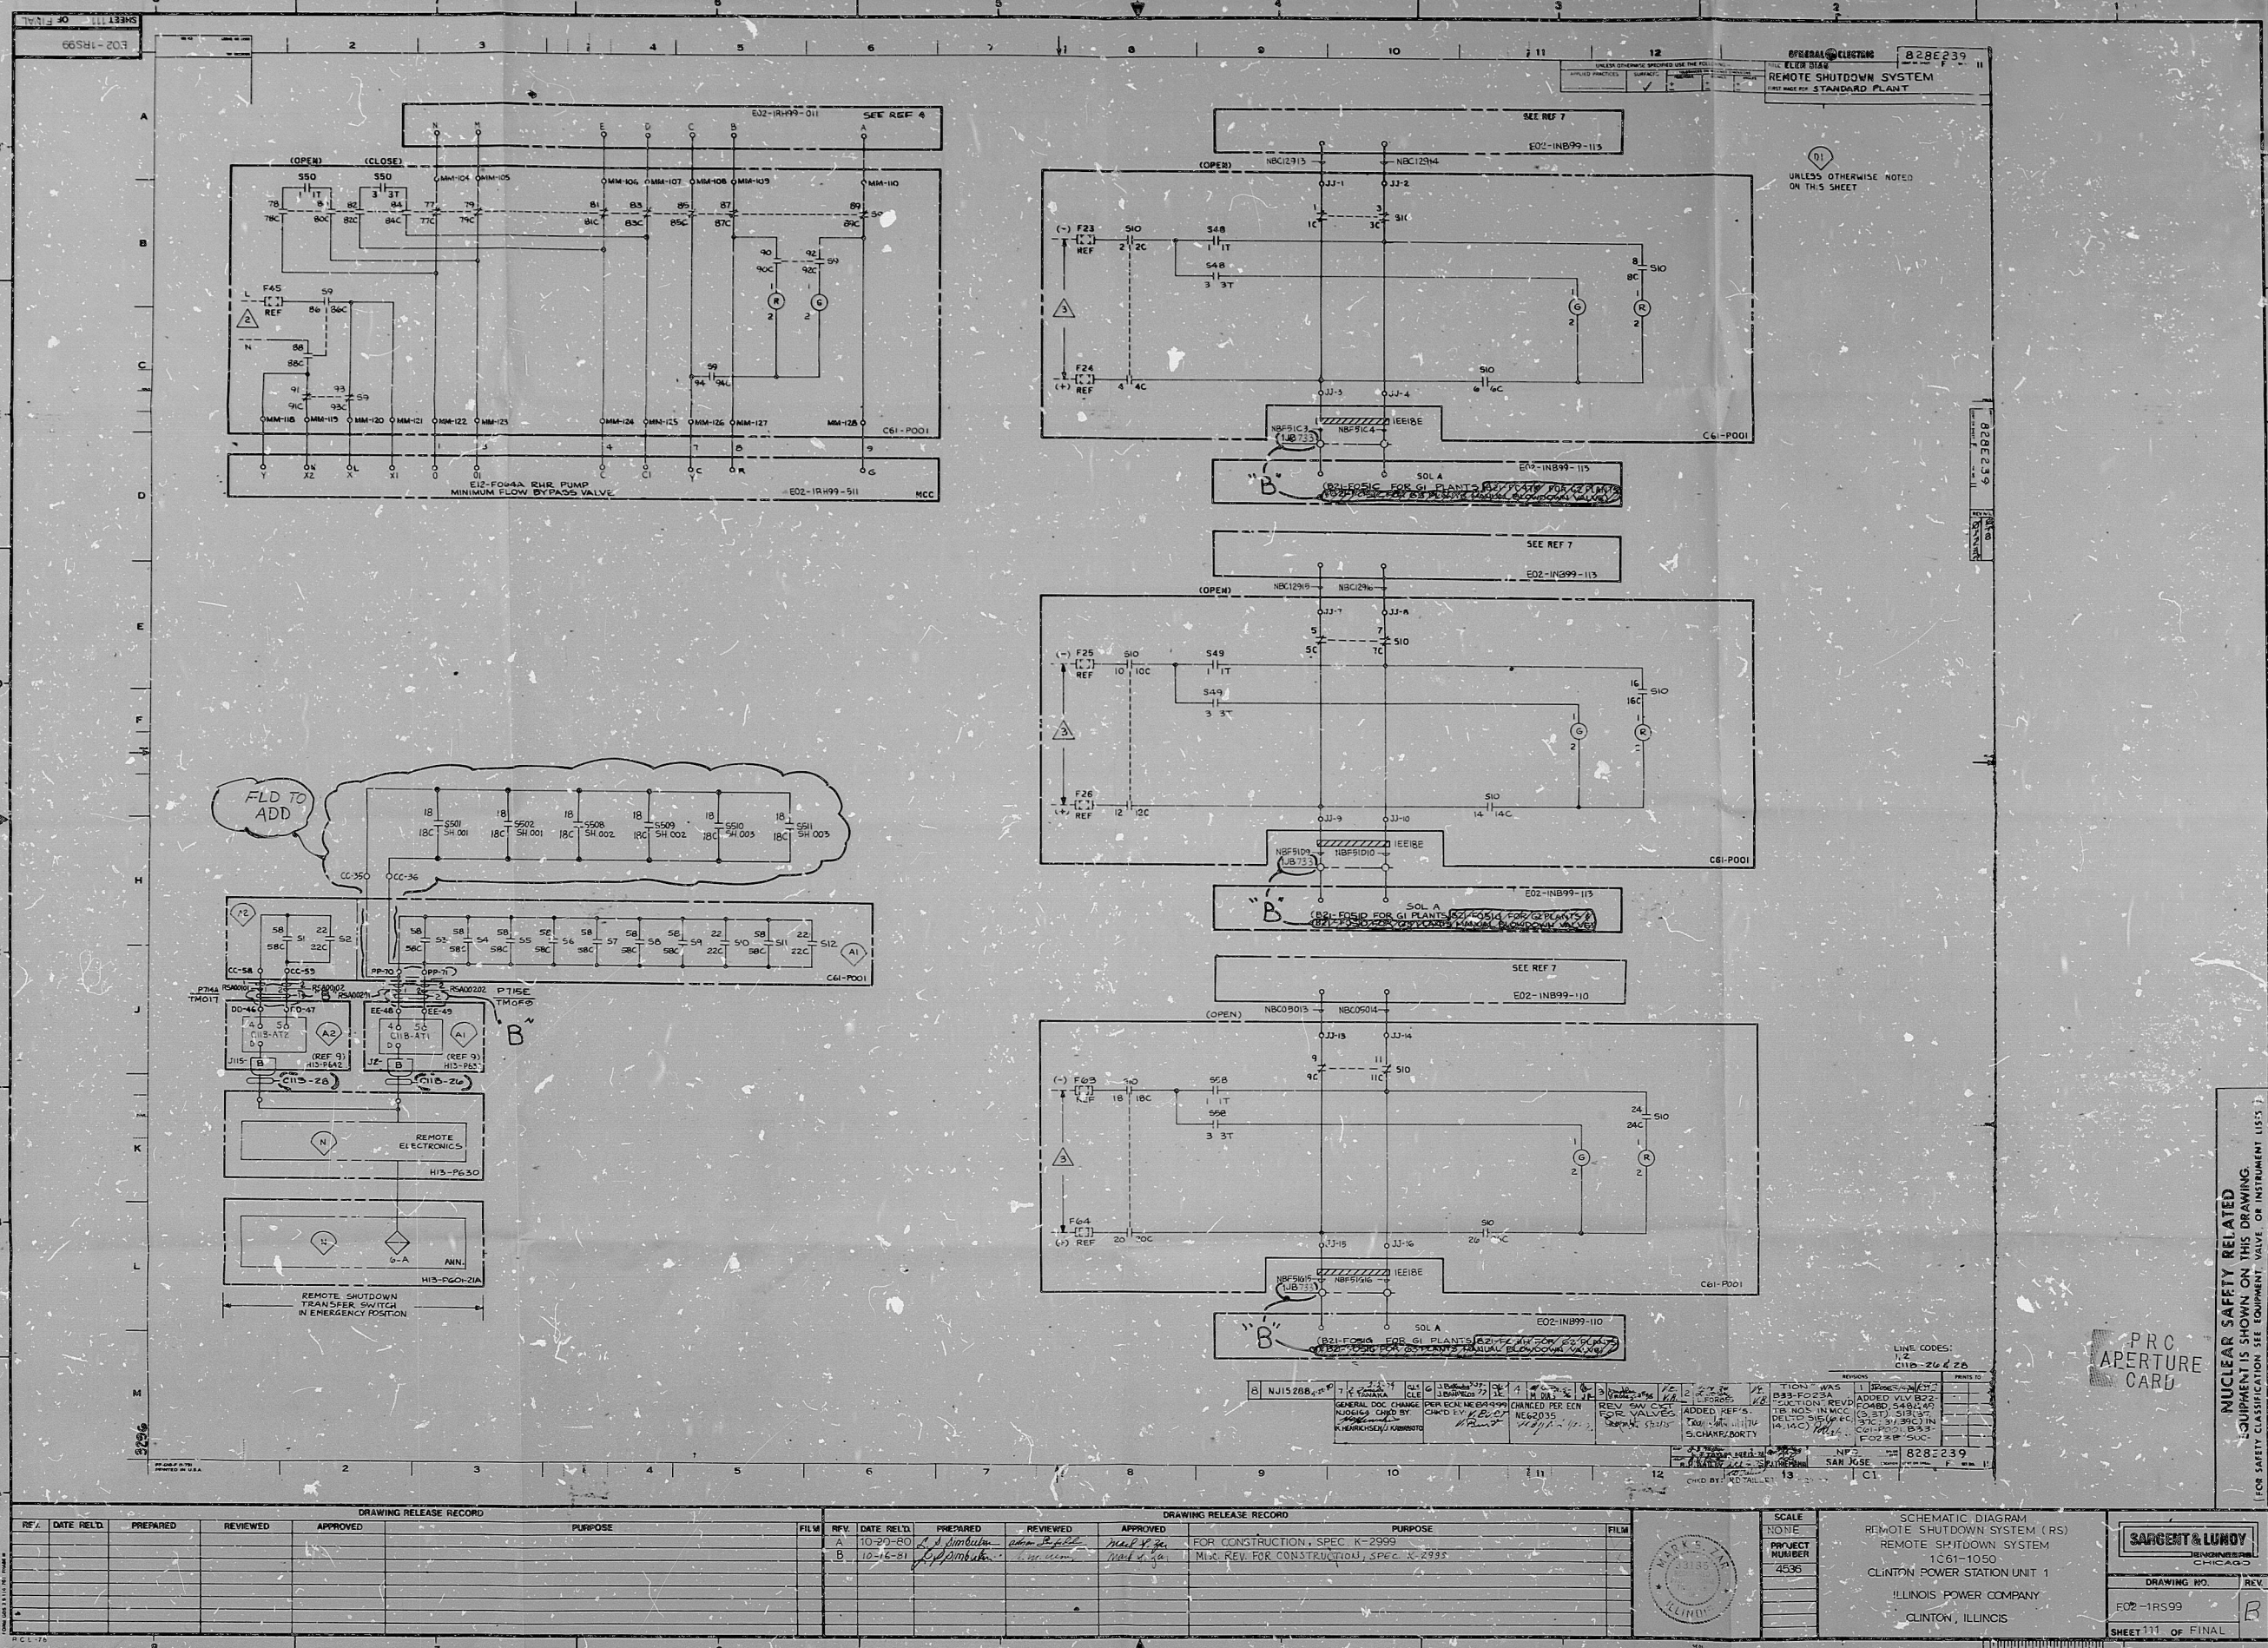

DRAWING RELEASE RECORD						DRAWING RELEASE RECORD					
REV.	DATE	RELD.	PREPARED	REVIEWED	APPROVED	PURPOSE	REV.	DATE	RELD.	PREPARED	REVIEWED

SCALE	NOTE	PROJECT NUMBER	4536
SCHEMATIC DIAGRAM REMOTE SHUTDOWN SYSTEM (RS) REMOTE SHUTDOWN SYSTEM 1061-1050 CLINTON POWER STATION UNIT 1 ILLINOIS POWER COMPANY CLINTON, ILLINOIS			
DRAWING NO. REV E02-1RS99 B			
SHEET 111 OF FINAL			

RIDS

8210120163

