


34

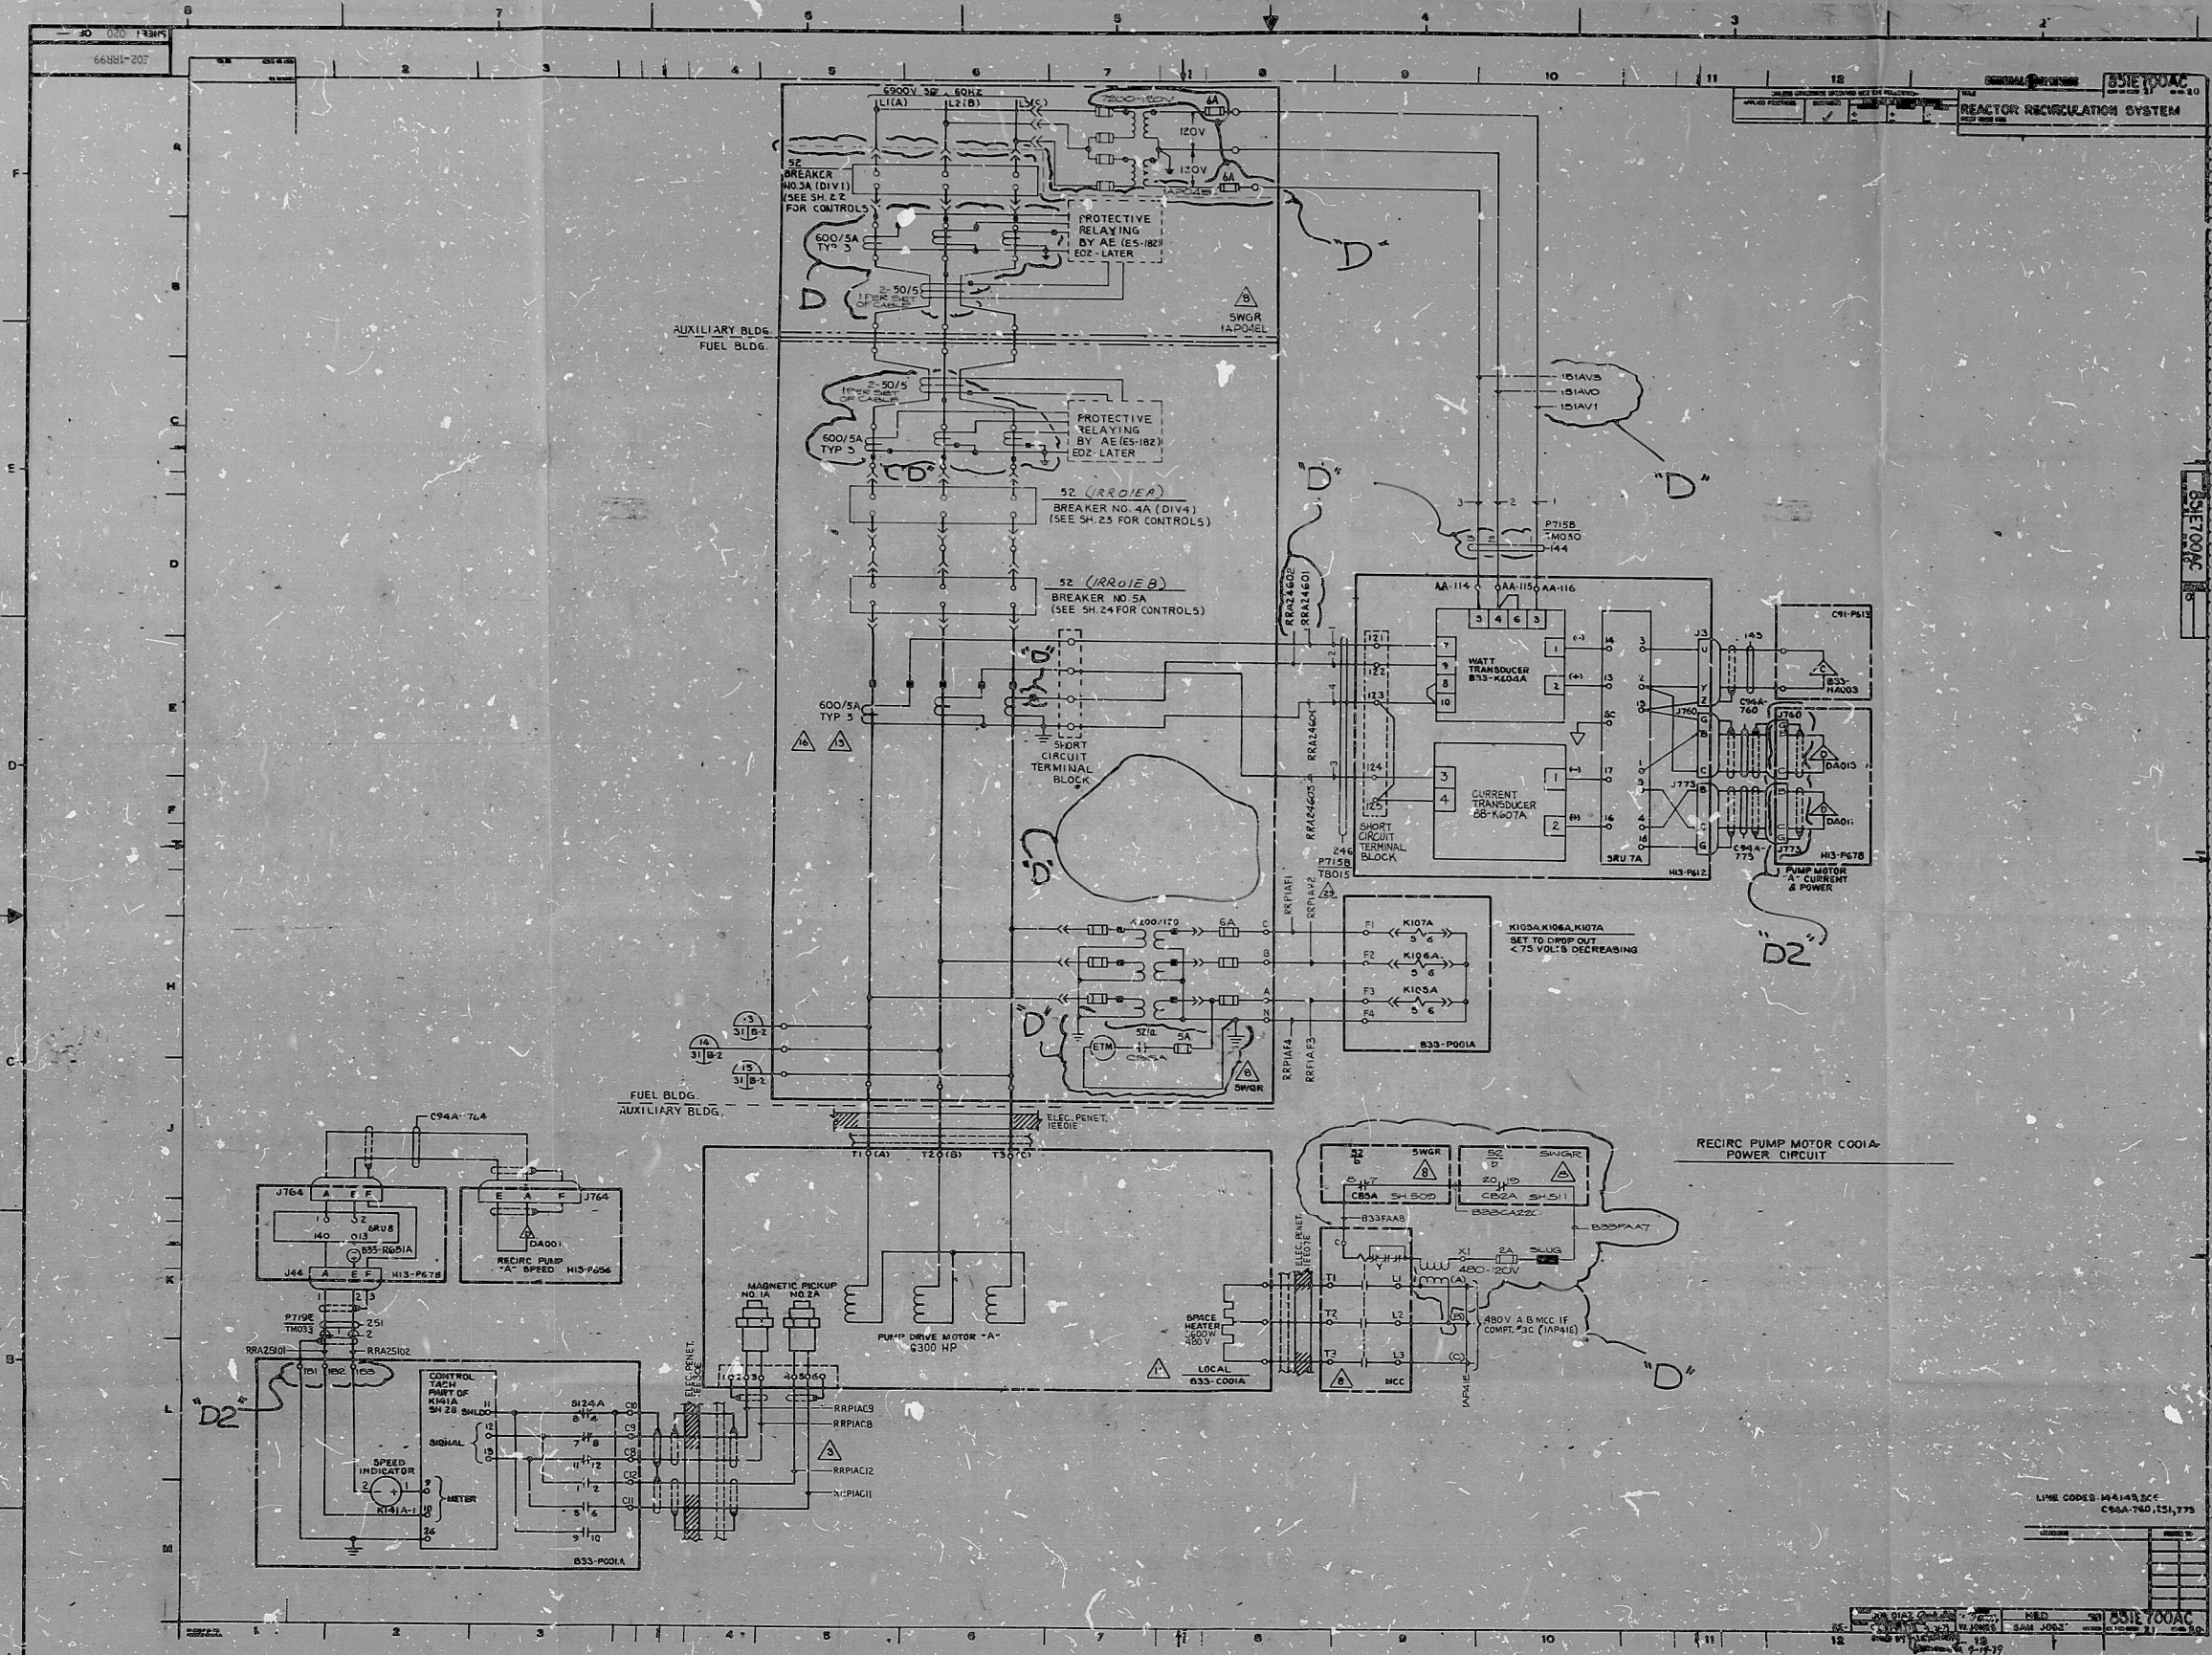


22"
17"
11"
8.5"
11"
8.5"
17"
22"

PRC
APERTURE
CARD

NUCLEAR SAFETY RELATED
EQUIPMENT IS SHOWN OR IN DASHES
(FOR SAFETY CLASSIFICATION SEE APPROPRIATE PART OF INSTANTANEOUS IUT)

DRAWING RELEASE RECORD					DRAWING RELEASE RECORD				
DATE REL.	PREPARED	REVIEWED	APPROVED	PURPOSE	FILE	DATE REL.	PREPARED	REVIEWED	APPROVED

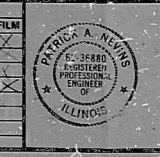

SCALE
PROJECT NUMBER
4536

SCHEMATIC DIAGRAM
REACTOR RECIRCULATION SYSTEM (RR)
REACTOR RECIRCULATION SYSTEM
(1893-1030)
CLINTON POWER STATION UNIT 1
ILLINOIS POWER COMPANY
CLINTON, ILLINOIS

DRAWING NO. REV
E02-18999 D
SHEET 020 OF

RIDS

8210120221

