


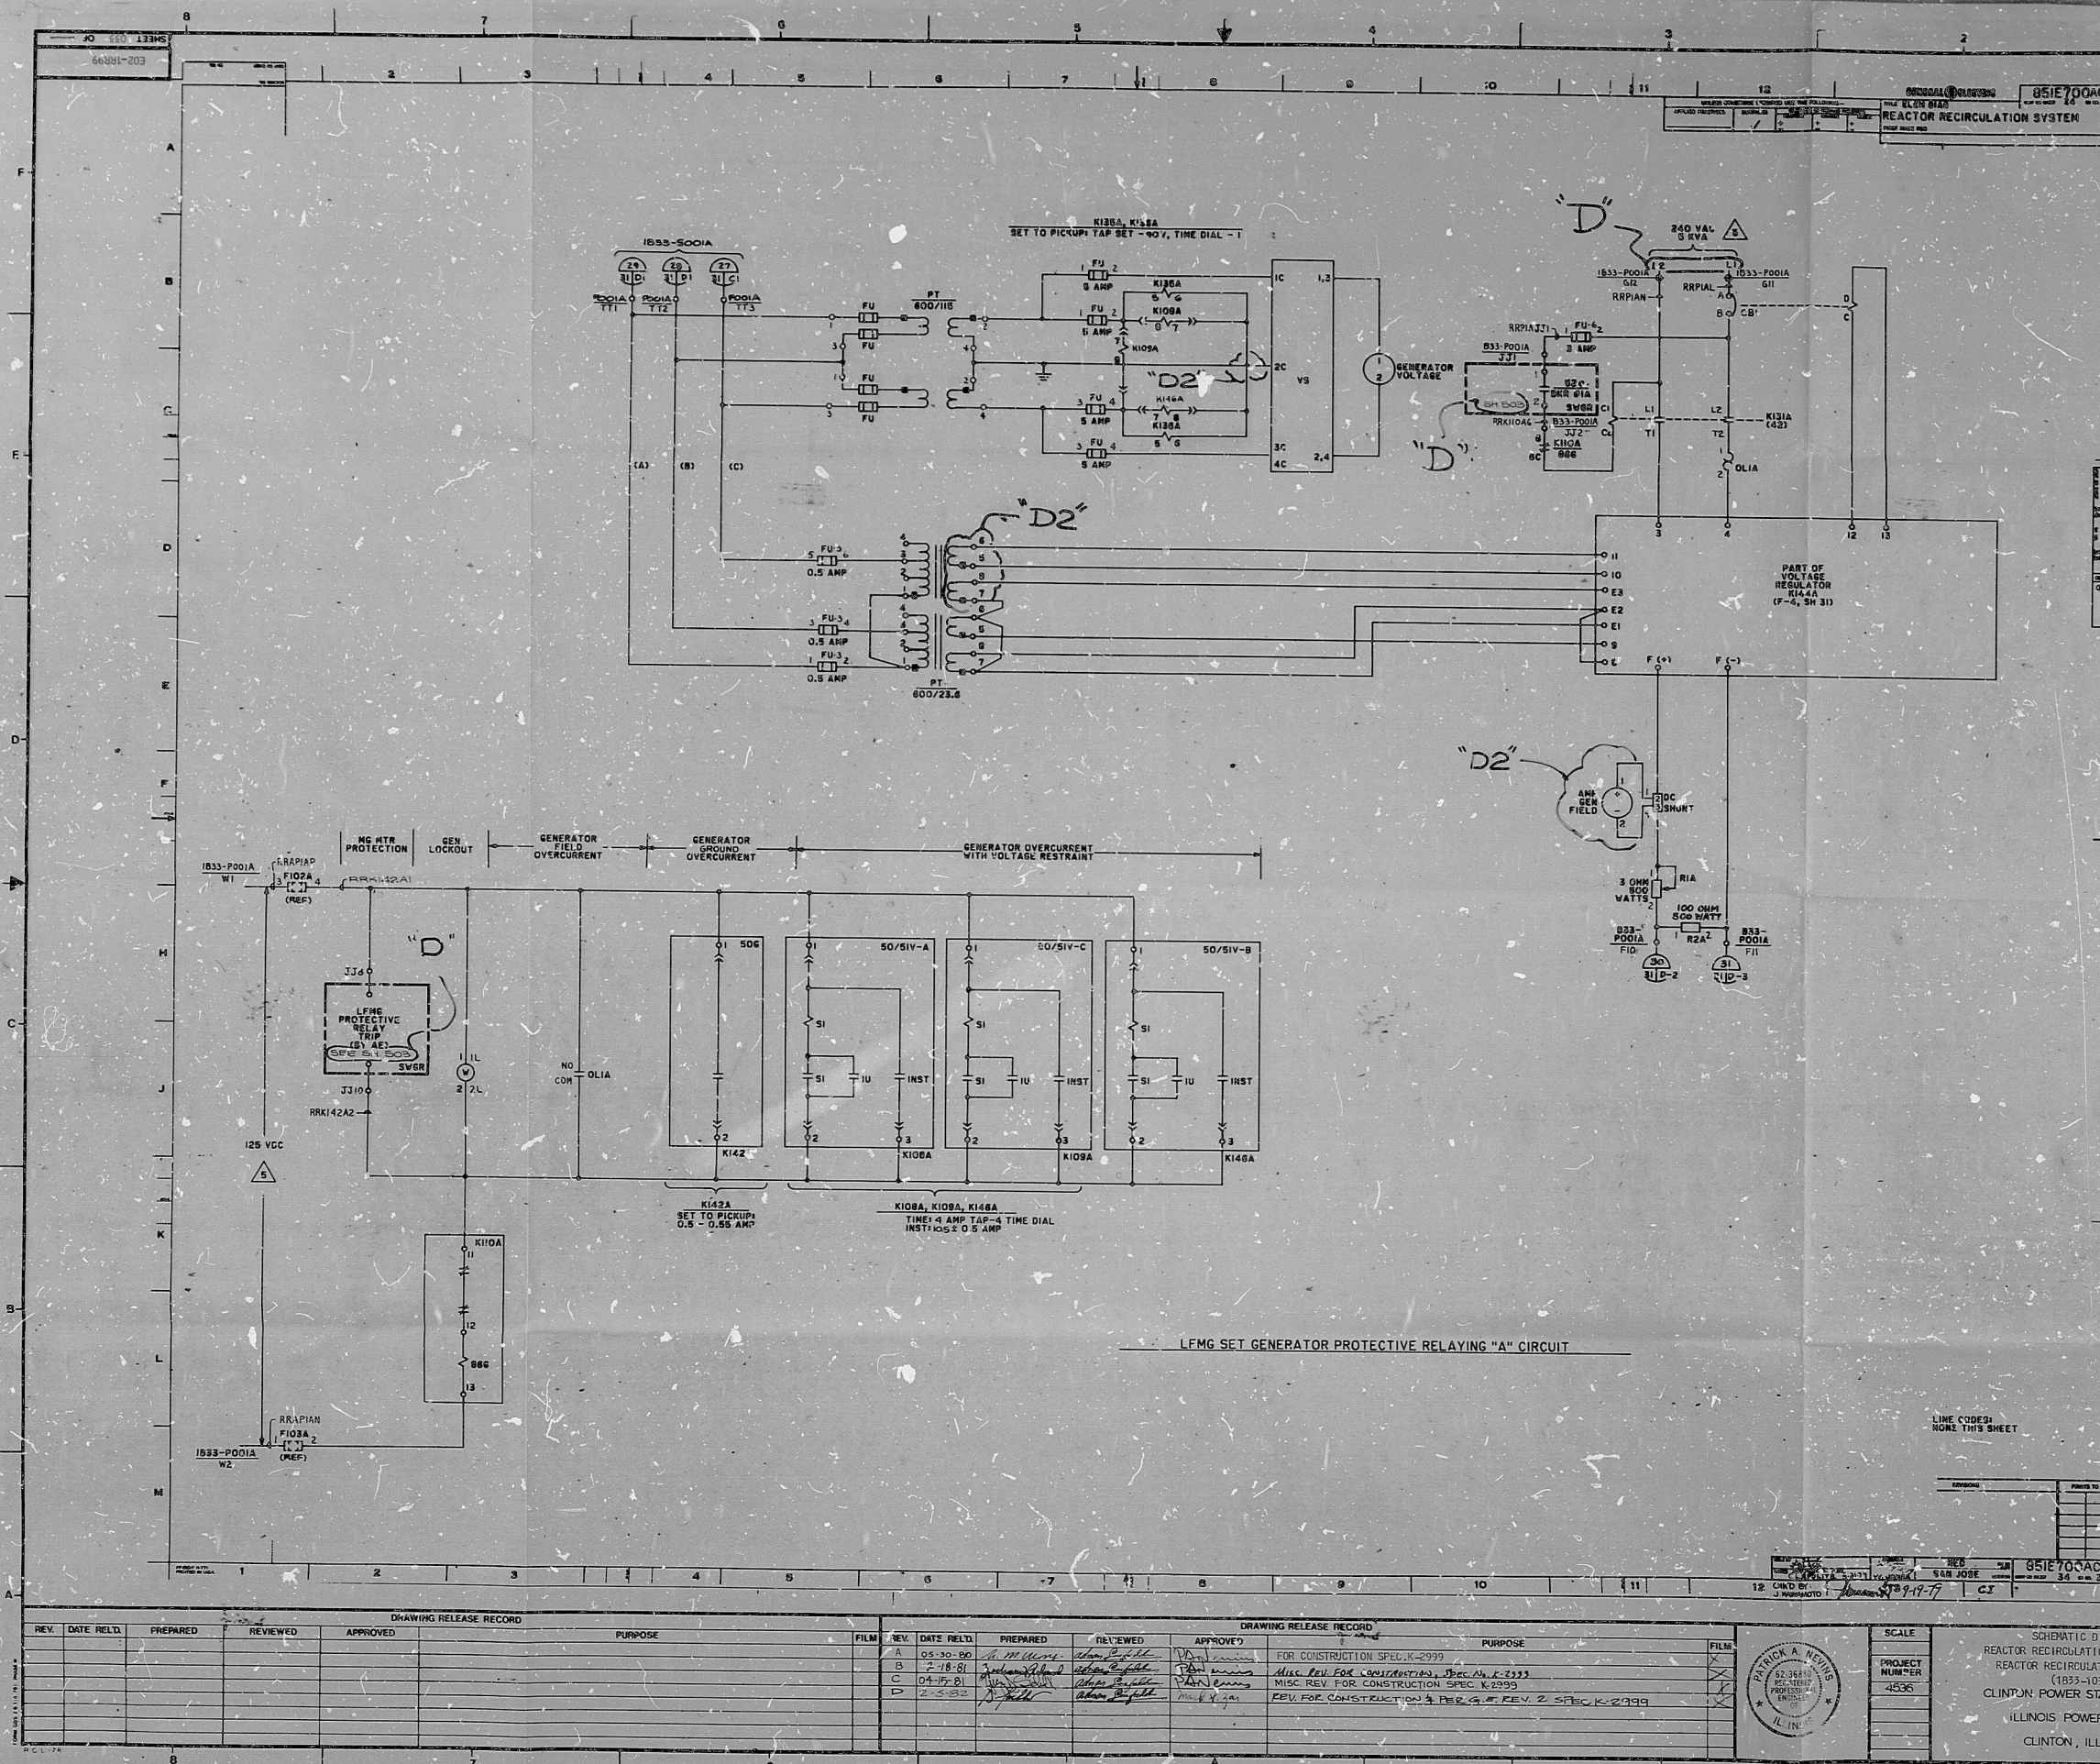

PRC
APERTURE
CARD

SARGENT & LUNDY

DRAFTING NO.

E02-1RR99

SHEET 033 OF —

RIDS

8210120257

