


E-0219-0 SH 6
OF 6 Q

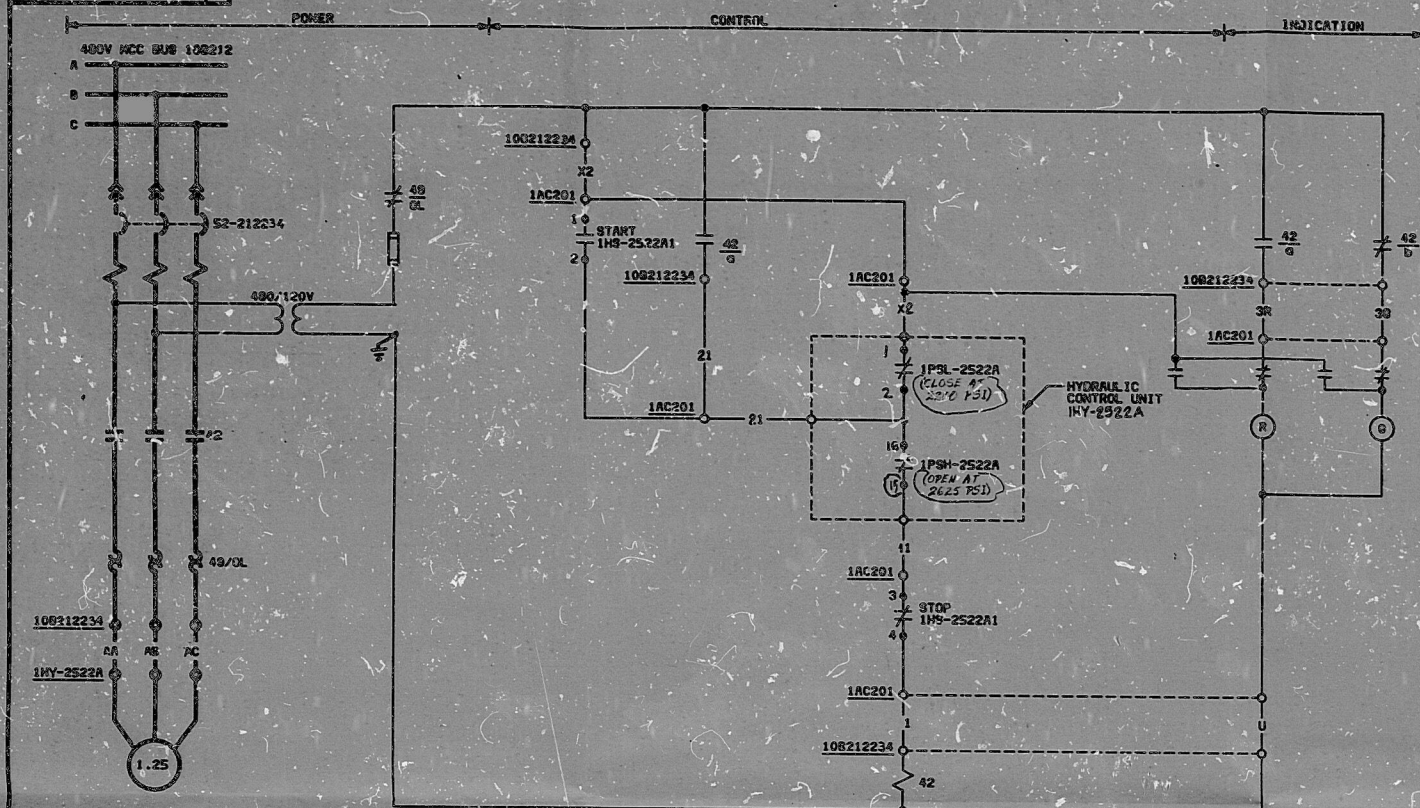


HYDRAULIC OPERATED VALVE HYDRAULIC FLUID PUMP

SCHEME NO. 1C0306 S/U EQ

CLASS 1E - CHANNEL A

SCHEME NO.	VALVE	HYD FLUID PUMP FOR	HAND SWITCH	REMOTE CONTROL PANEL	PRESSURE SWITCHES	CLASS 1E CHANNEL	MCC

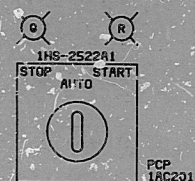

CONTACTS	STOP	AUTO	START
1-2			X
3-4		X	X

MOMENTARY SPRING RETURN TO CENTER MICROSWITCH TYPE PT

- REFERENCE DRAWINGS:
1. LOGIC DIAGRAM 10055-J-11-0, SH. 32
 2. 480V AC MCC TABULATION 10055 E-001, SHS. 2, 3, 4 & 5
 3. VENDOR DWG 10055-P305(1)-279, 280
 4. COMSIP INC. V.P. : DWG. 10055-J201(1)-5(4)(10) & J201(1)-1(1)(2)

TI
APERTURE
CARD


NO.	DATE	REVISIONS	BY	CHKD	DESIGN	ENGR	APPR
1		DESIGNED	NF				
2		DRAWN	AGD				

BECKTEL
SAN FRANCISCO

PUBLIC SERVICE ELECTRIC AND GAS COMPANY
HOPE CREEK GENERATING STATION

ELECTRICAL SCHEMATIC DIAGRAM
HYDRO OPERATED VLV HYDRO FLUID PUMP

JOB No.	DRAWING No.	REV.
10055	E-0219-0 SH 6 OF 6	4 Q

PDR RIDS

8500040062

