

34"

22"

17"

11"

8.5"


8.5"

11"

17"

22"

34"

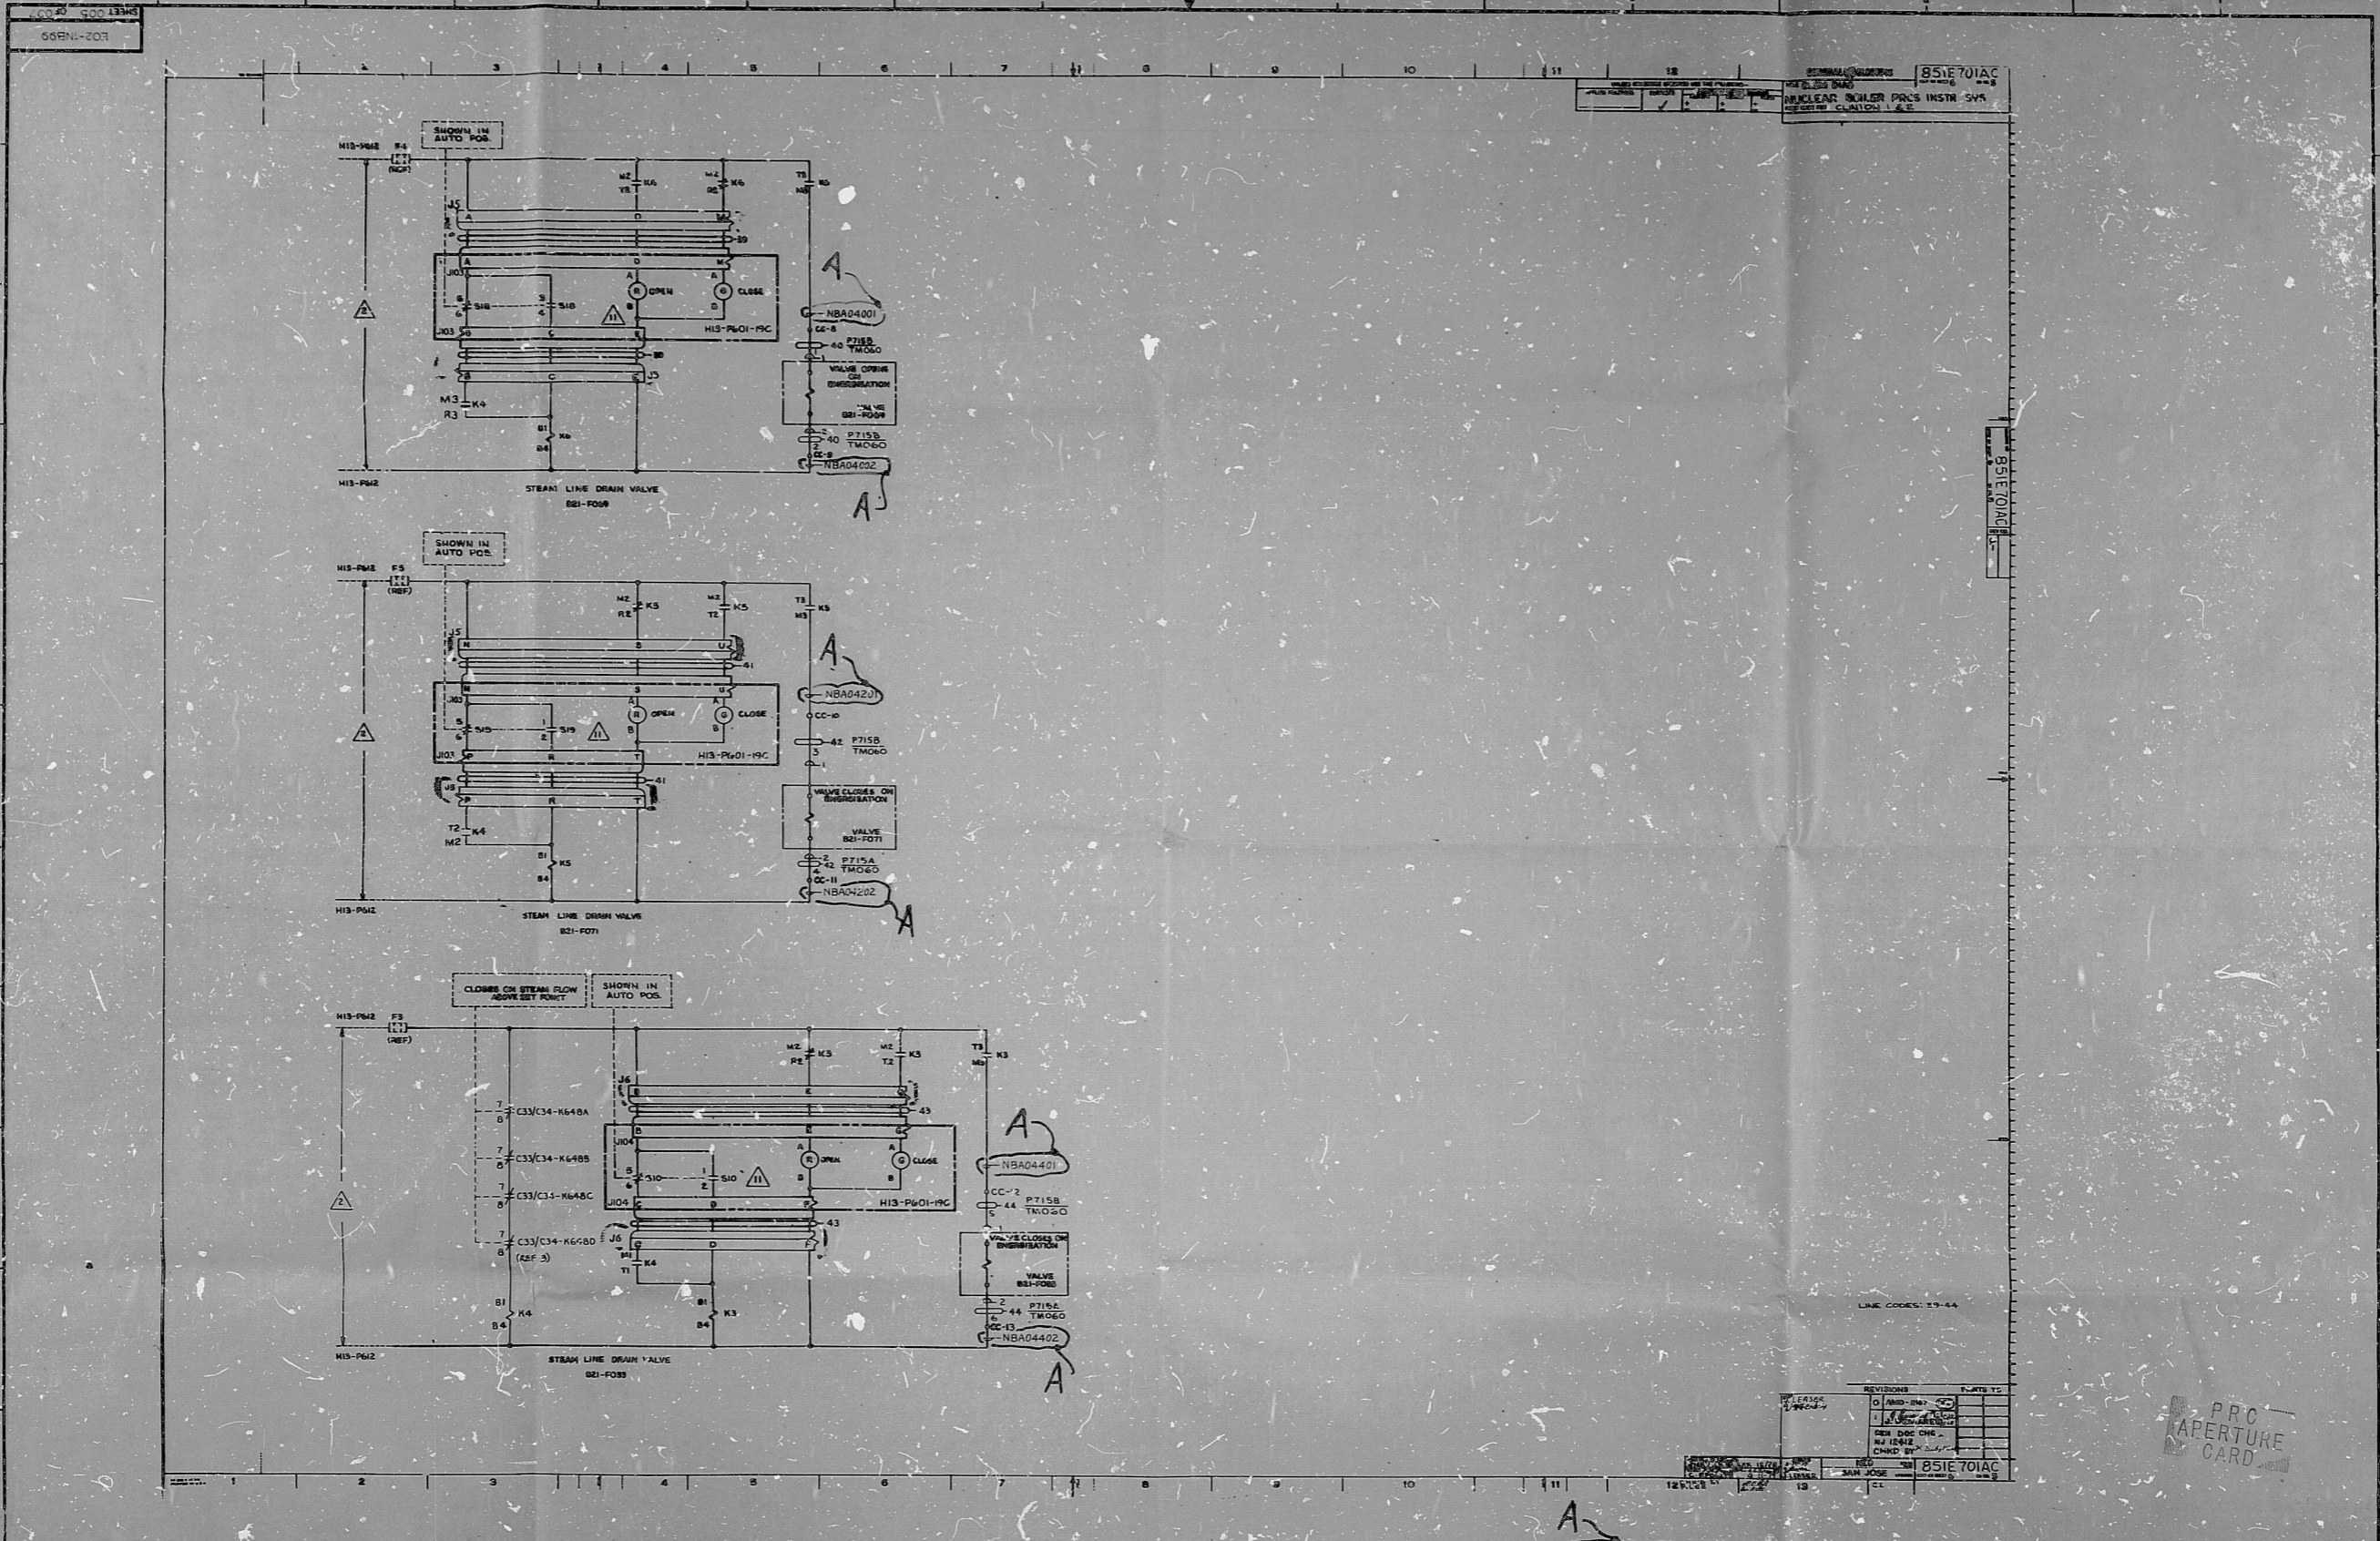

NO.	DATE	BY	DESCRIPTION
1	11/15/69	W. J.
2	11/15/69	W. J.
PRO APERTURE CARD

DRAWING RELEASE RECORD				DRAWING RELEASE RECORD				SCALE		PROJECT NUMBER		DRAWING NO.	
REV.	DATE RELD.	PREPARED	APPROVED	REV.	DATE RELD.	PREPARED	APPROVED	SCALE	PROJECT NUMBER	DRAWING NO.	REV.	DRAWING NO.	REV.
A	2-28-80	R. N.	A	2-28-80	R. N.	SCALE	PROJECT NUMBER	DRAWING NO.	REV.	DRAWING NO.	REV.



SCHEMATIC DIAGRAM
 NUCLEAR BOILER SYSTEM (NB)
 NUCLEAR BOILER PRESS INSTR SYS
 (1B21-1050)
 CLINTON POWER STATION UNIT 1
 ILLINOIS POWER COMPANY
 CLINTON, ILLINOIS

SARGENT & LUNDY
 CHICAGO

DRAWING NO. REV.
 E02-1NB99 A
 SHEET 005 OF 007

RIDS

8210130031

