


J-31-0 SHEET 6

This drawing and the design it covers are the property of BECHTEL. They are hereby loaned and on the borrower's express agreement that they will not be reproduced, copied, loaned, or used except in the limited way and for the purpose intended by the lender to the borrower.

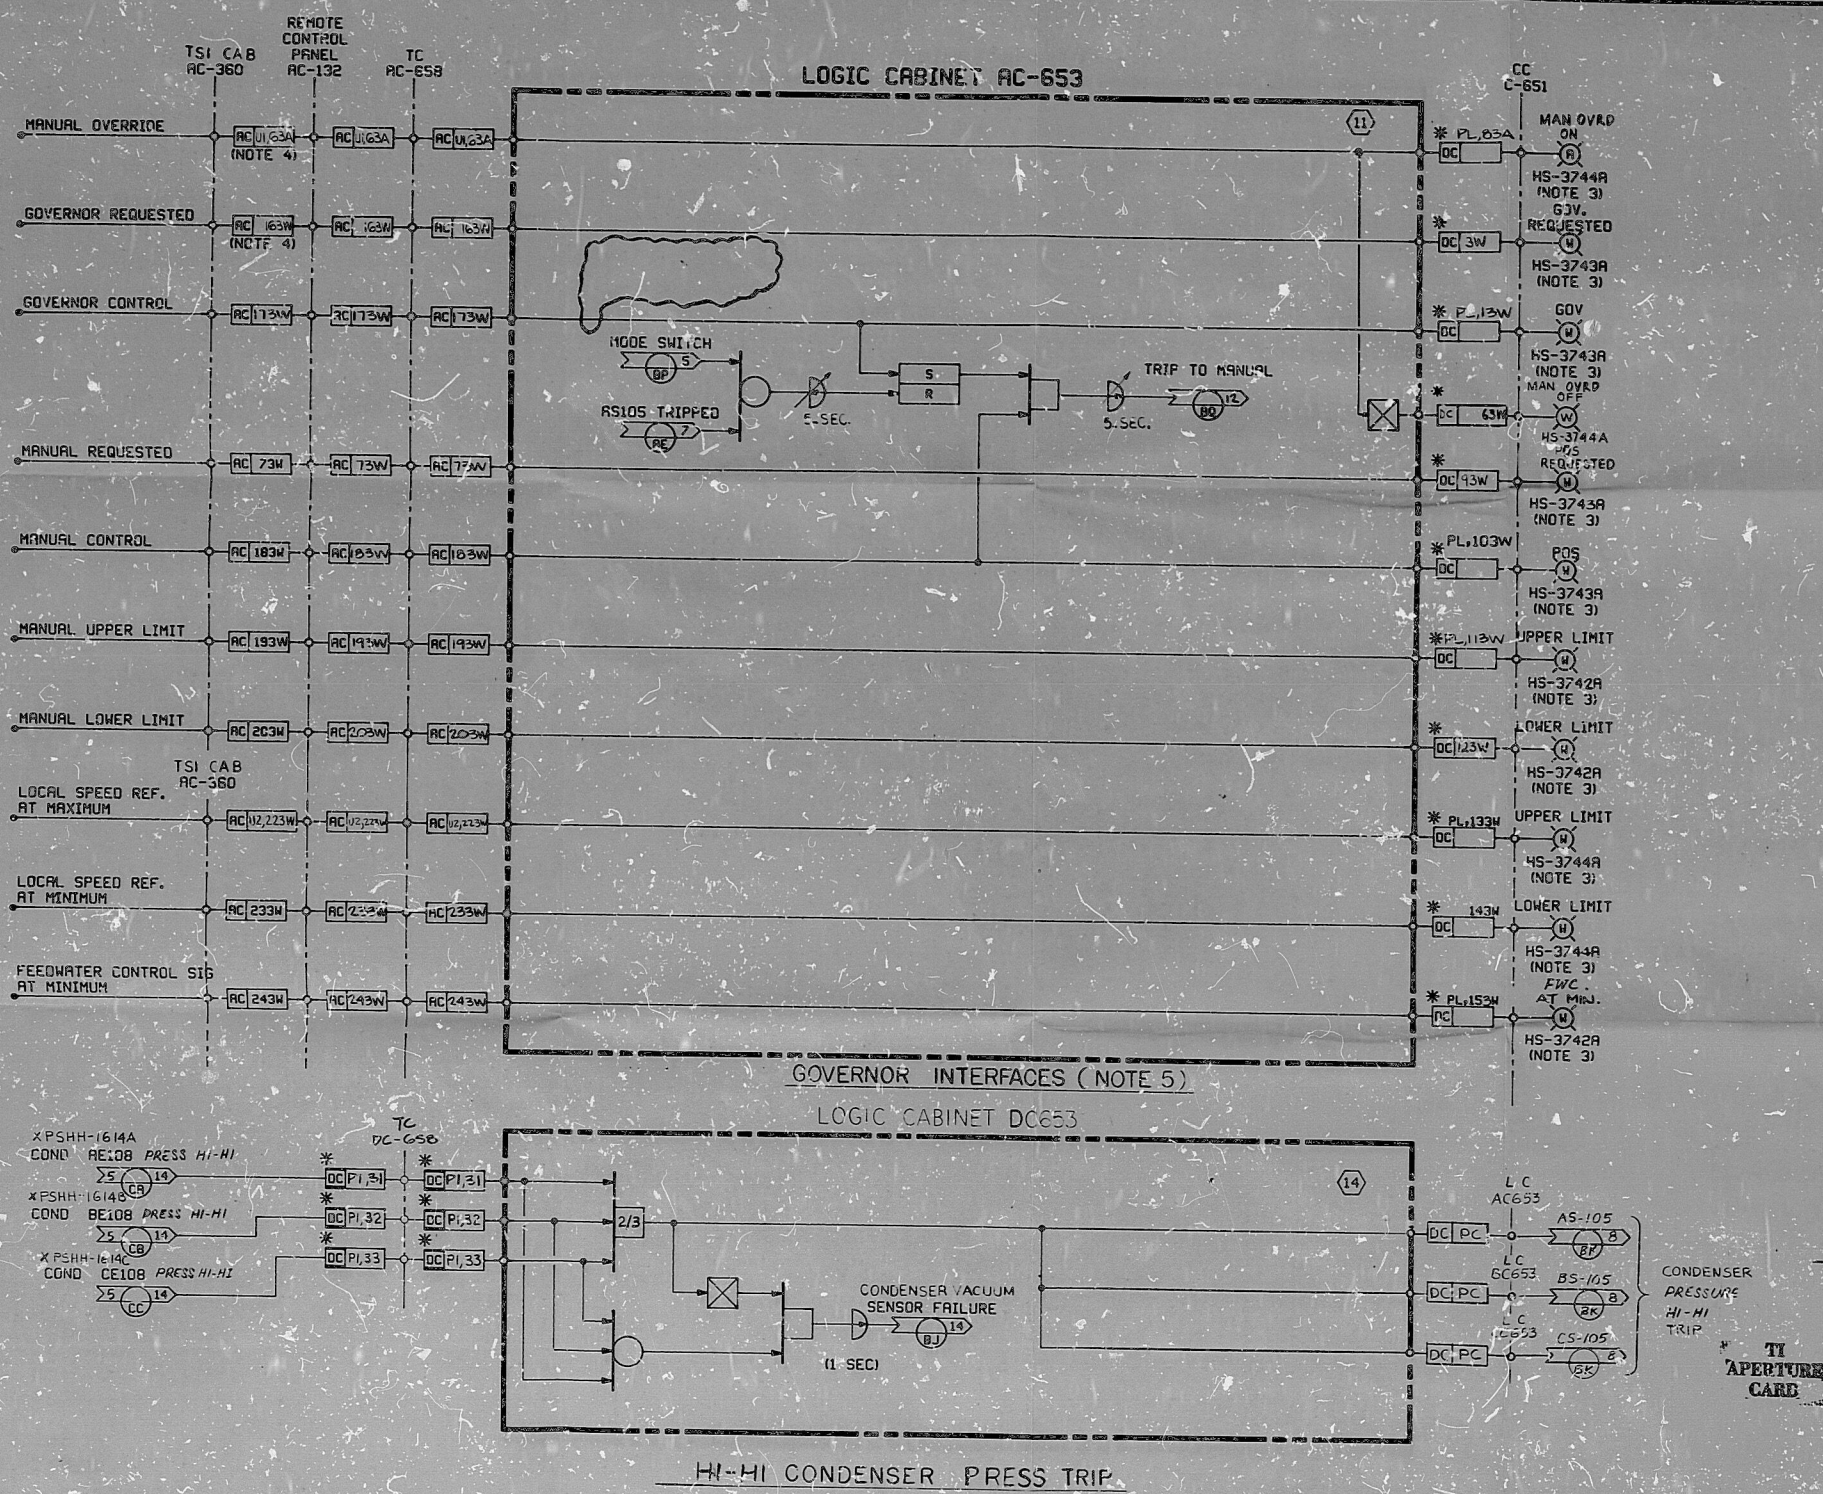

- NOTES:**
1. FOR DETAILS OF LOCAL PANEL HAND SWITCHES AND INDICATING LIGHTS SEE VENDOR PRINT M12-21.
 2. SEE VENDOR PRINT M12-21 FOR DETAILS OF THE REST OF THE GOVERNOR SYSTEM.
 3. SEE SWITCH ON SHEET 5.
 4. POWER USED FOR ALL INPUTS IS UN-INTERRUPTIBLE AC AND IS SUPPLIED FROM THE SOURCE THAT POWERS THE POSITION CONTROLLER. THIS POWER ALSO USED ON SHT. 5, 7, 11.
 5. SEE SHT. 5 FOR CROSS REFERENCE TABLE.
 6. SEE WIRING DIAGRAM (M12-21) FOR TERMINAL ASSIGNMENTS AT THE C-360 PANEL.

NO.	DATE	REVISIONS	BY	CHKD	APPD
1	10/1/73	ADDED WIRE NOS.	WJ	WJ	WJ
2	10/1/73	DESIGN FREEZE ISSUE 3 UNIT 2 CANCELLATION	WJ	WJ	WJ
3	11/1/73	REVISED BAILEY INTERFAC AND AS NOTED	WJ	WJ	WJ
4	11/1/73	REVISED AS NOTED	WJ	WJ	WJ
5	11/1/73	REVISED TO INCORPORATE ID'N #001 OF DCP #99	WJ	WJ	WJ
6	5-11-77	ISSUED FOR CONSTRUCTION	WJ	WJ	WJ

BECHTEL
SAN FRANCISCO

PUBLIC SERVICE ELECTRIC AND GAS COMPANY
HOPE CREEK GENERATING STATION

LOGIC DIAGRAM
GOVERNOR FEED PUMP TURBINE STEAM SYSTEM
GOVERNOR INTERFACES/ HI-COND.PRESSURE TRIP

JCP No.	DRAWING No.	REV.
10855	J-31-0	SHT 6

NO.	DATE	REVISIONS	BY	CHKD	APPD
1	11/1/73	REVISED WIRE MARKERS ON PANEL C-651	WJ	WJ	WJ

S/U - FW

PDR RIDS

8510040612

