


NOTE: CONTACTS (A12-B12)(A6-B6)(C11-D11)(C1-D1)(C5-D5)(C7-D7) WILL BE OPEN WHEN LOCAL REMOTE SWITCH IS IN THE LOCAL POSITION.



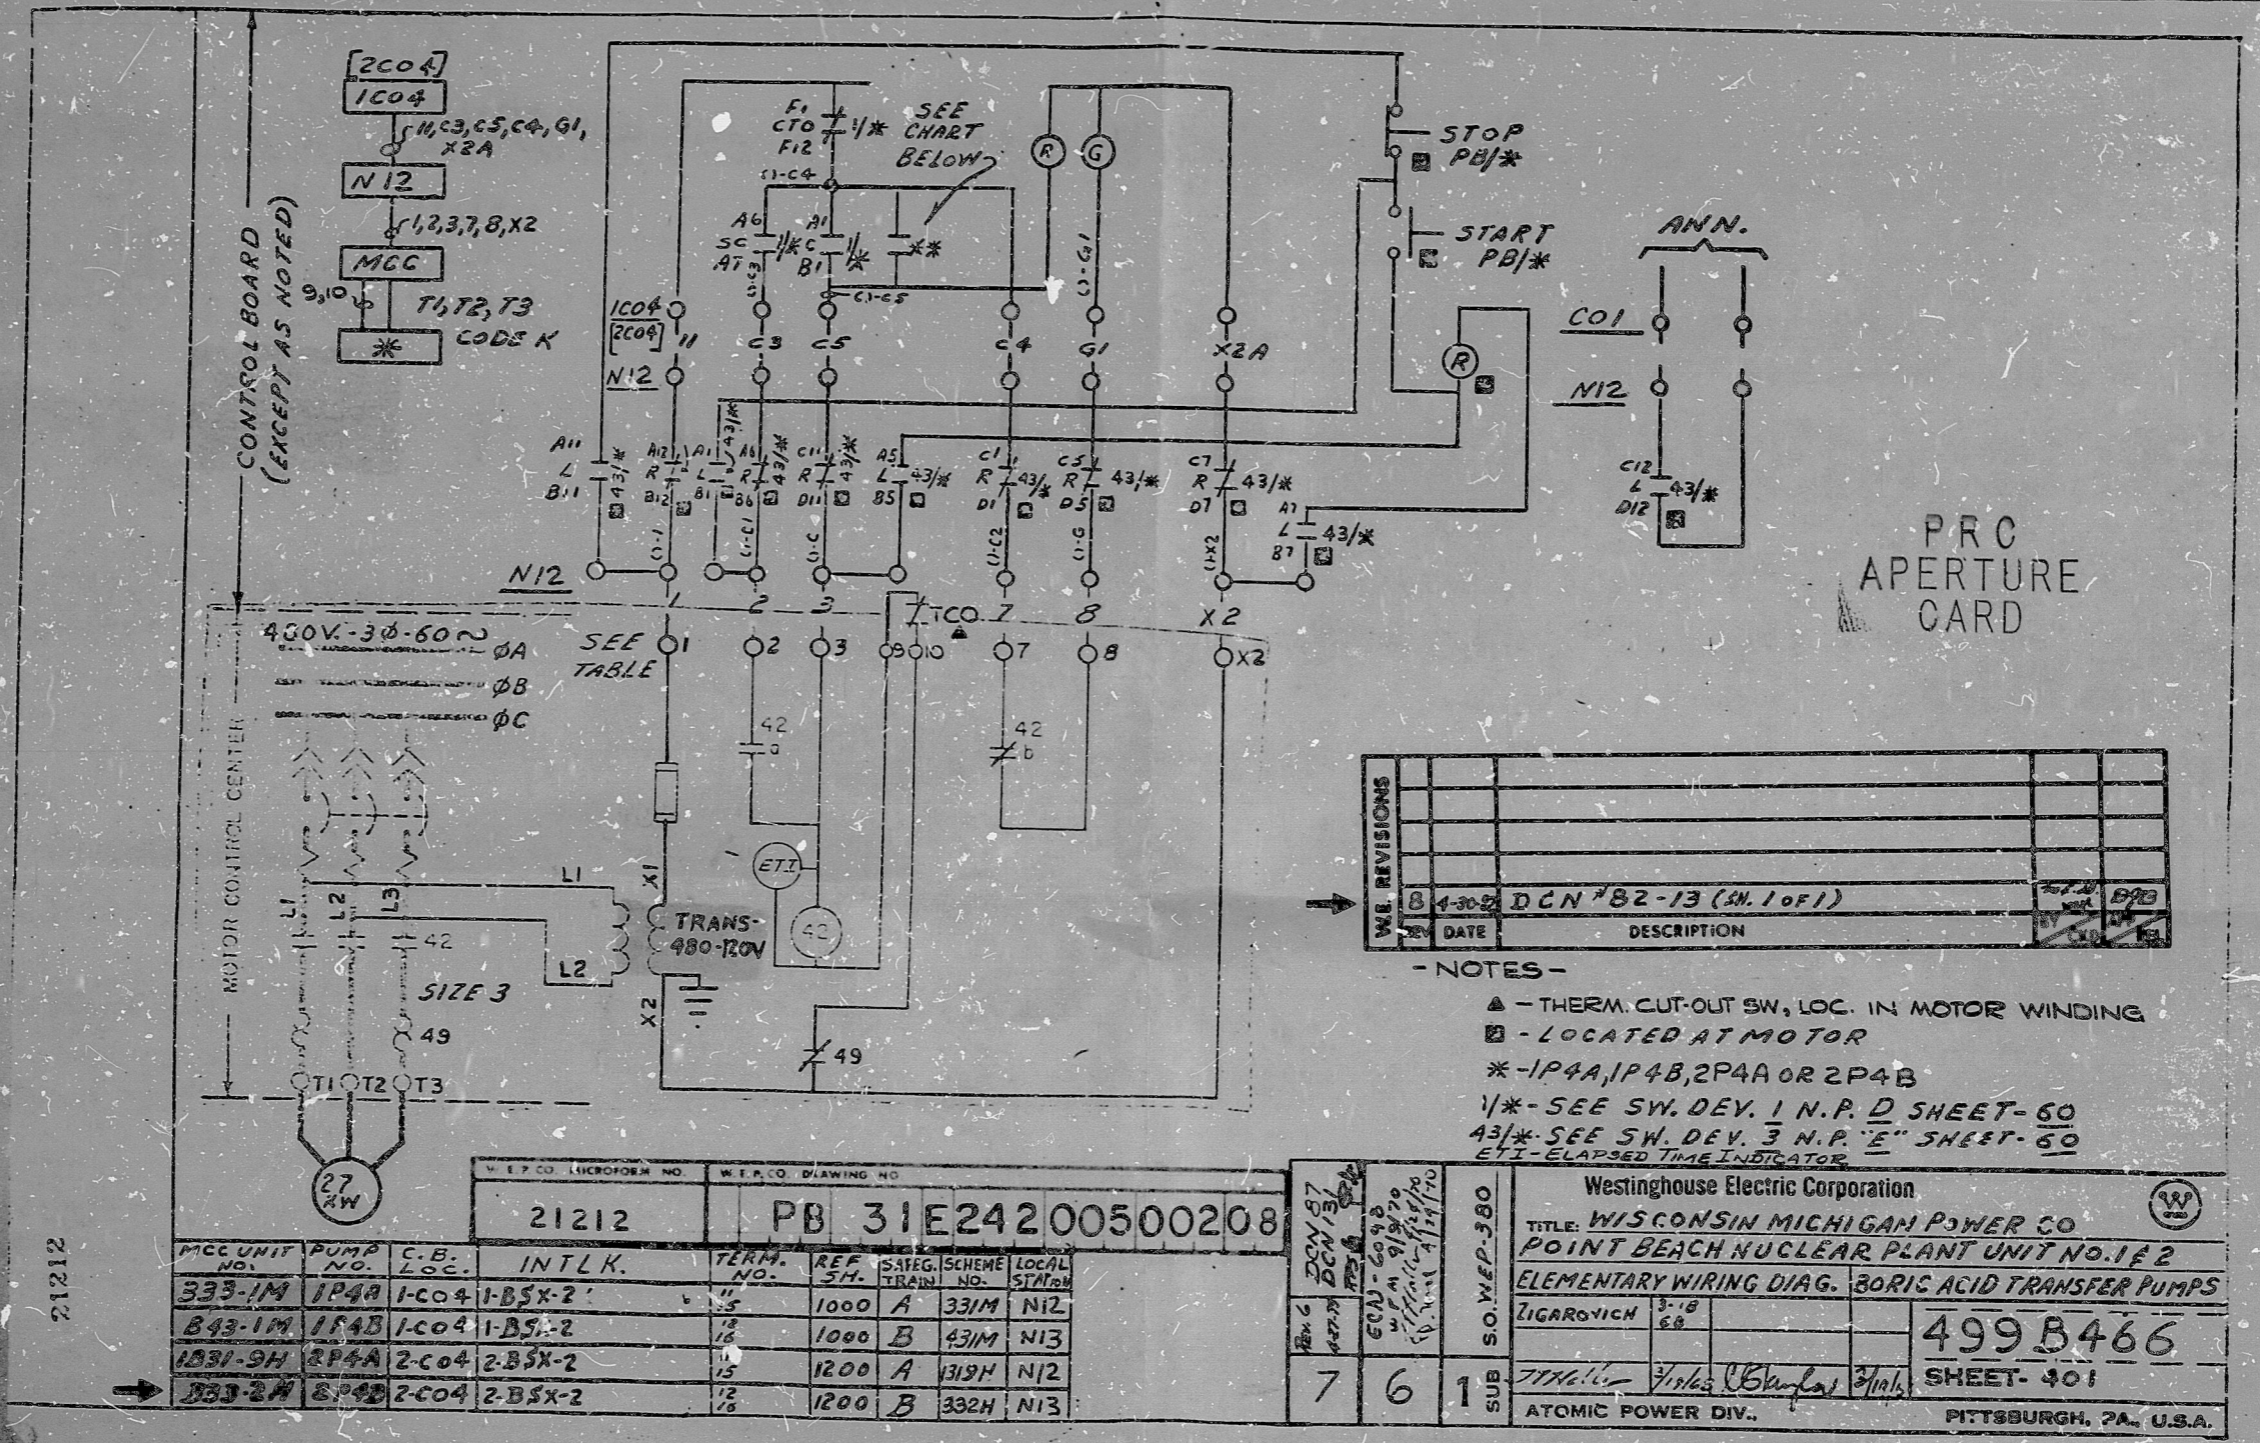

NO.	DATE	DESCRIPTION
8	4-30-82	DCN #82-13 (SH. 1 of 1)

- NOTES -
- ▲ - THERM. CUT-OUT SW, LOC. IN MOTOR WINDING
  - - LOCATED AT MOTOR
  - \* - 1P4A, 1P4B, 2P4A OR 2P4B
  - 1/\* - SEE SW. DEV. 1 N.P. D SHEET-60
  - 43/\* - SEE SW. DEV. 3 N.P. "E" SHEET-60
  - ETI - ELAPSED TIME INDICATOR

MCC UNIT NO.	PUMP NO.	C.B. LOC.	INTLK.	TERM. NO.	REF. SH.	SAFEG. TRAIL	SCHEME NO.	LOCAL STATION

Westinghouse Electric Corporation

TITLE: WISCONSIN MICHIGAN POWER CO  
 POINT BEACH NUCLEAR PLANT UNIT NO. 1 & 2  
 ELEMENTARY WIRING DIAG. BORIC ACID TRANSFER PUMPS

499B466

SHEET-401

PITTSBURGH, PA, U.S.A.

13 JUNE 1982

21212

8130910918

PIDS

8210190818

