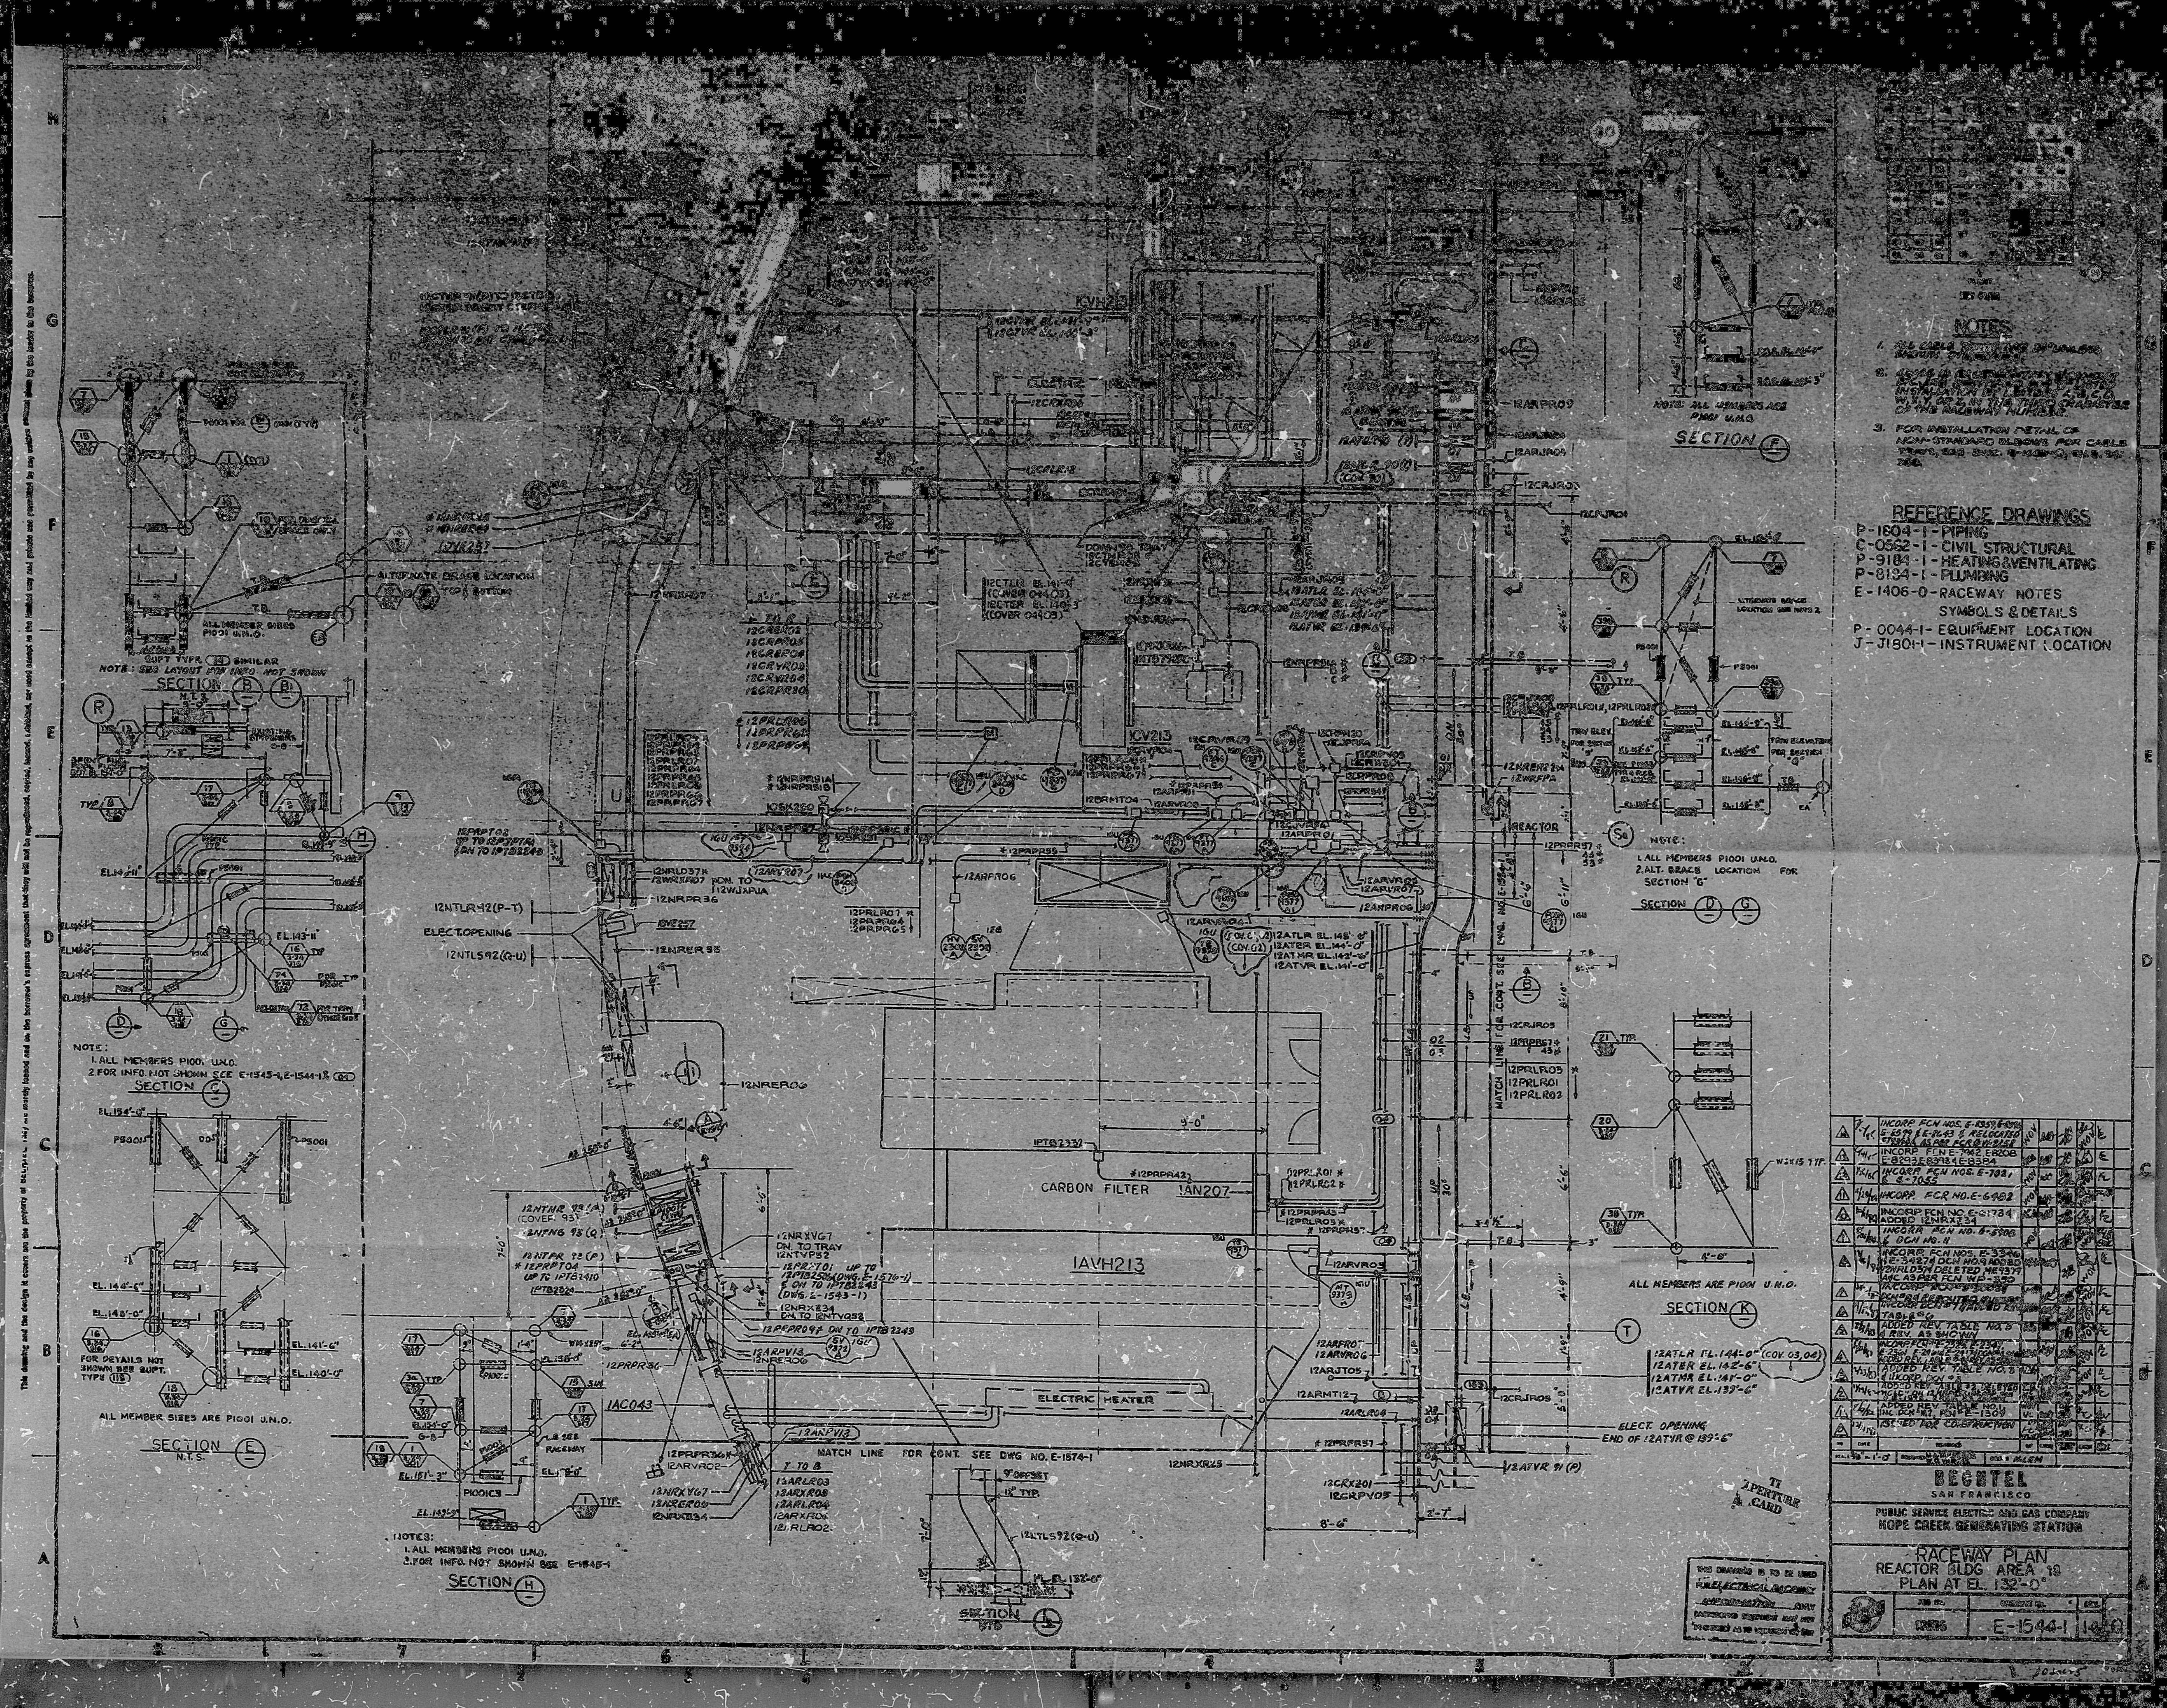
NOTES
3. FOR INSTALLATION DETAIL OF NON-STANDARD ELBOWS FOR CABLE TRAYS, SEE DWG. E-1406-0
REFERENCE DRAWINGS
P-1604-1 - PIPING
C-0562-1 - CIVIL STRUCTURAL
P-9184-1 - HEATING & VENTILATING
P-8134-1 - PLUMBING
E-1406-0 - RACEWAY NOTES SYMBOLS & DETAILS
P-0044-1 - EQUIPMENT LOCATION
J-J1801-1 - INSTRUMENT LOCATION
SECTION B B1
N.T.S.
NOTE: SEE LAYOUT FOR INFO. NOT SHOWN
ALL MEMBER SIZES P1001 U.N.O.
ALTERNATE BRACE LOCATION
NOTE:
1. ALL MEMBERS P1001 U.N.O.
2. FOR INFO. NOT SHOWN SEE E-1545-1, E-1544-1
SECTION C
FOR DETAILS NOT SHOWN SEE SUPT. TYPE 115
ALL MEMBER SIZES ARE P1001 U.N.O.
SECTION E
N.T.S.
NOTES:
1. ALL MEMBERS P1001 U.N.O.
2. FOR INFO. NOT SHOWN SEE E-1545-1
SECTION H
NOTE: ALL MEMBERS ARE P1001 U.N.O.
SECTION F
NOTE:
1. ALL MEMBERS P1001 U.N.O.
2. ALT. BRACE LOCATION FOR SECTION "G"
SECTION D G
ALL MEMBERS ARE P1001 U.N.O.
SECTION K
12NTLR92(P-T)
ELECT. OPENING
12NTLS92(Q-U)
1CV213
1AVH213
1AN207
CARBON FILTER
1AC043
ELECTRIC HEATER
MATCH LINE FOR CONT. SEE DWG NO. E-1574-1
MATCH LINE FOR CONT. SEE DWG. NO. E-1554-1
REACTOR
12ATLR EL. 144'-0"
12ATER EL. 142'-6"
12ATMR EL. 141'-0"
12ATVR EL. 139'-6"
(COV. 03, 04)
ELECT. OPENING
END OF 12ATVR @ 139'-6"
SECTION
PL. EL. 132'-0"
TI APERTURE CARD
INCORP. FCN NOS. E-6599 & E-8643 & RELOCATED
INCORP. FCN E-7962, E-8208, E-8293, E-8393 & E-8384
INCORP. FCN NOS. E-7021 & E-7055
INCORP. FCR NO. E-6982
INCORP. FCN NO. E-61734 ADDED 12NRX234
INCORP. FCN NO. E-5908 & DCN NO. 11
INCORP. FCN NOS. E-3346 & E-3427 & DCN NO. 9 ADDED 12NRLD37X DELETED ME9379 ...
ADDED REV. TABLE NO. 8 & REV. AS SHOWN
ADDED REV. TABLE NO. 3 & INCORP. DCN #3
ADDED REV. TABLE NO. 1, INC. DCN #2, FCN E-1309
ISSUED FOR CONSTRUCTION
BECHTEL
SAN FRANCISCO
PUBLIC SERVICE ELECTRIC AND GAS COMPANY
HOPE CREEK GENERATING STATION
RACEWAY PLAN
REACTOR BLDG AREA 18
PLAN AT EL. 132'-0"
E-1544-1
14

PDR RIDS

8510070222

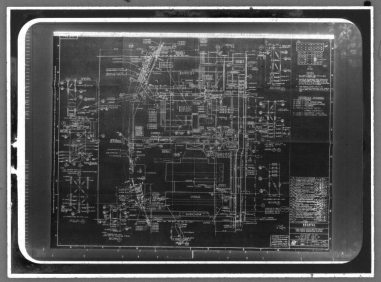

MMM 5824 — FULMSORT® Brand Aperture & Camera Cards and DUPLICARD® Brand Copy Cards — Product of 3M — St. Paul, Minn.