


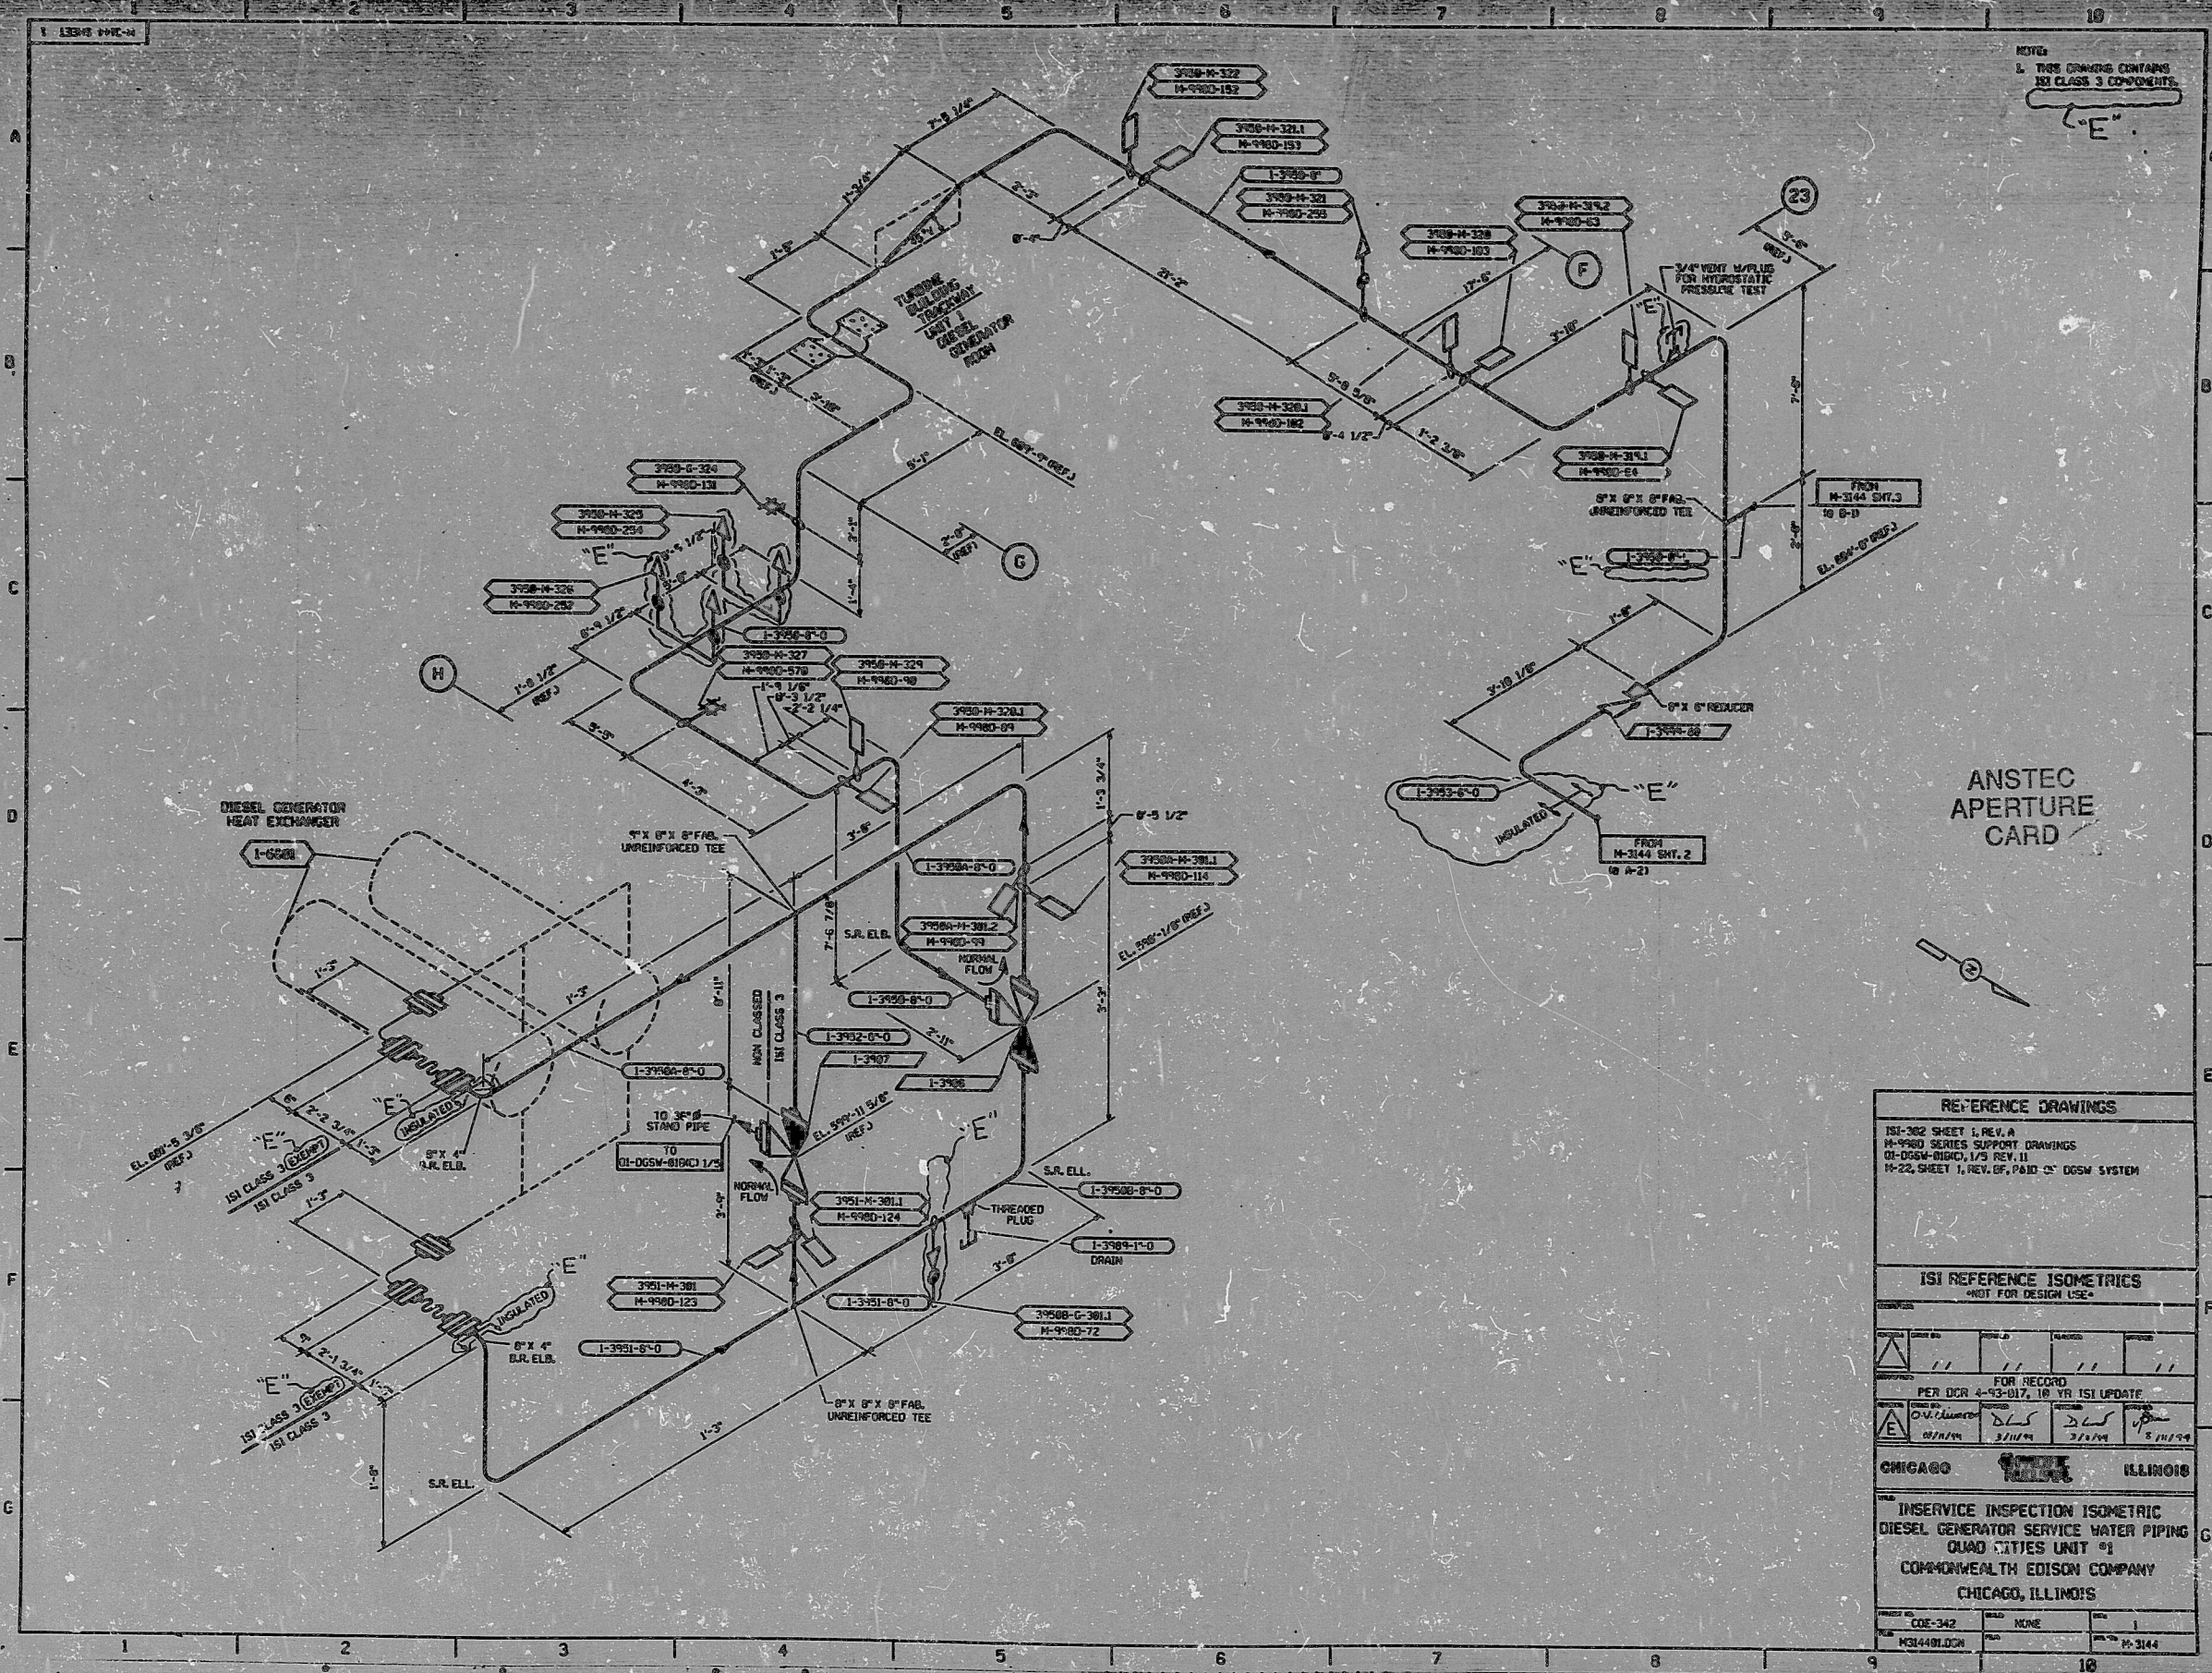

NOTE:
1. THIS DRAWING CONTAINS
CLASS 3 COMPONENTS
"E"

ANSTEC
APERTURE
CARD

REFERENCE DRAWINGS			
ISL-302 SHEET 1, REV. A H-900 SERIES SUPPORT DRAWINGS 01-0504-0000 1/3 REV. II H-22, SHEET 1, REV. OF, PAID "C" DOW SYSTEM			
ISI REFERENCE ISOMETRICS			
NOT FOR DESIGN USE			
FOR RECORD			
PER DCR 4-10-017, 10 YR ISI UPDATE			
CHICAGO ILLINOIS			
INSERVICE INSPECTION ISOMETRIC			
DIESEL GENERATOR SERVICE WATER PIPING			
QUAD CITIES UNIT #1			
COMMONWEALTH EDISON COMPANY			
CHICAGO, ILLINOIS			

CENTRAL DRAWING FACILITY

24X

9411180124

PDR RIDS

9411180124

