


14.5X
12-8-81 MAXIMUM IN CONTROL
DATE: CAMERA OPERATOR
SECTION SUPERVISOR

This drawing and the design it covers are the property of BECHTEL. They are loaned to you for your use only and are not to be reproduced, copied, issued, exhibited, or used except in the limited way and for the purposes intended by the loaner to the borrower.

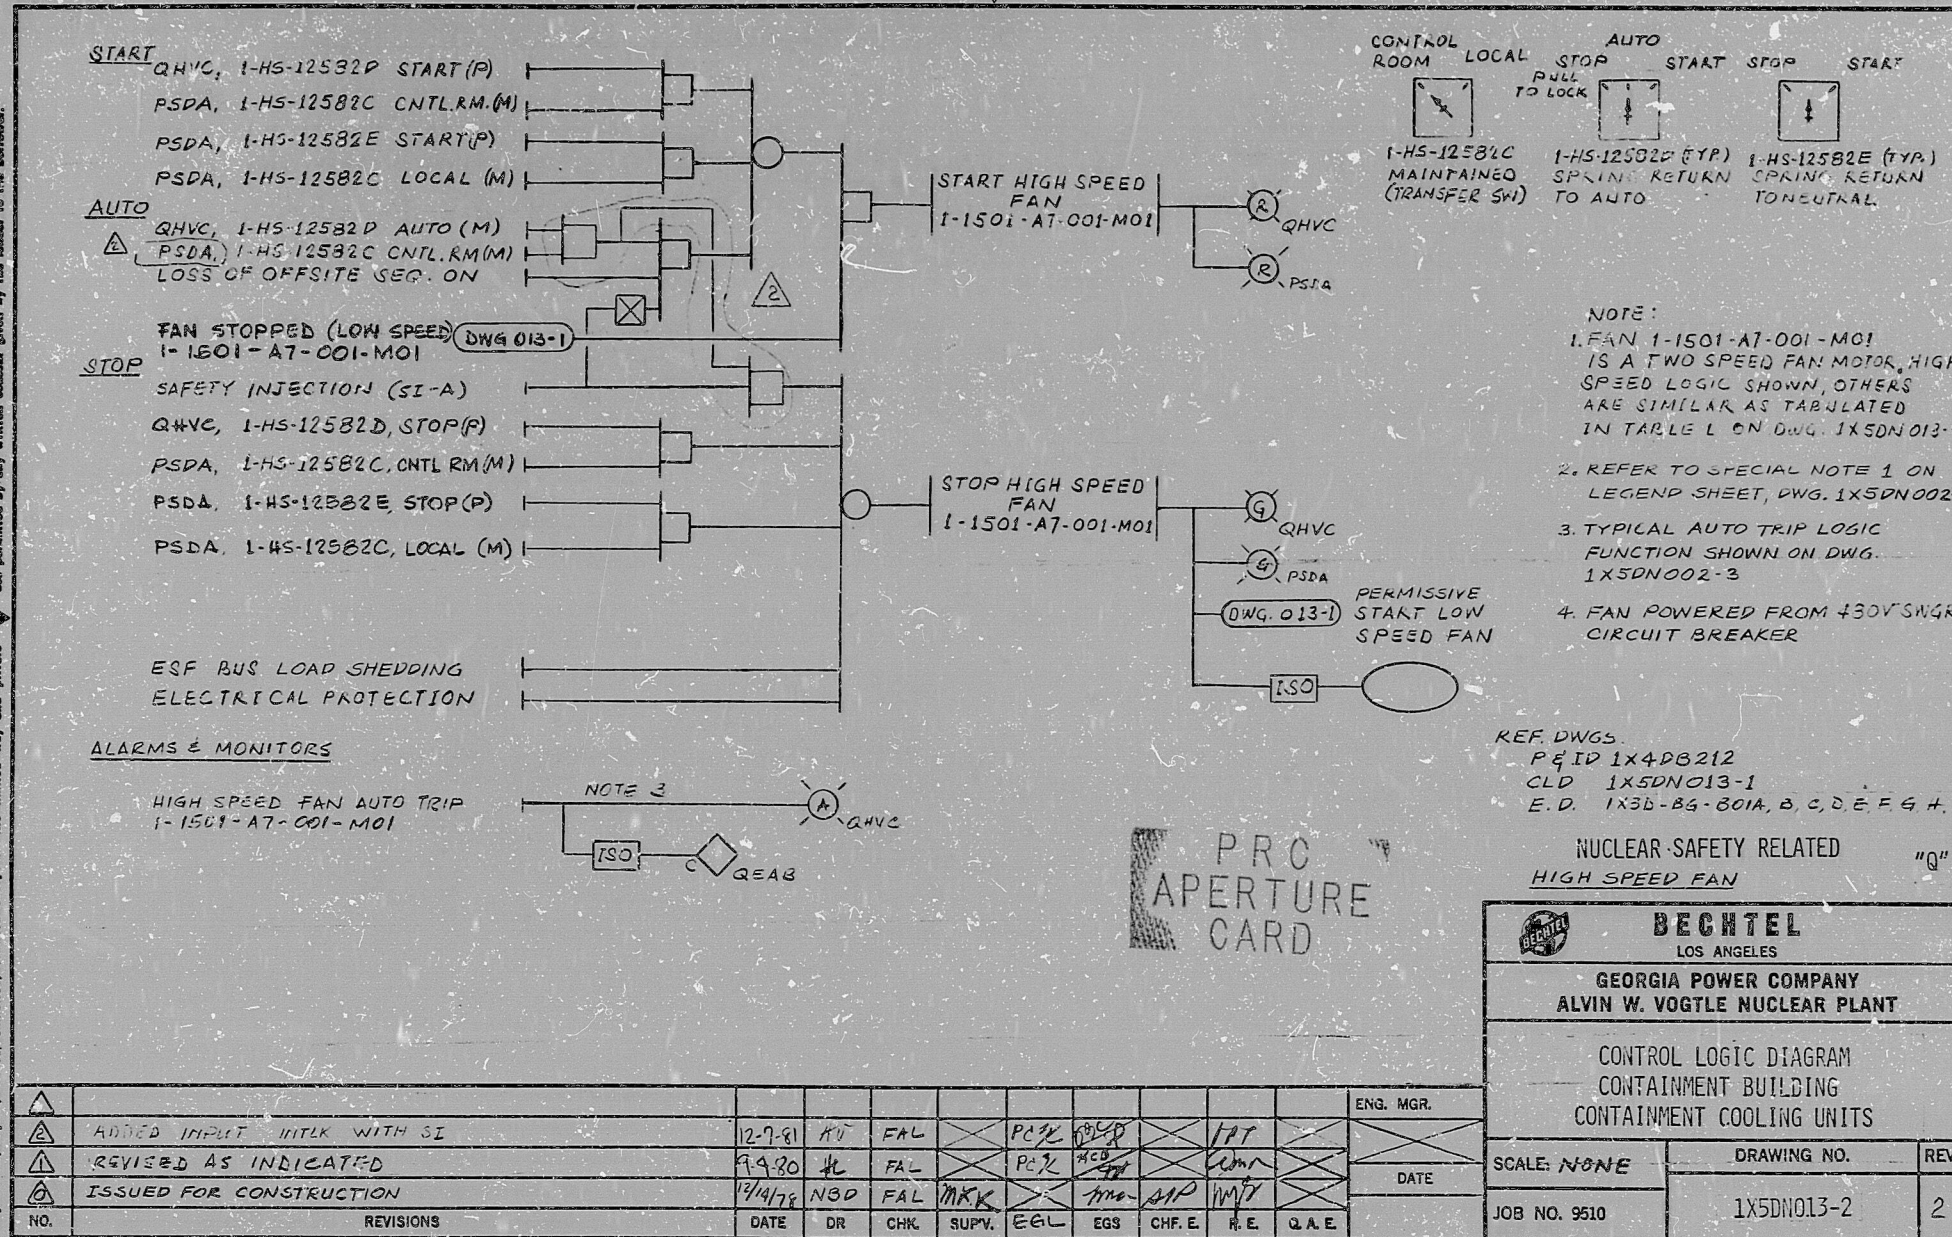

I CERTIFY THAT THE IMAGE CONTAINED ON THIS FRAME WAS MADE IN THE NORMAL AND REGULAR COURSE OF BUSINESS, ON THE DATE STATED BELOW AND THAT IT IS AN ACCURATE REPRODUCTION OF THE DOCUMENT SUBMITTED TO MICROGRAPHICS.

12-8-81 MAXIMUM IN CONTROL
DATE: CAMERA OPERATOR
SECTION SUPERVISOR

RIDS

8309270611

