

34"

34"

22"

22"

17"

17"

11"

11"

8.5"

8.5"

8.5"

8.5"

11"

11"

17"


17"

22"

22"


34"

34"

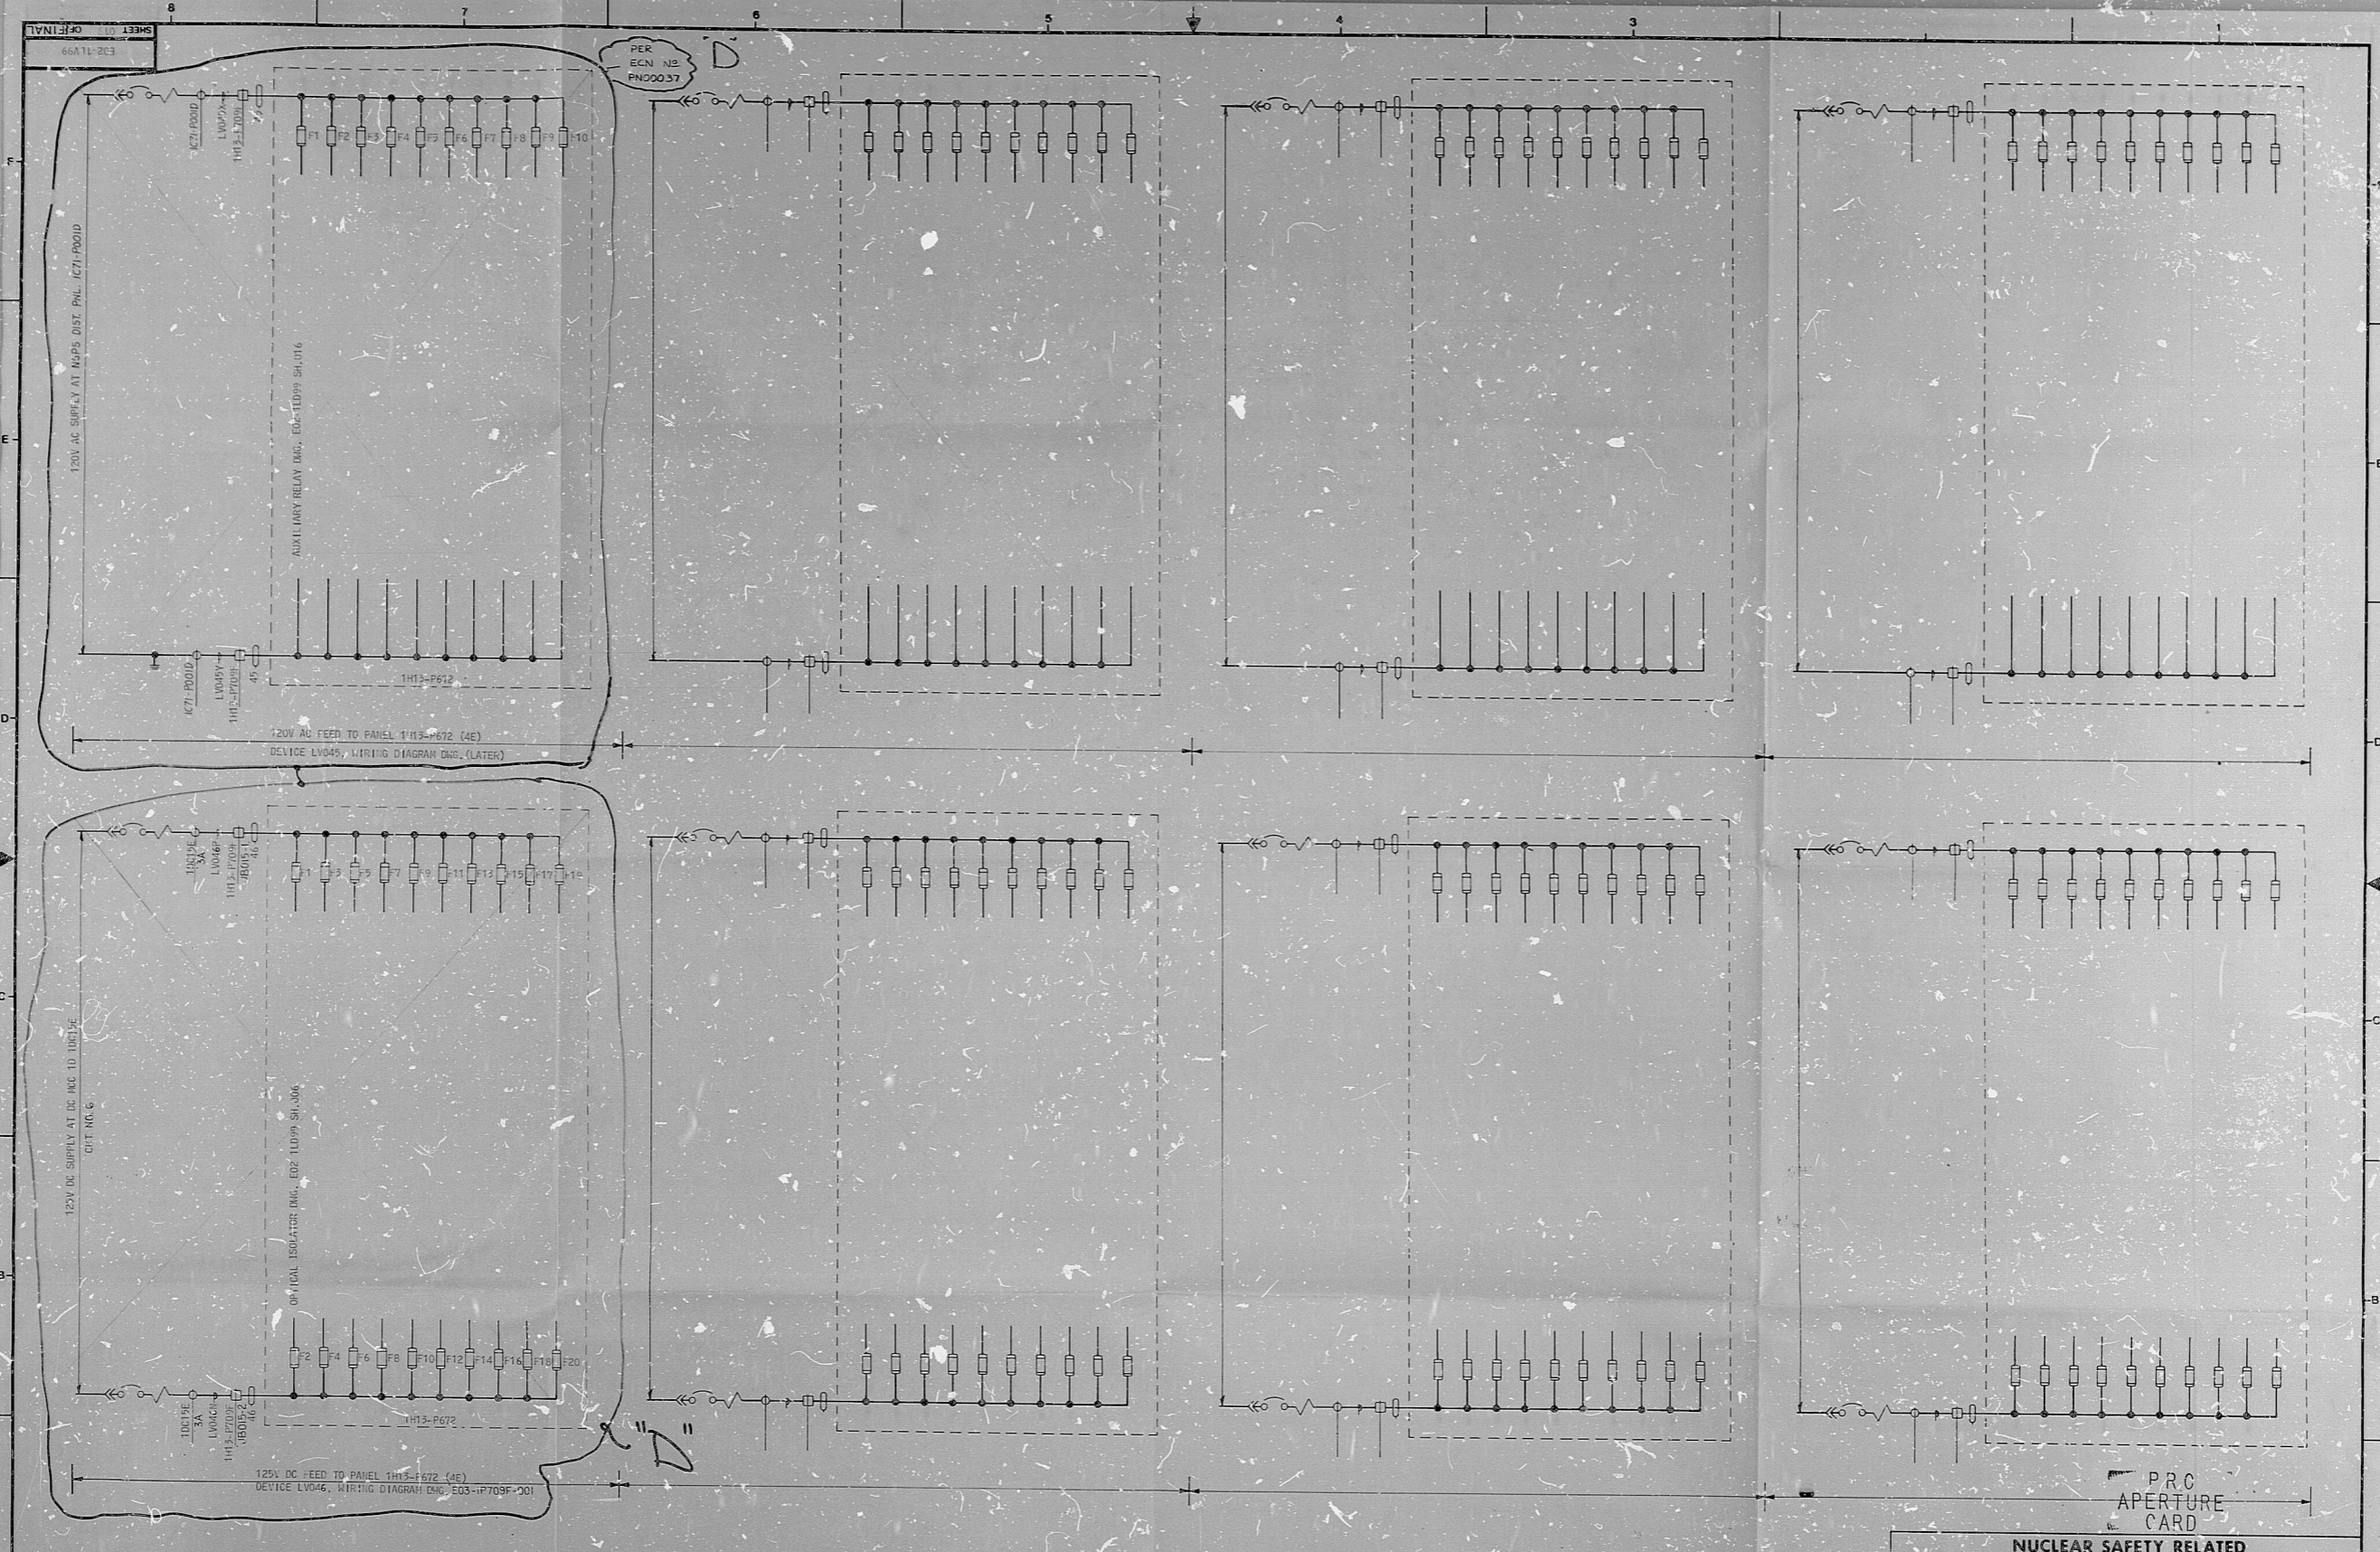

DRAWING RELEASE RECORD						DRAWING RELEASE RECORD									
REV.	DATE	RELD.	PREPARED	REVIEWED	APPROVED	PURPOSE	FILM	REV.	DATE	RELD.	PREPARED	REVIEWED	APPROVED	PURPOSE	FILM
B	1-31-79							C	2-27-81					RE-DRAWN FOR CONSTRUCTION SPEC NO. K-2999	
C	2-27-81							D	6-2-81					MID-REV FOR CONSTRUCTION, SPEC. K-2127	
														REV. USE CONSTRUCTION, SPEC. K-2999	

LINE CO-2 USED: 45,46
 FOR NOTES & REFERENCE SHOTS SEE SH-001

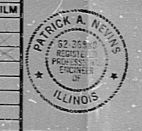

NUCLEAR SAFETY RELATED EQUIPMENT IS SHOWN ON THIS DRAWING.
 FOR SAFETY CLASSIFICATION SEE EQUIPMENT, VALVE OR INSTRUMENT LISTS.

SCALE: 1" = 12"

PROJECT NUMBER: 4536

SARGENT & LUNDY ENGINEERS CHICAGO

DRAWING NO. E02-1L999 REV. D

SHEET 001 OF FINAL


RIDS

Q10210279

