
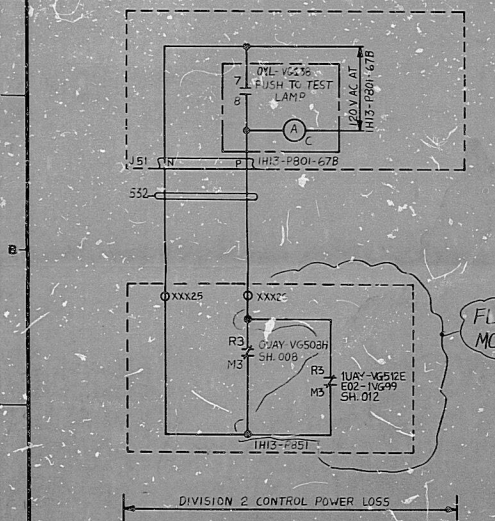


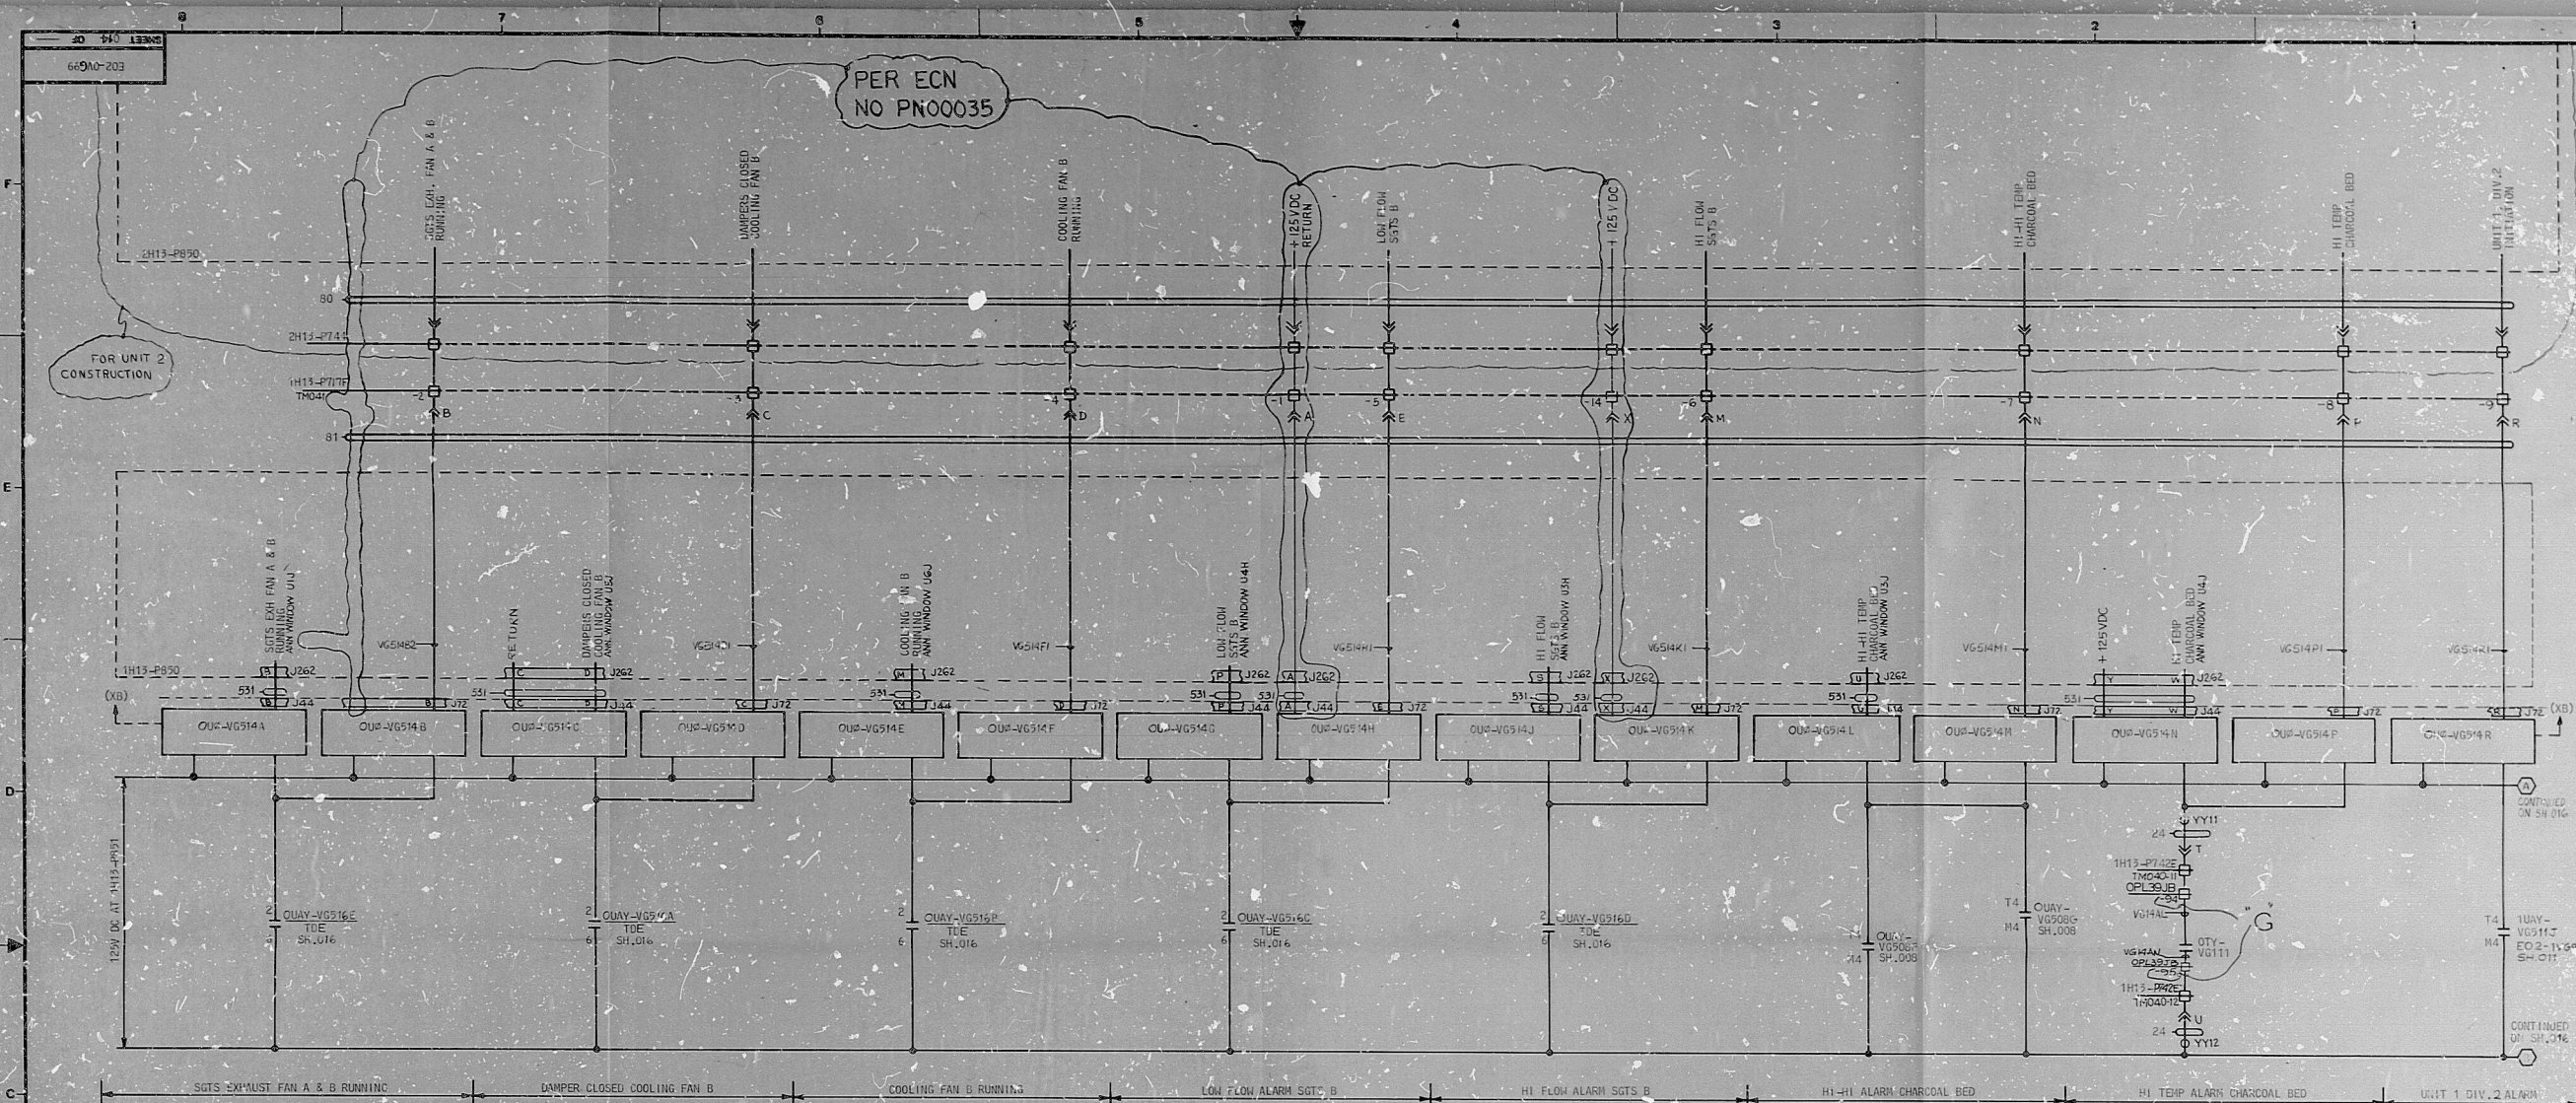

DRAWING RELEASE RECORD					DRAWING RELEASE RECORD				
REV.	DATE	RELD.	PREPARED	REVIEWED	PURPOSE	REV.	DATE	RELD.	PREPARED
A	7-24-77				FOR PCC FABRICATION ONLY, SPEC NO K-2501	A	7-24-77		
B	9-9-77				FOR PCC FABRICATION ONLY, SPEC NO K-2501	B	9-9-77		
C	9-30-77				FOR PCC FABRICATION ONLY, SPEC NO K-2501	C	9-30-77		
D	01-31-80				FOR PCC FABRICATION ONLY, SPEC NO K-2501	D	01-31-80		
E	12-29-80				MISC. REV. FOR CONSTRUCTION, SPEC NO K-2501	E	12-29-80		
F	04-07-81				REV. PER ECN PNO0035.4 MISC. REV. FOR CONST. SPEC NO K-2501	F	04-07-81		
G	7-18-81				REV. FOR CONSTRUCTION, SPEC NO K-2501	G	7-18-81		

PRC
APERTURE
CARD

NUCLEAR SAFETY RELATED
EQUIPMENT IS SHOWN ON THIS DRAWING.
(FOR SAFETY CLASSIFICATION SEE EQUIPMENT, VALVE, OR INSTRUMENT LISTS.)

SARGENT & LUNDY
ENGINEERS
CHICAGO

DRAWING NO. E02-0609
REV. G

CLINTON POWER STATION UNIT 1
ILLINOIS POWER COMPANY
CLINTON, ILLINOIS

SHEET 014 OF 01

RIPS

Q10210380

