


SA 1111 04 PM 8-19

NOTE:
THIS DRAWING CONTAINS
ISA CLASS 1 COMPONENTS

DELETED PIPING
DUE TO MODIFICATION
N-4-1/2-03-027

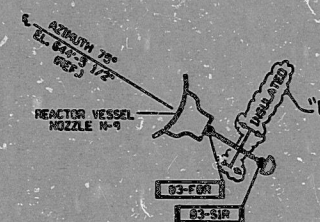

ANSTEC
APERTURE
CARD



REFERENCE DRAWINGS				
151-117 REV. B 02-CRDS-020 REV. 3 02-CRDS-020A REV. 3 M-1000 SERIES SUPPORT DRAWING N-33 SHEET 1 REV. A N-77 SHEET 1 REV. A				
ISI REFERENCE ISOMETRICS *NOT FOR DESIGN USE*				
FOR RECORD PER DCR 4-93-017, 10 YR ISI UPDATE				
CHICAGO ILLINOIS				
INSERVICE INSPECTION ISOMETRIC CONTROL ROD DRIVE PIPING QUAD CITIES UNIT #2 COMMONWEALTH EDISON COMPANY CHICAGO, ILLINOIS				

CENTRAL DRAWING FACILITY

24X

PDR RIDS

9411210222

