


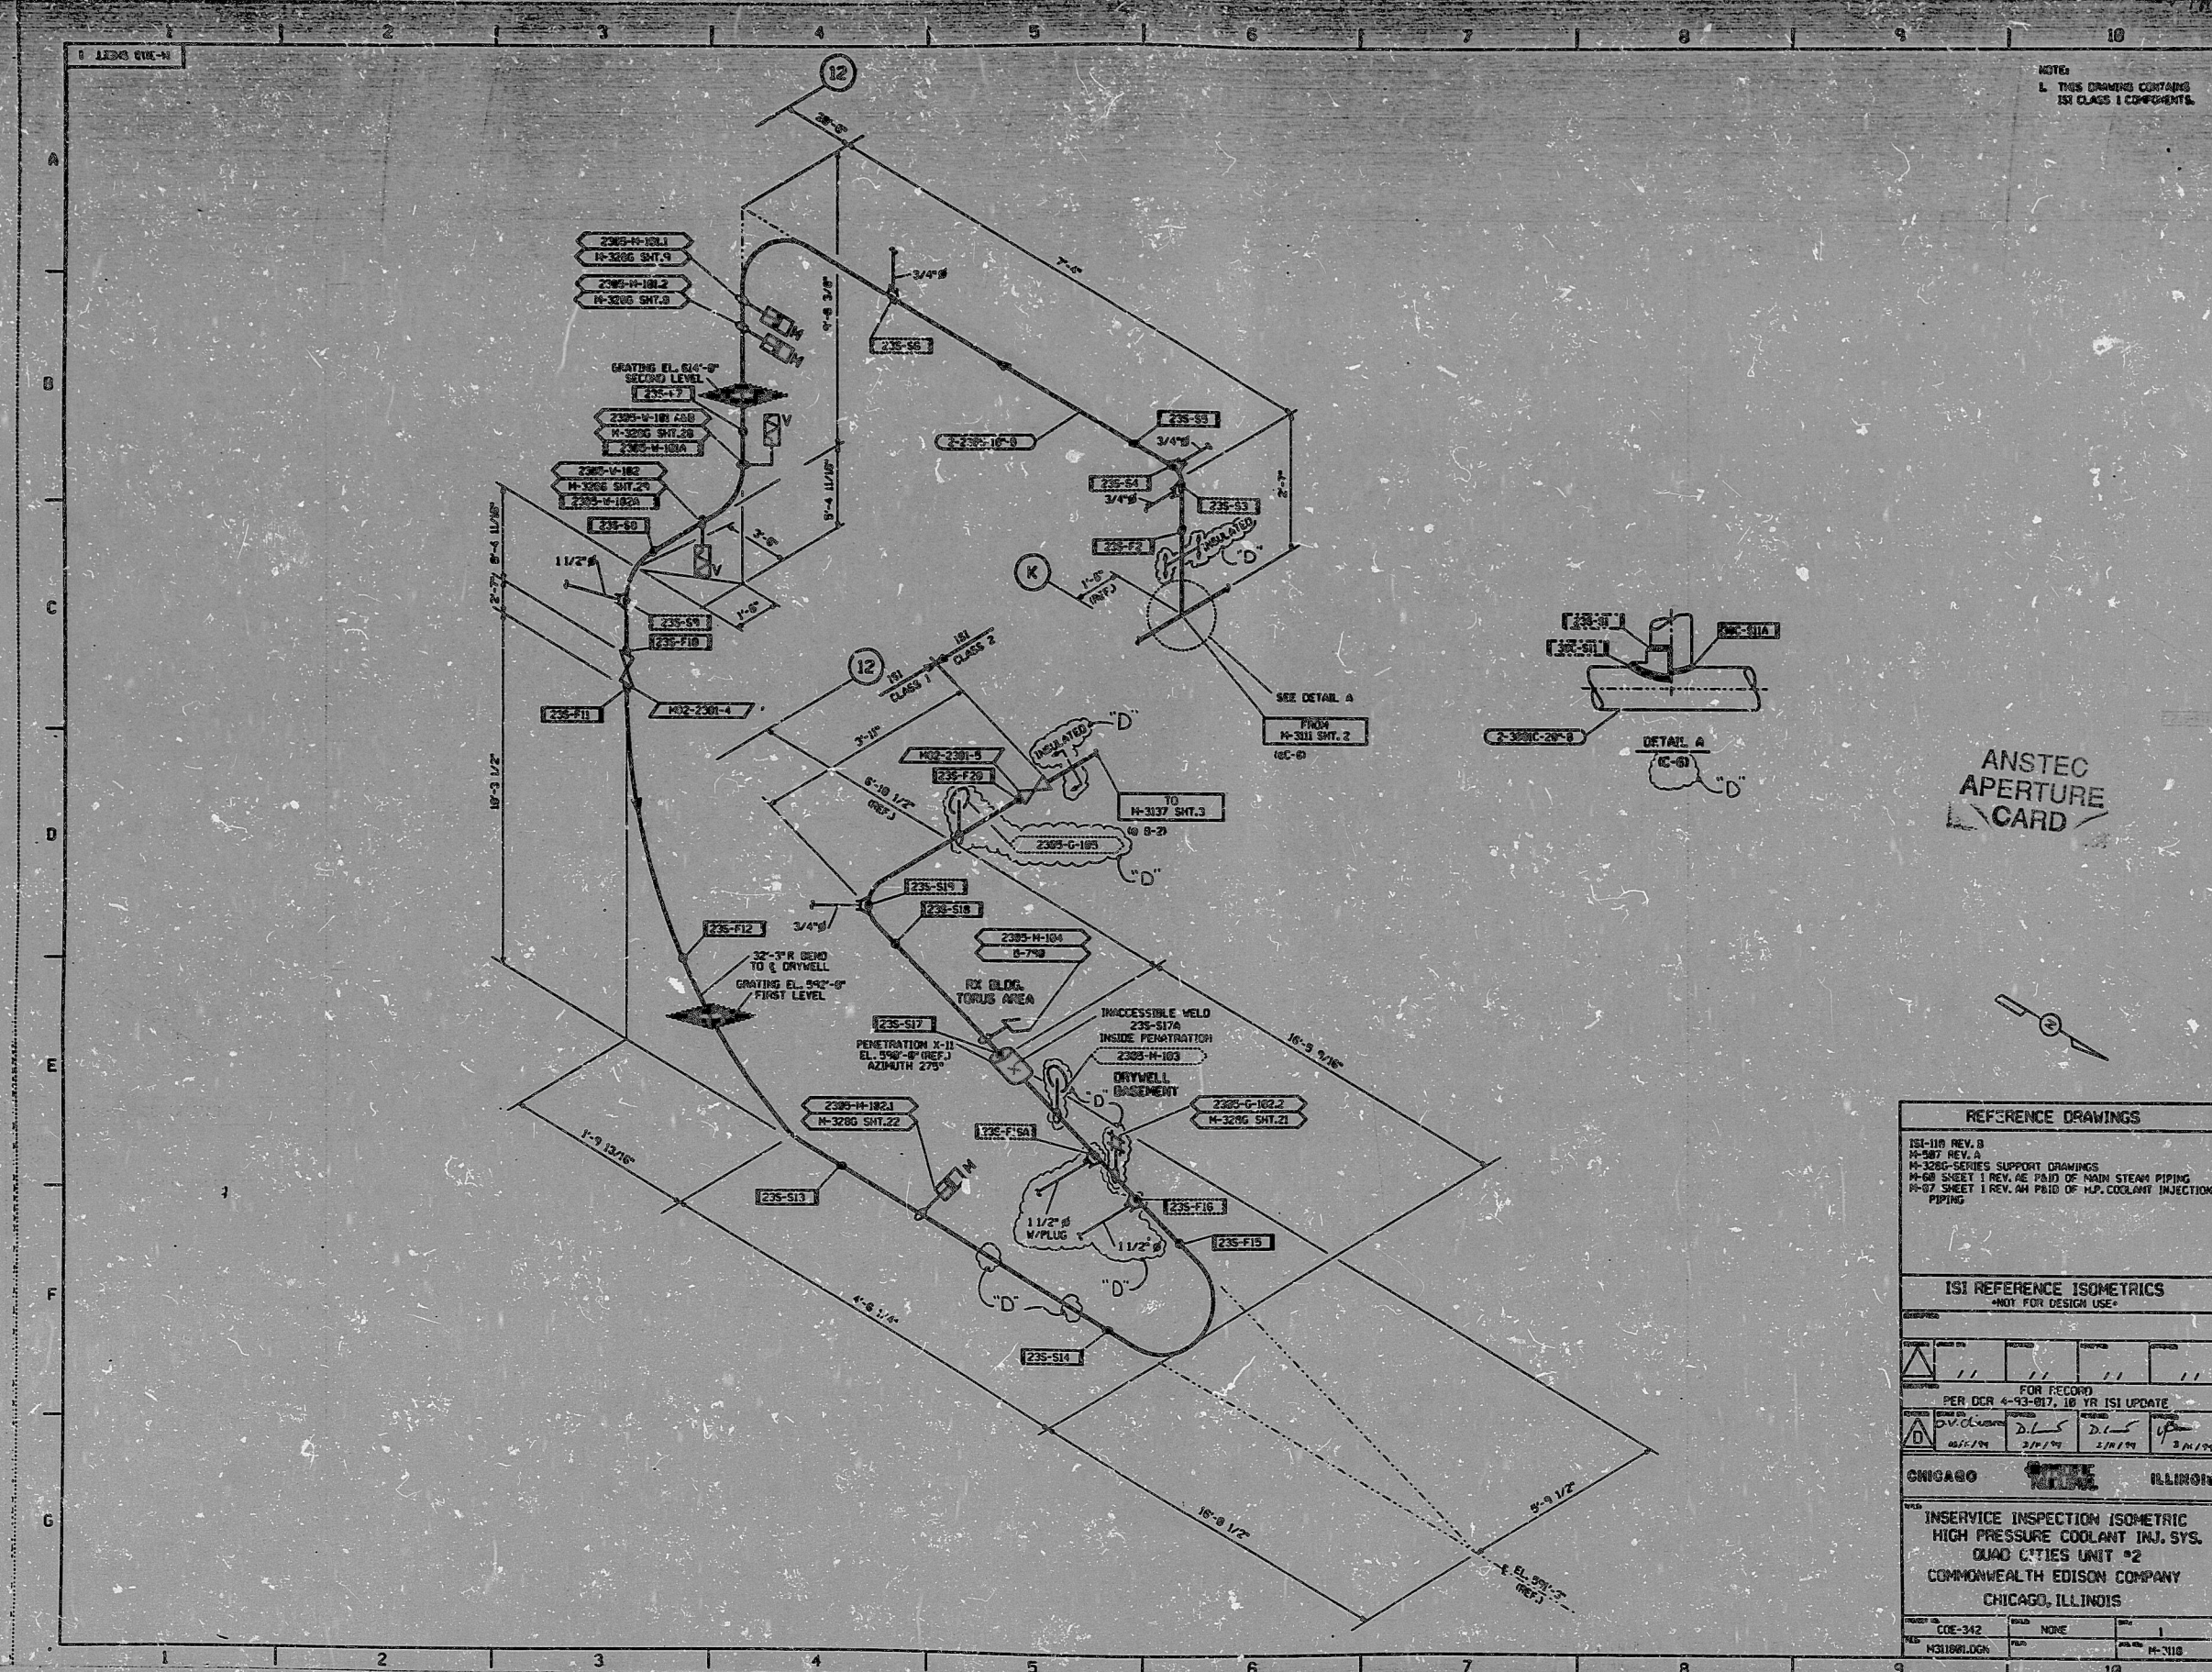

NOTES:
1. THIS DRAWING CONTAINS
ISI CLASS 1 COMPONENTS.

ANSTEC
APERTURE
CARD

REFERENCE DRAWINGS			
ISI REFERENCE ISOMETRICS			
NOT FOR DESIGN USE			

PDR RIDS

9411210225

