


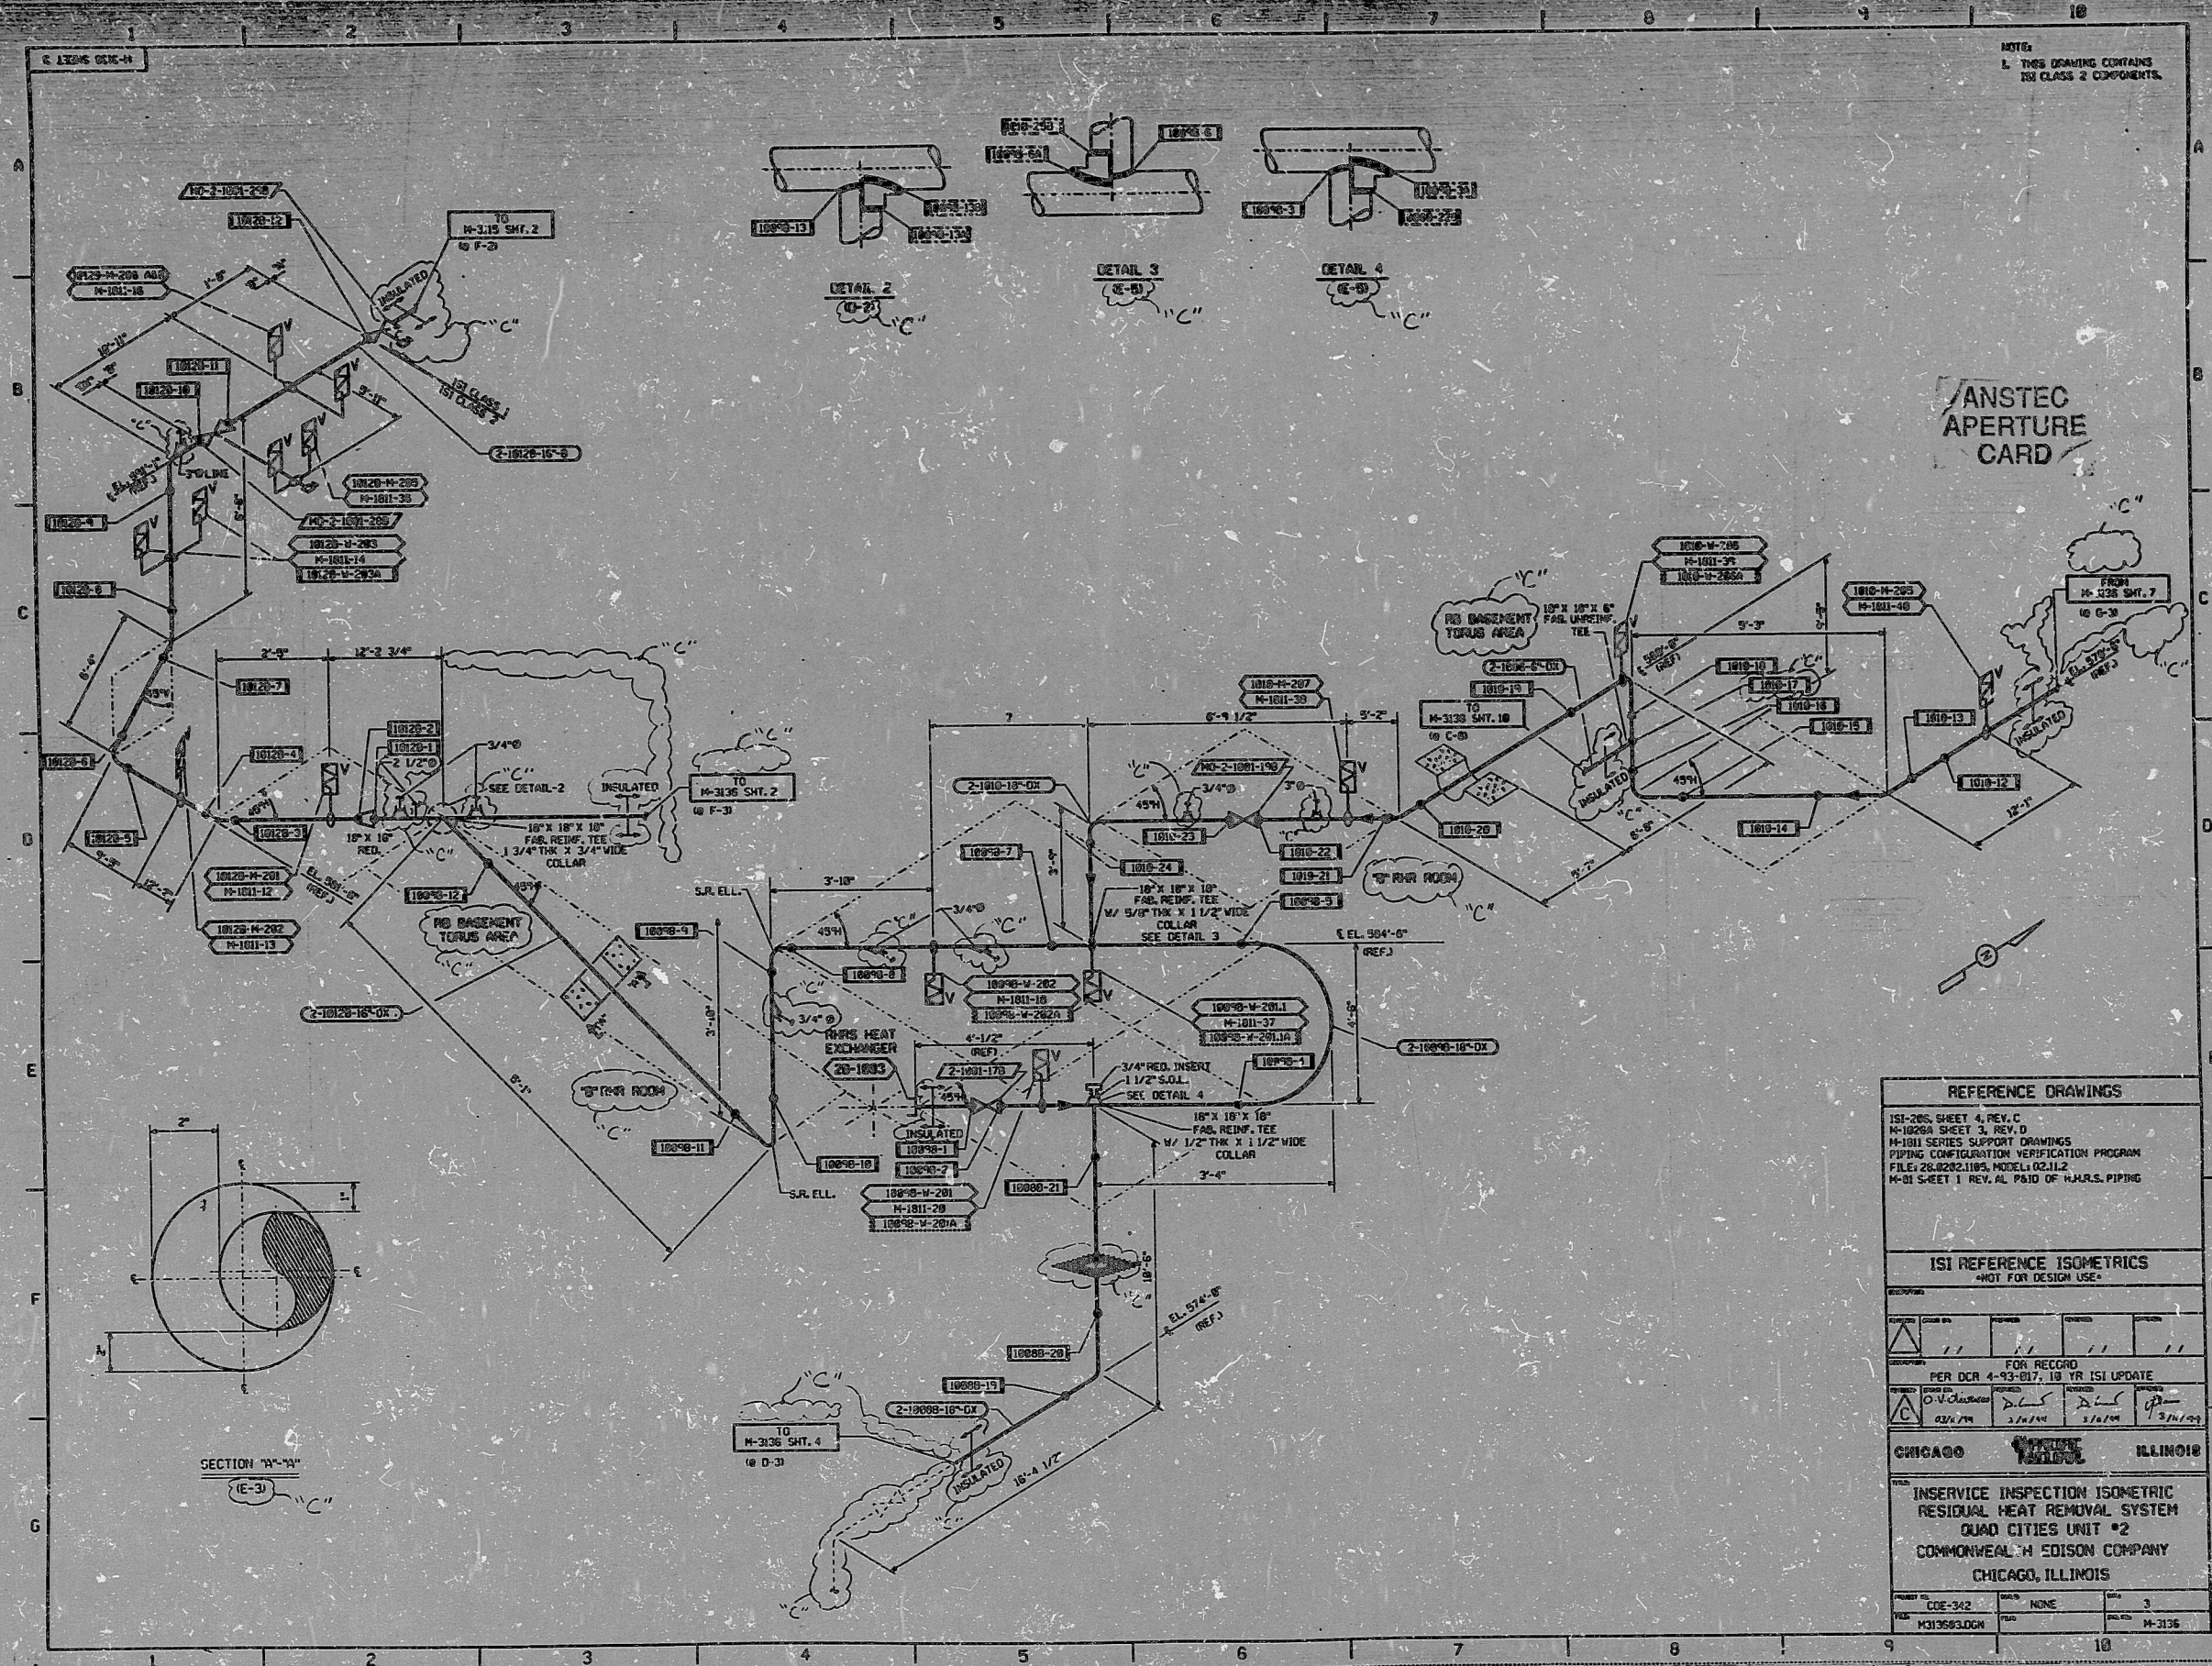

ANSTEC
APERTURE
CARD

REFERENCE DRAWINGS			
ISI-205, SHEET 4, REV. C			
M-1026A SHEET 3, REV. D			
M-1011 SERIES SUPPORT DRAWINGS			
PIPING CONFIGURATION VERIFICATION PROGRAM			
FILE: 28.0222.1185, MODEL: 02.112			
M-01 SHEET 1 REV. AL PAID OF H.A.R.S. PIPING			
ISI REFERENCE ISOMETRICS			
NOT FOR DESIGN USE			
FOR RECORD			
PER DCR 4-93-017, 10 YR ISI UPDATE			
CHICAGO		ILLINOIS	
INSERVICE INSPECTION ISOMETRIC RESIDUAL HEAT REMOVAL SYSTEM QUAD CITIES UNIT #2 COMMONWEALTH EDISON COMPANY CHICAGO, ILLINOIS			
CODE: 342	NONE	3	
M313553.DGN			M-3135

CENTRAL DRAWING FACILITY

24X

PDR RIDS

Q411210307

