


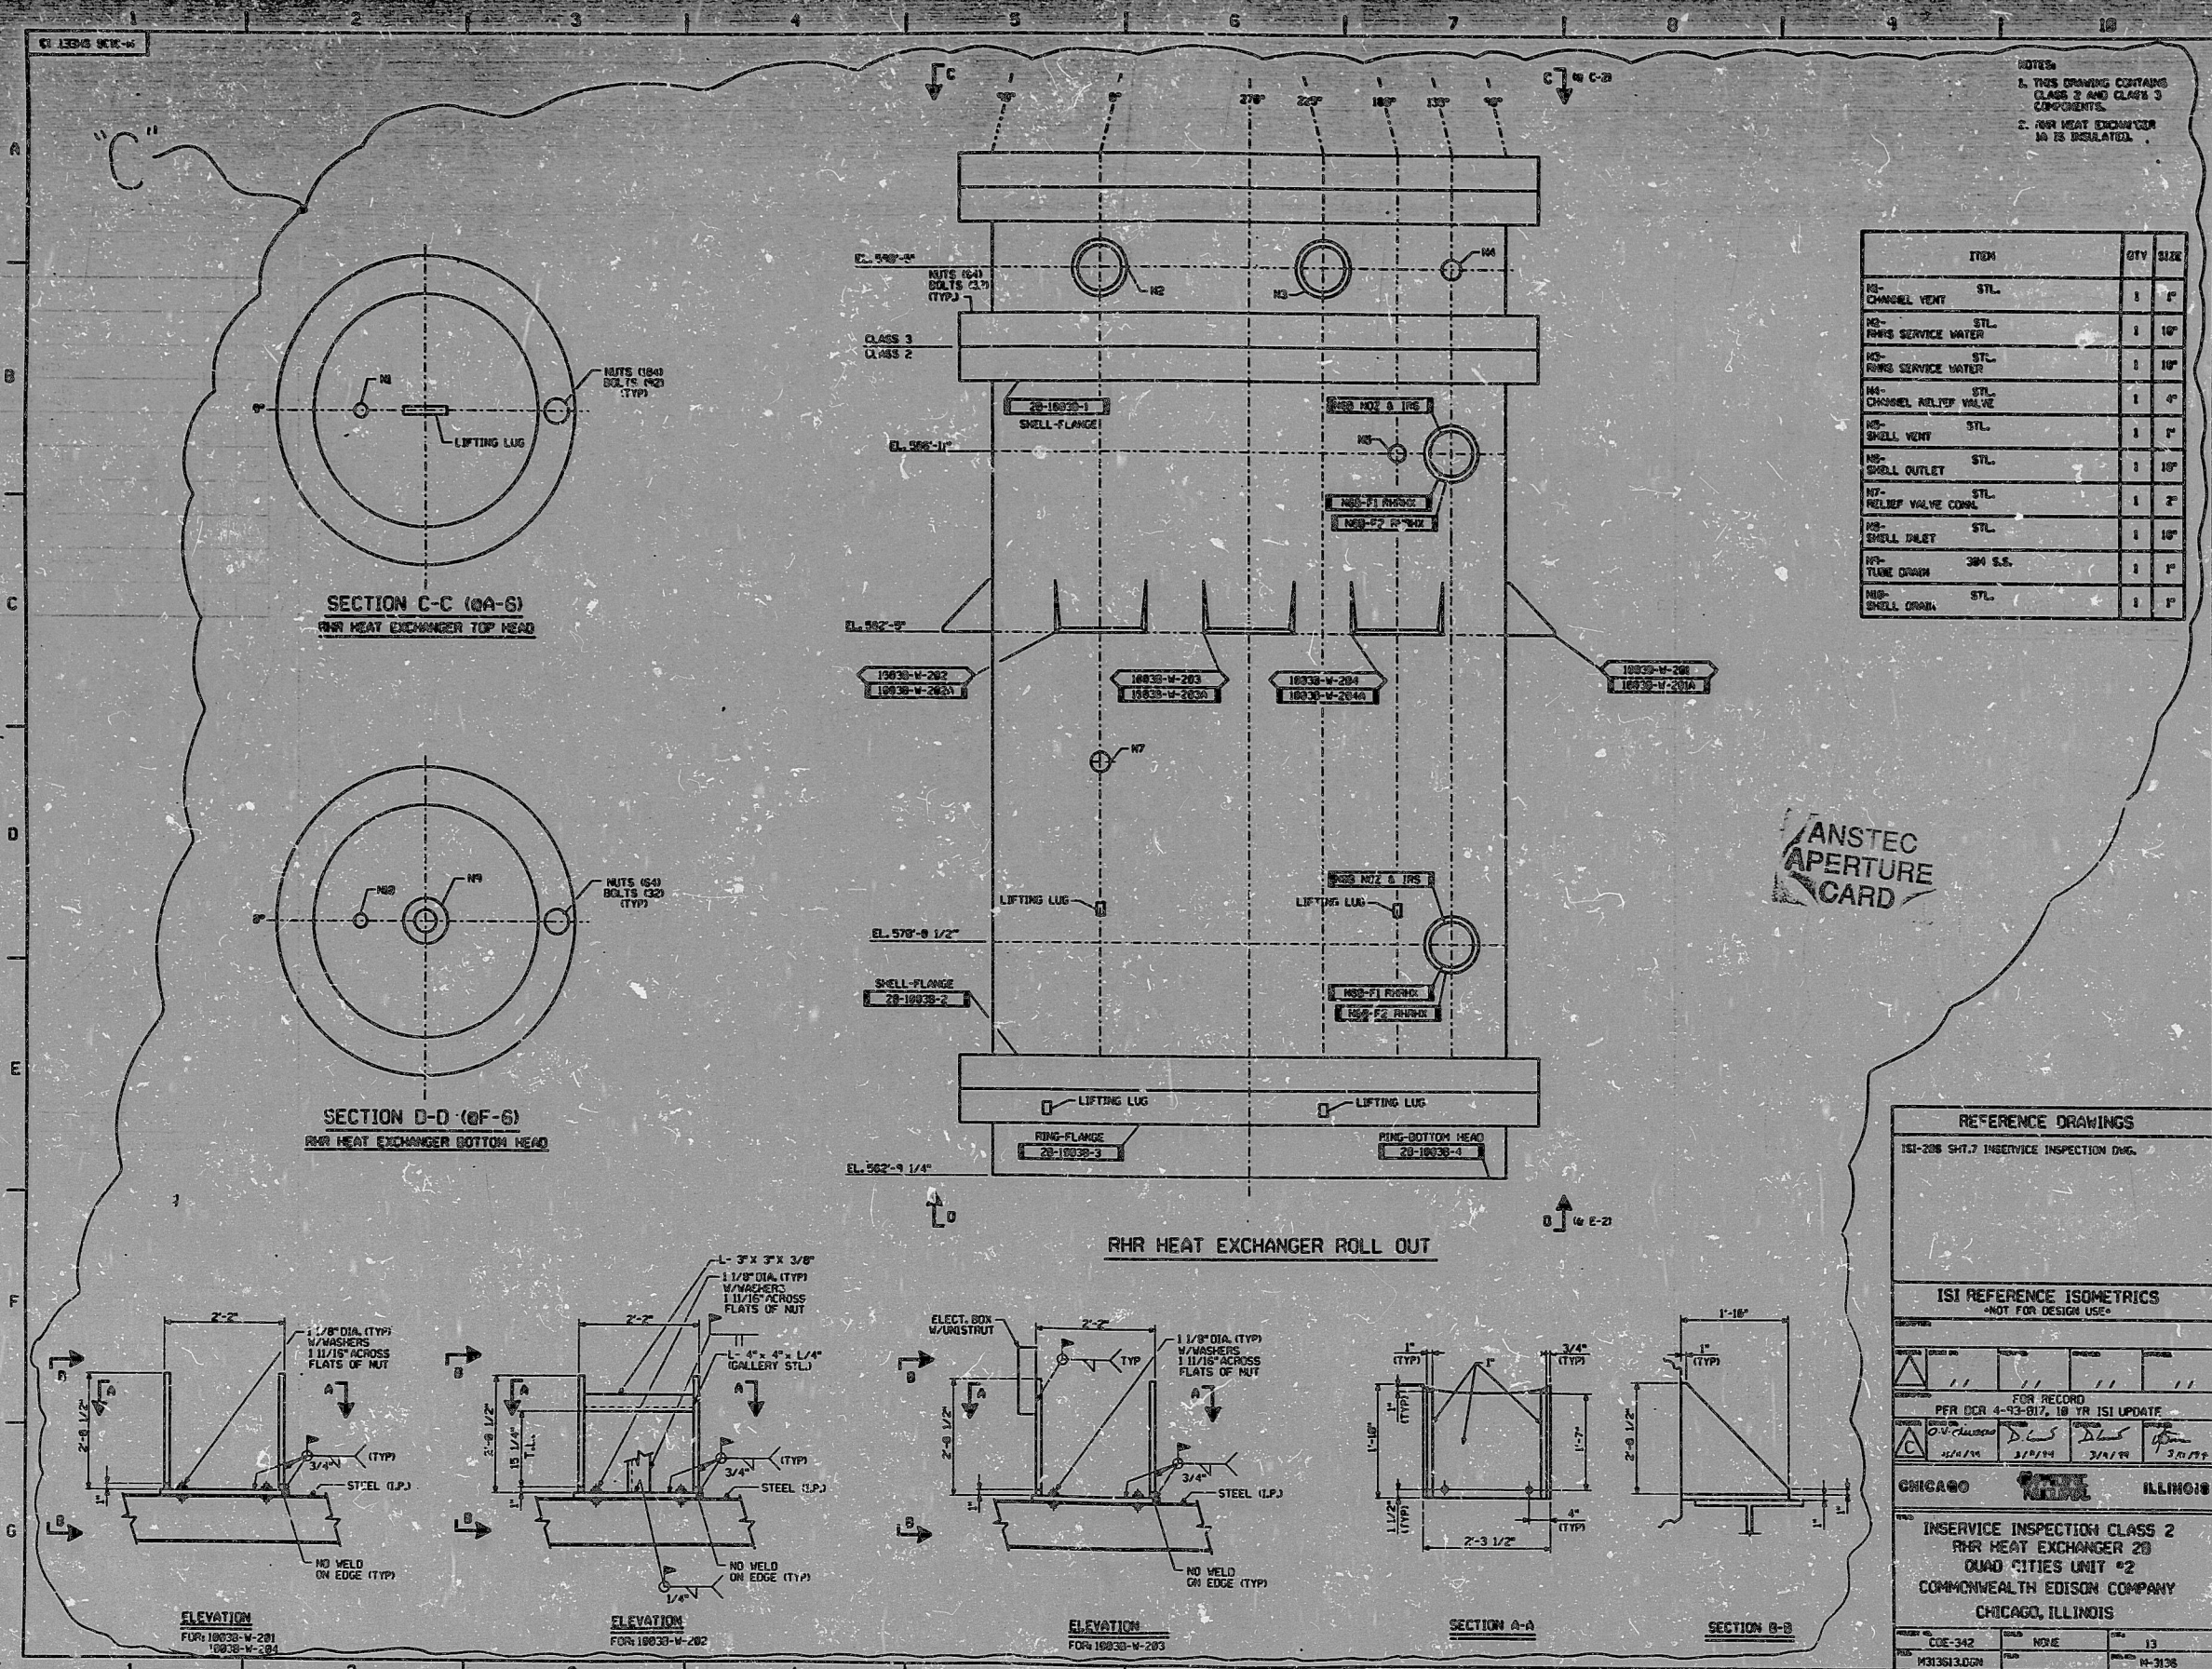

ITEM	QTY	SIZE
NO- CHANNEL VENT	1	1"
NO- RING SERVICE WATER	1	10"
NO- RING SERVICE WATER	1	10"
NO- CHANNEL RELIEF VALVE	1	4"
NO- SKELL VENT	1	1"
NO- SKELL OUTLET	1	10"
NO- RELIEF VALVE CORN.	1	2"
NO- SKELL INLET	1	10"
NO- TUNE DRAIN	1	1"
NO- SKELL DRAIN	1	1"

REFERENCE DRAWINGS

ISI-208 SH-7 INSERVICE INSPECTION Dwg.

ISI REFERENCE ISOMETRICS
NOT FOR DESIGN USE

REVISION	DATE	BY	CHKD

FOR RECORD
PER DCR 4-10-017, 10 YR ISI UPDATE

CHICAGO ILLINOIS

INSERVICE INSPECTION CLASS 2
RHR HEAT EXCHANGER 20
QUAD CITIES UNIT #2
COMMONWEALTH EDISON COMPANY
CHICAGO, ILLINOIS

CD-342
M31361.000
H-3136

CENTRAL DRAWING FACILITY

24X

PDR RIDS

9411210324

