


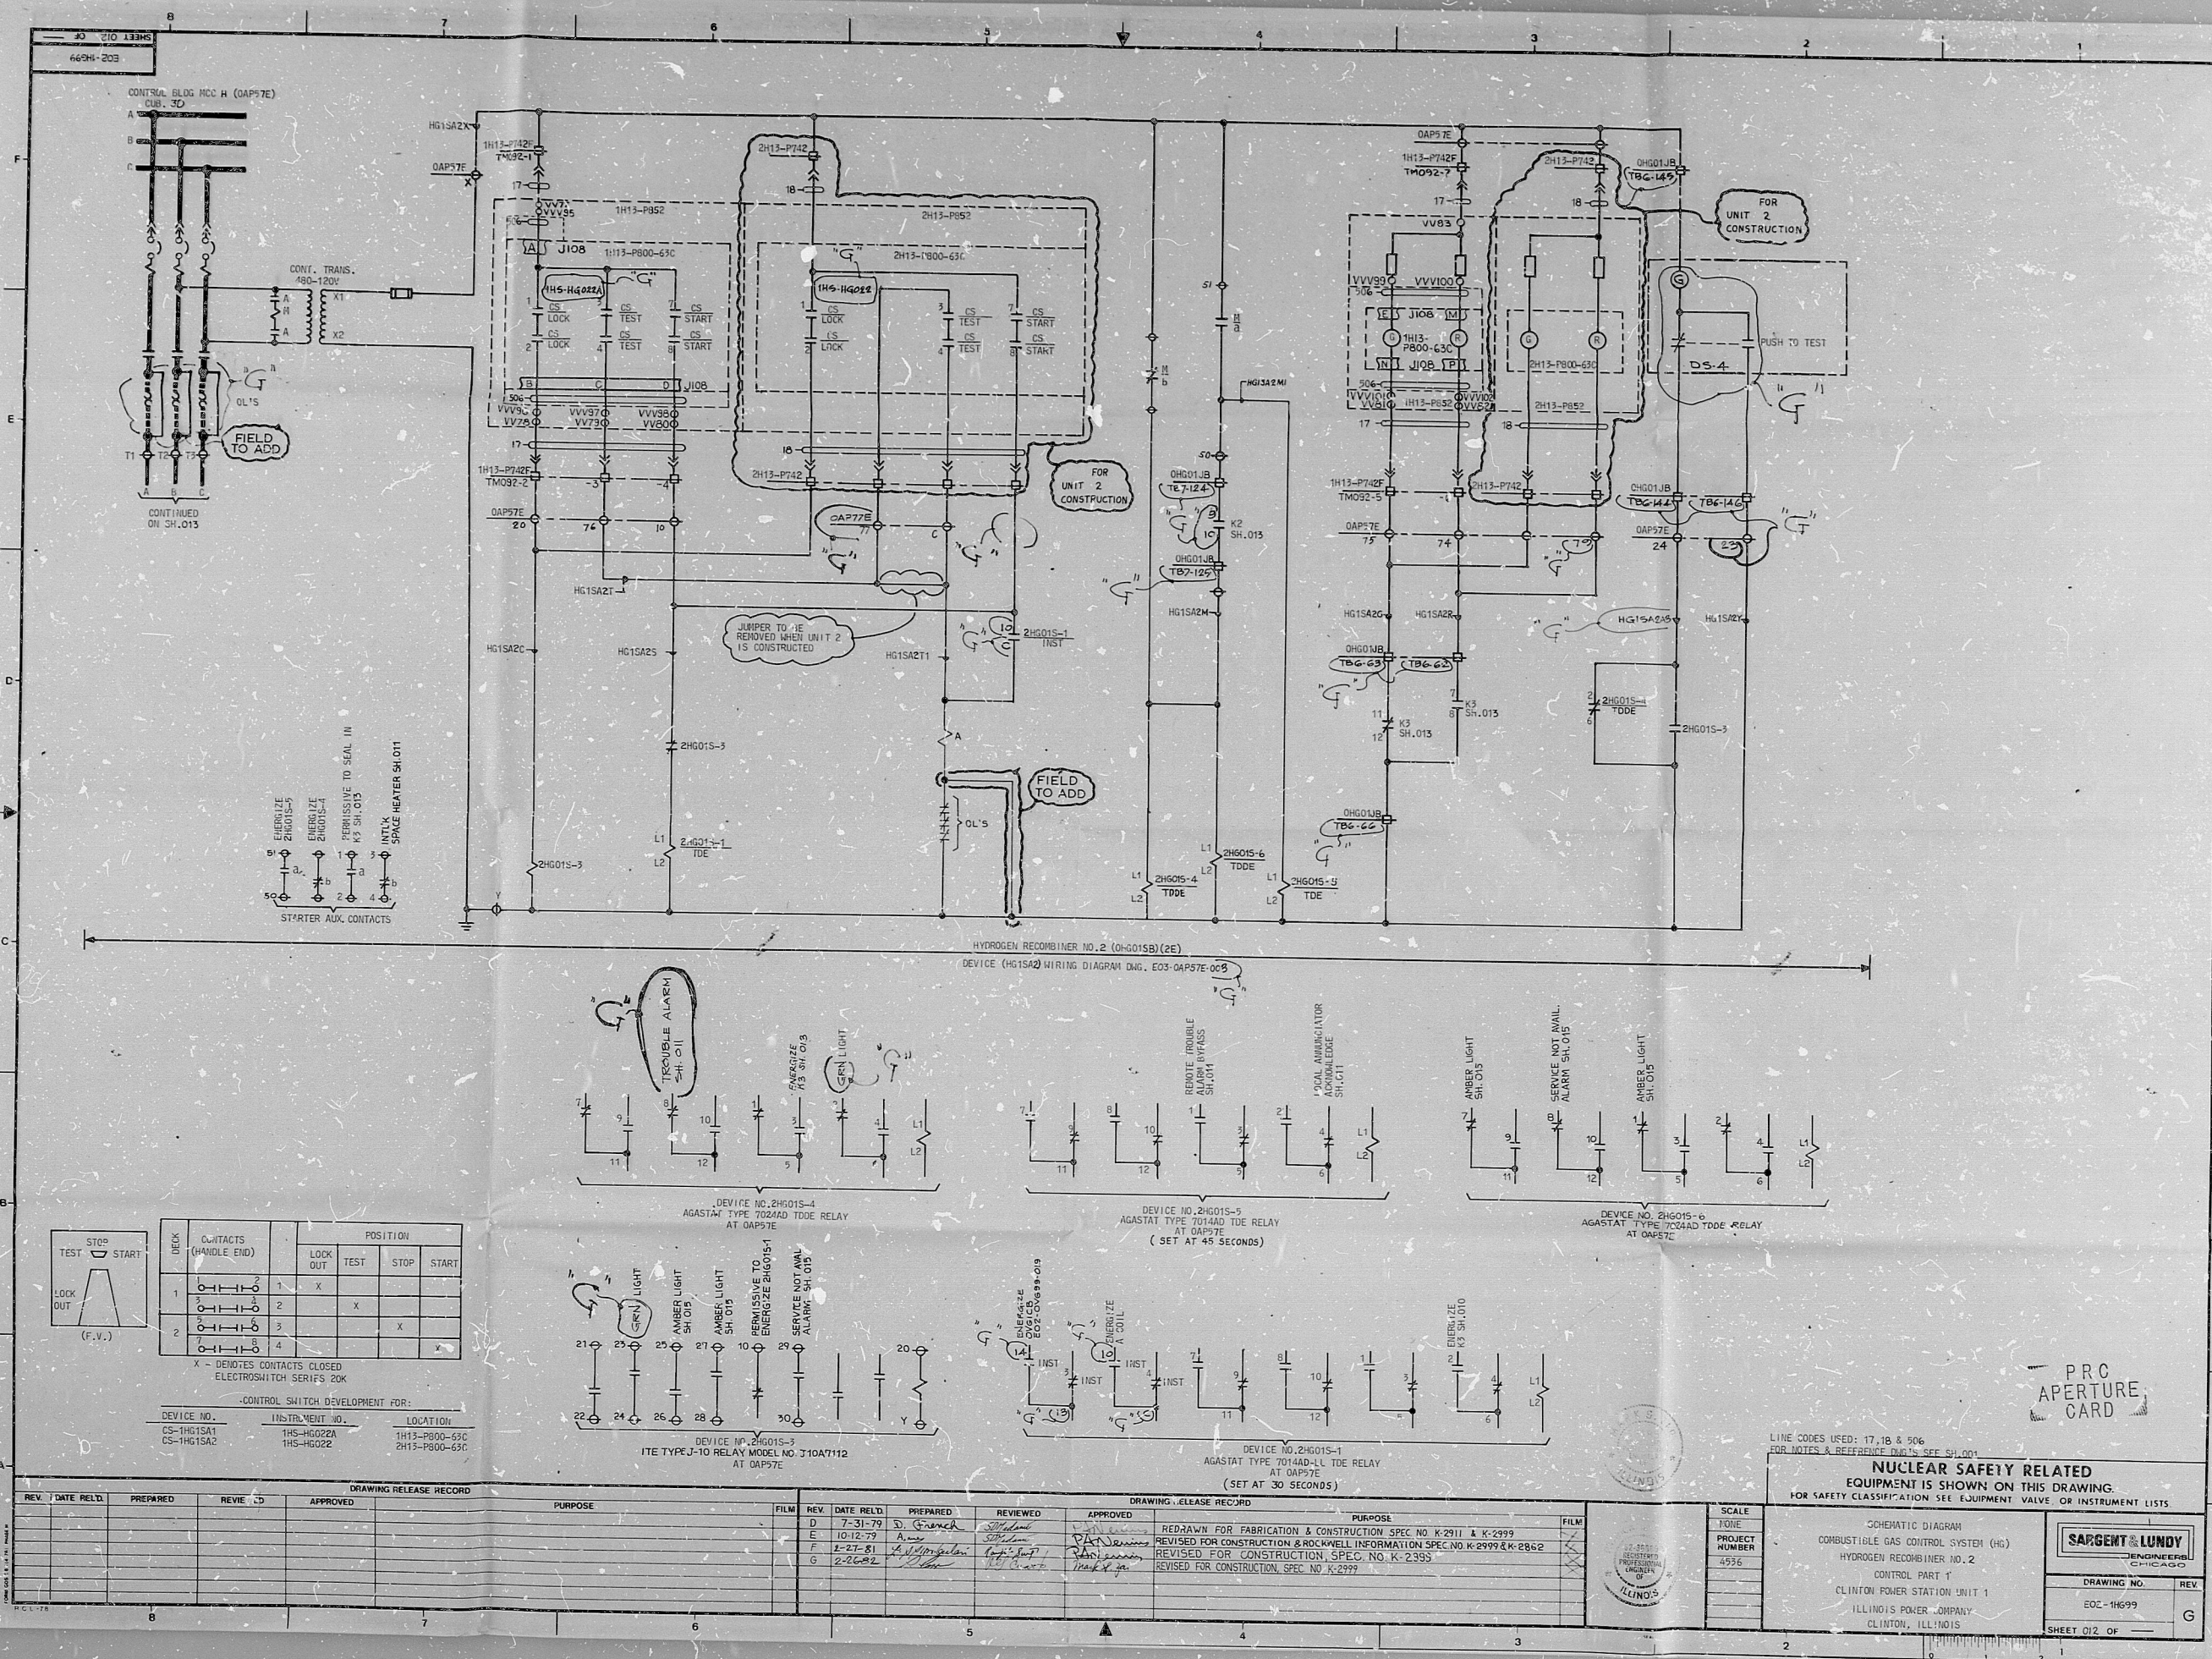

Rib

00210563

