


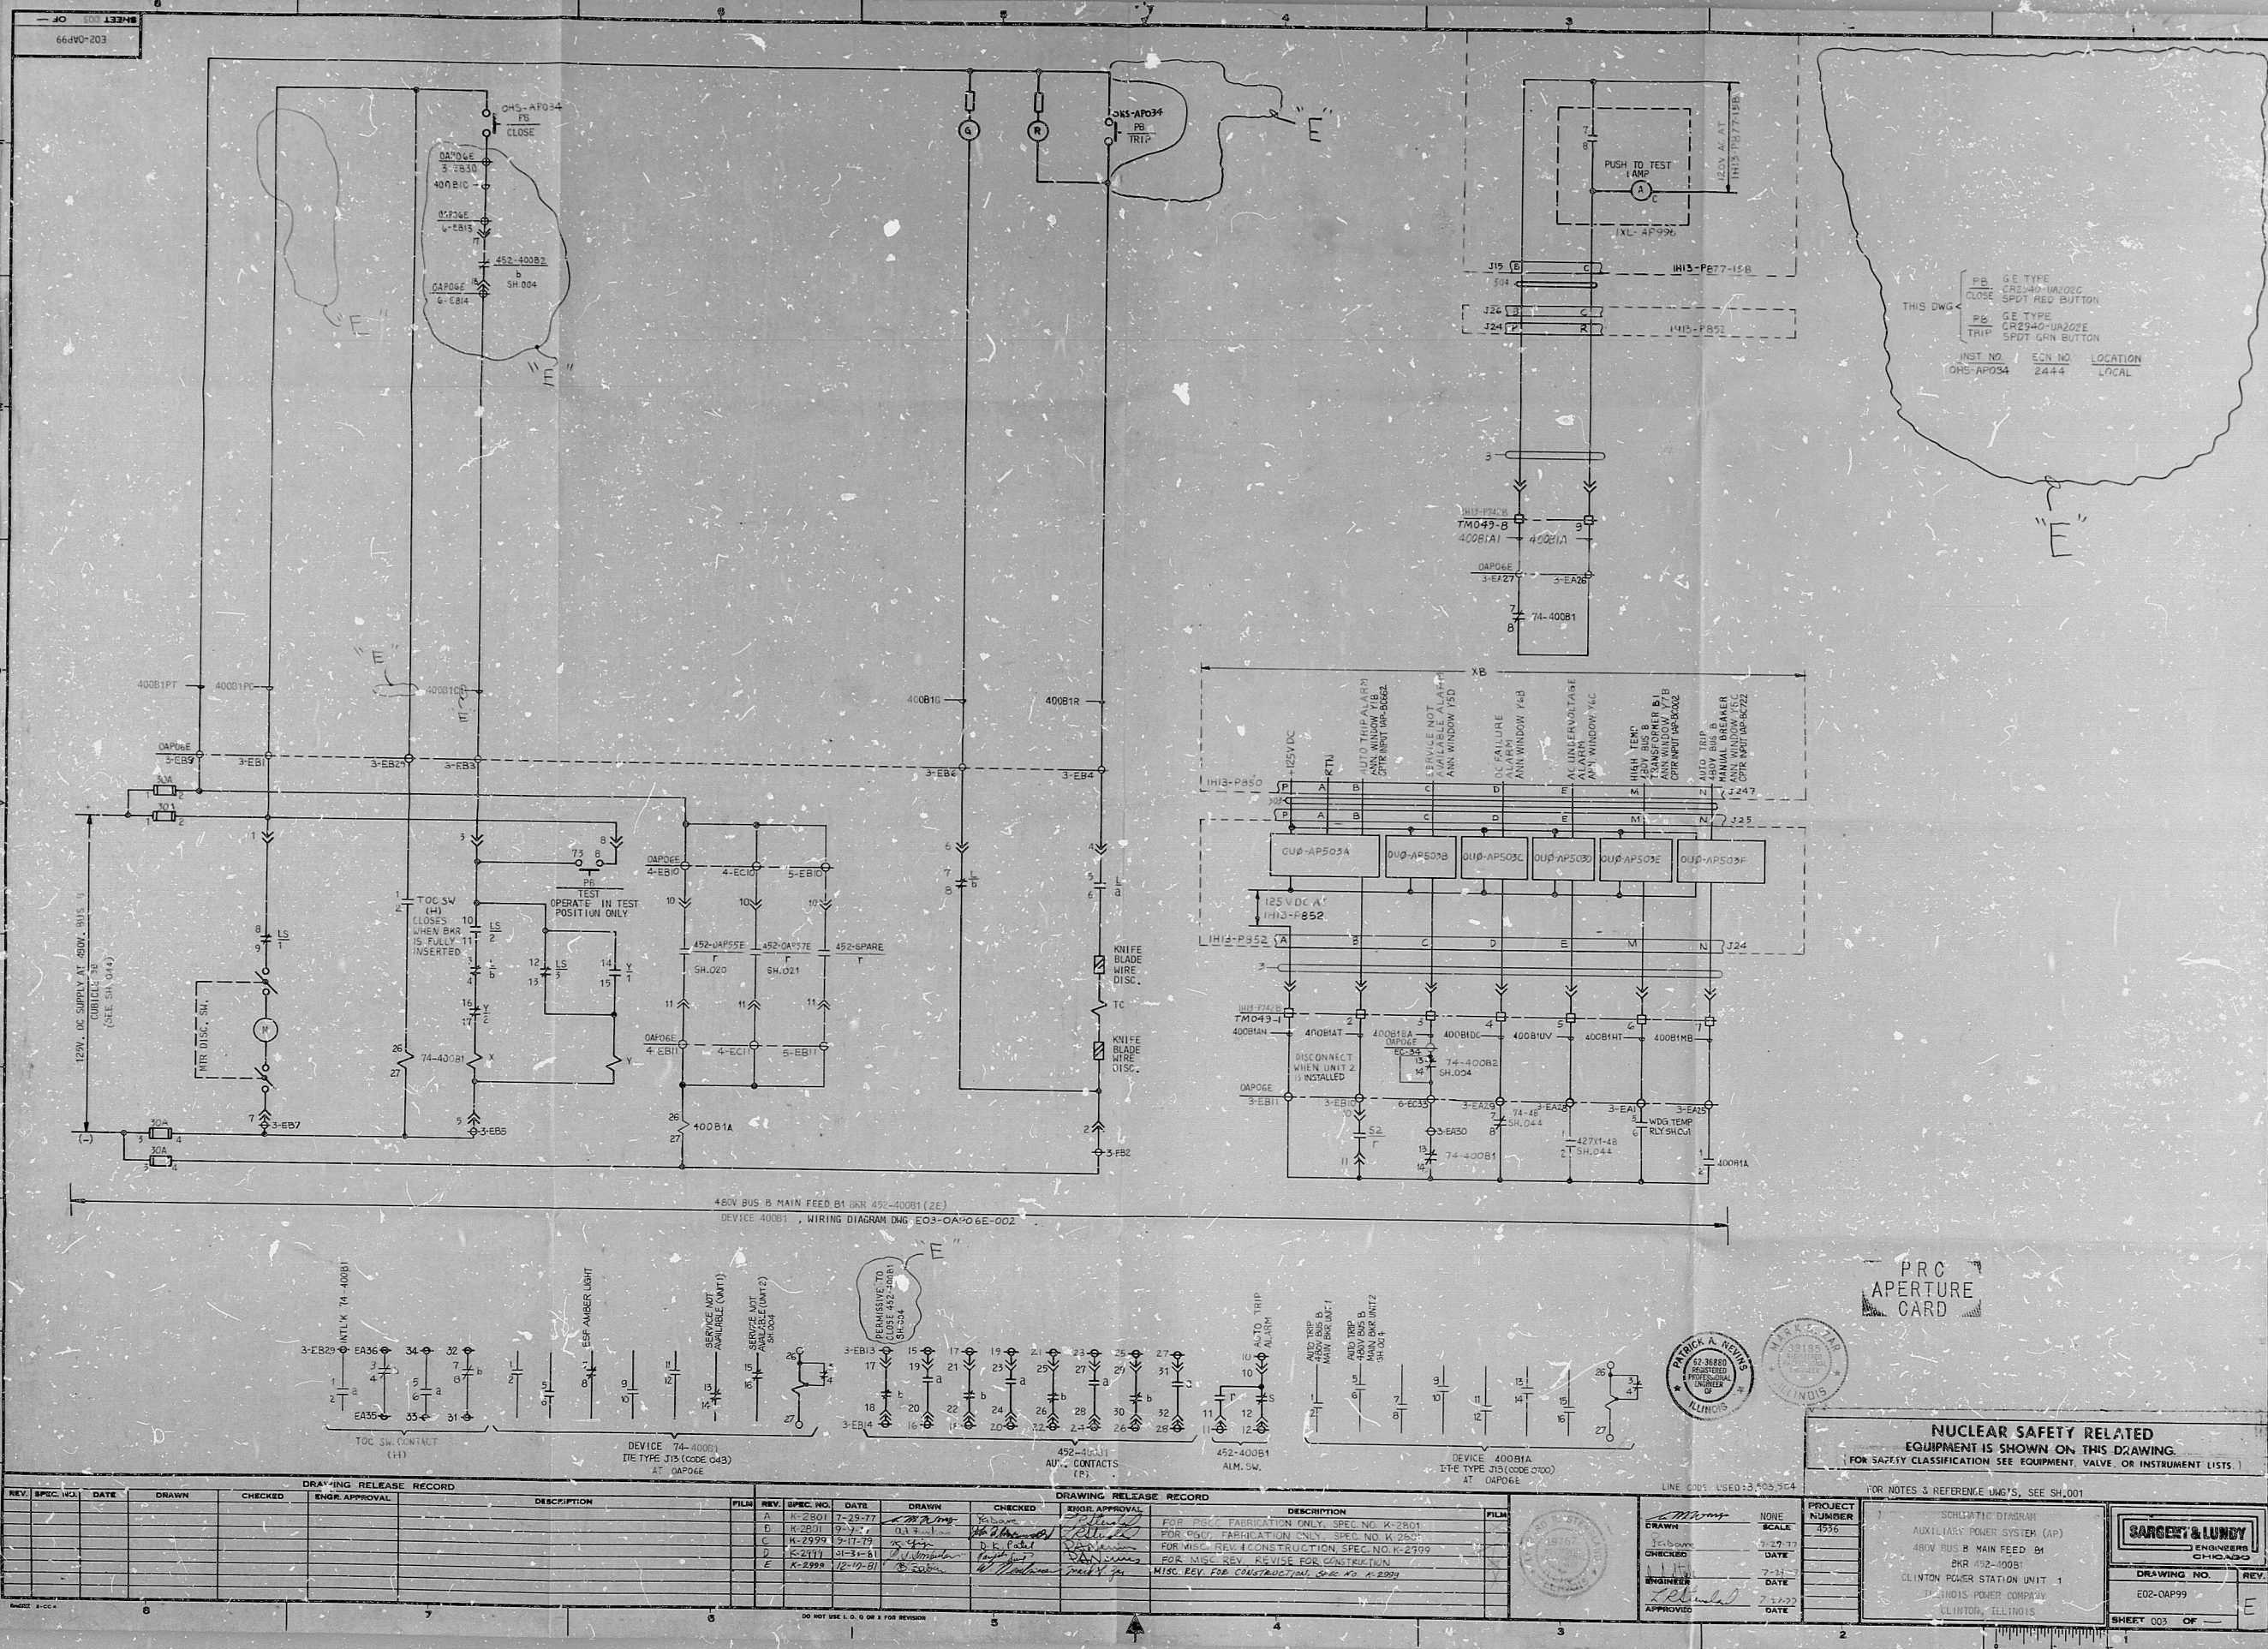

DRAWING RELEASE RECORD					DRAWING RELEASE RECORD				
REV.	SPEC. NO.	DATE	DRAWN	CHECKED	ENGR. APPROVAL	DESCRIPTION	FILM	REV.	SPEC. NO.


NUCLEAR SAFETY RELATED
EQUIPMENT IS SHOWN ON THIS DRAWING.
FOR SAFETY CLASSIFICATION SEE EQUIPMENT, VALVE, OR INSTRUMENT LISTS.

PROJECT NUMBER: 4556
DATE: 7-25-77
DRAWN: W. J. ...
CHECKED: ...
ENGR. APPROVAL: ...

CLINTON POWER STATION UNIT 1
CLINTON, ILLINOIS

DRAWING NO. E02-04P99
SHEET 003 OF 04

RIDS

820210589

