

CONTACTS	SYMBOL	DAMPER POSITION		
		FULL CLOSE	INTER-MEDIATE	FULL OPEN
A - O - P	O			X
C - O - D	OC	X	X	
E - O - F	EC	X	X	
G - O - H	OC			X
I - O - J	IO		X	X




X - DENOTES CONTACT CLOSED
 LIMIT SW. IN SCHEMATIC SHOWN WITH FULLY CLOSED POSITION
 NAMCO TYPE EA10-11502 & 12502

LIMIT SWITCH DEVELOPMENT (LS)
 TYPICAL FOR OVC105B, OVC097B, OVC067B (SH. 020), OVC037B (SH. 24)

CONTACTS AND LOCATION (HANDLE END)		BLOCK	POSITION
FRONT	BACK		
AA	TA	A	
BB	TC	B	X
CC	TD	C	
DD	TE	D	X
EE	TF	E	

X - DENOTES CONTACT CLOSED
 DOUBLE BLOCK G.E. CR2940
 MAINTAINED POSITION

SELECTOR SWITCH DEVELOPMENT FOR:
 DEVICE NO. INSTRUMENT NO. LOCATION
 45-VC197A 245-VC117 OZL-V-1178
 45-VC197B 45-VC118 OZL-V-1179
 45-VC197C 45-VC119 OZL-V-1180

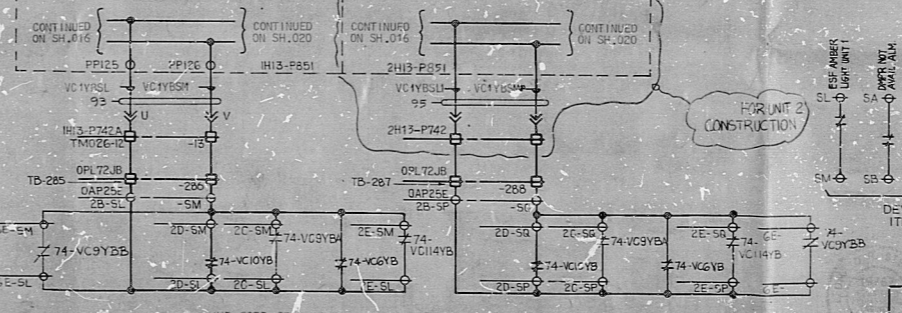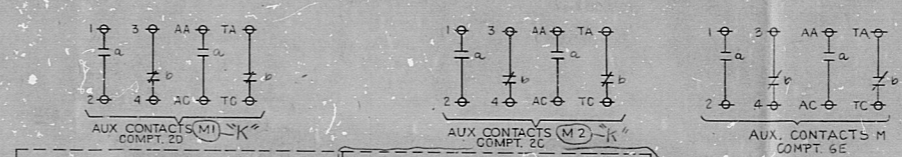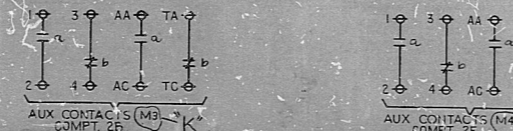

REV.	DATE	BY	CHKD.	DESCRIPTION
H	04-30-81	H. J. ...	A. ...	MISC. REV. FOR CONSTRUCTION SPEC. K-2293
J	01-15-82	H. J. ...	Y. ...	REVISED FOR CONSTRUCTION SPEC. K-2293 & PNL FAB. SPEC. K-2291
K	05-13-82	H. J. ...	S. ...	REVISED FOR CONSTRUCTION SPEC. K-2293
L	10-11-79	H. J. ...	H. ...	ISSUED PER IECN NO. 1278 DATED 10-11-79
M	12-26-79	H. J. ...	H. ...	DMR #1018 C11 ADDED, MISC. REV. FOR CONST. SPEC. K-2293 & PNL FAB. SPEC. K-2291

NUCLEAR SAFETY RELATED EQUIPMENT IS SHOWN ON THIS DRAWING.
 FOR SAFETY CLASSIFICATION SEE EQUIPMENT, VALVE, OR INSTRUMENT LISTS

SCHEMATIC DIAGRAM
 CONTROL ROOM HVAC SYSTEM (VC)
 CONTROL ROOM FILTER TRAIN & DAMPERS
 OVC105B, OVC097B, OVC067B & OVC1147B
 CLINTON POWER STATION UNIT 1
 ILLINOIS POWER COMPANY
 CLINTON, ILLINOIS

DATE: 02-23-81
 SHEET: 010 OF 010

RIDS

820220079

