
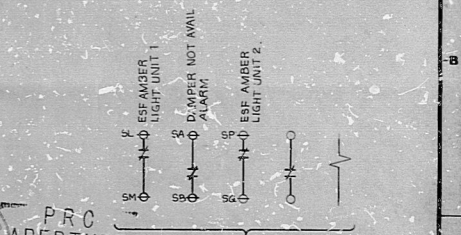
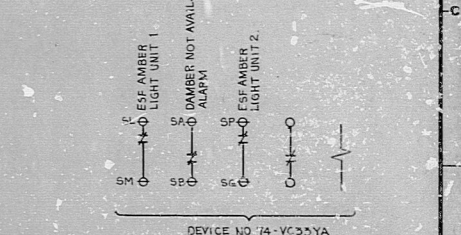
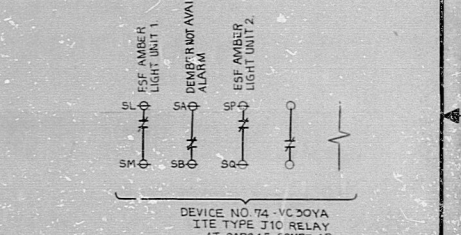
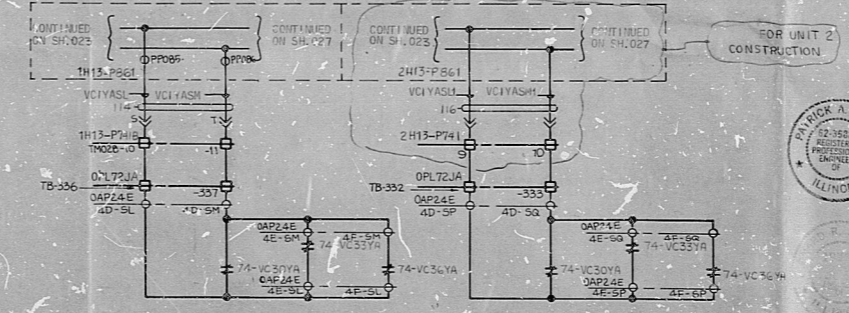
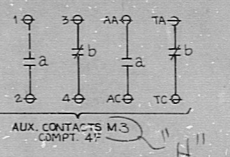
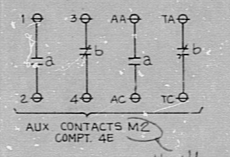


CONTACTS	SYMBOL	DAMPER POSITION		
		FULL CLOSE	INTER-MEDIATE	FULL OPEN
A — — B	IC	X	X	
C — — D	O			X
E — — F	O			X
G — — H	IC	X	X	
A — — B	C	X		
C — — D	IO		X	X
E — — F	IO		X	X
G — — H	C	X		

X - DENOTES CONTACT CLOSED  
 LIMIT SW. IN SCHEMATIC SHOWN WITH DAMPER IN FULLY CLOSED POSITION  
 NMCQ TYPE EATD-31302 & 32302

LIMIT SWITCH DEVELOPMENT (LS)  
 TYPICAL FOR: OVC30YA, OVC33YA & OVC36YA

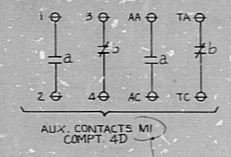


NUCLEAR SAFETY RELATED EQUIPMENT IS SHOWN ON THIS DRAWING.  
 (FOR SAFETY CLASSIFICATION SEE EQUIPMENT, VALVE, OR INSTRUMENT LISTS.)

SCHMATIC DIAGRAM  
 CONTROL ROOM HVAC SYSTEM (VC)  
 CONTROL ROOM SUPPLY AIR A ZONE & ISOLATION  
 DAMPERS OVC30YA, OVC33YA & OVC36YA  
 CLINTON POWER STATION UNIT 1  
 ILLINOIS POWER COMPANY  
 CLINTON, ILLINOIS

SCALE: NONE  
 PROJECT NUMBER: 4536

DRAWING NO. E02-OVC59  
 SHEET 025 OF 02

RID3

8210220099

