


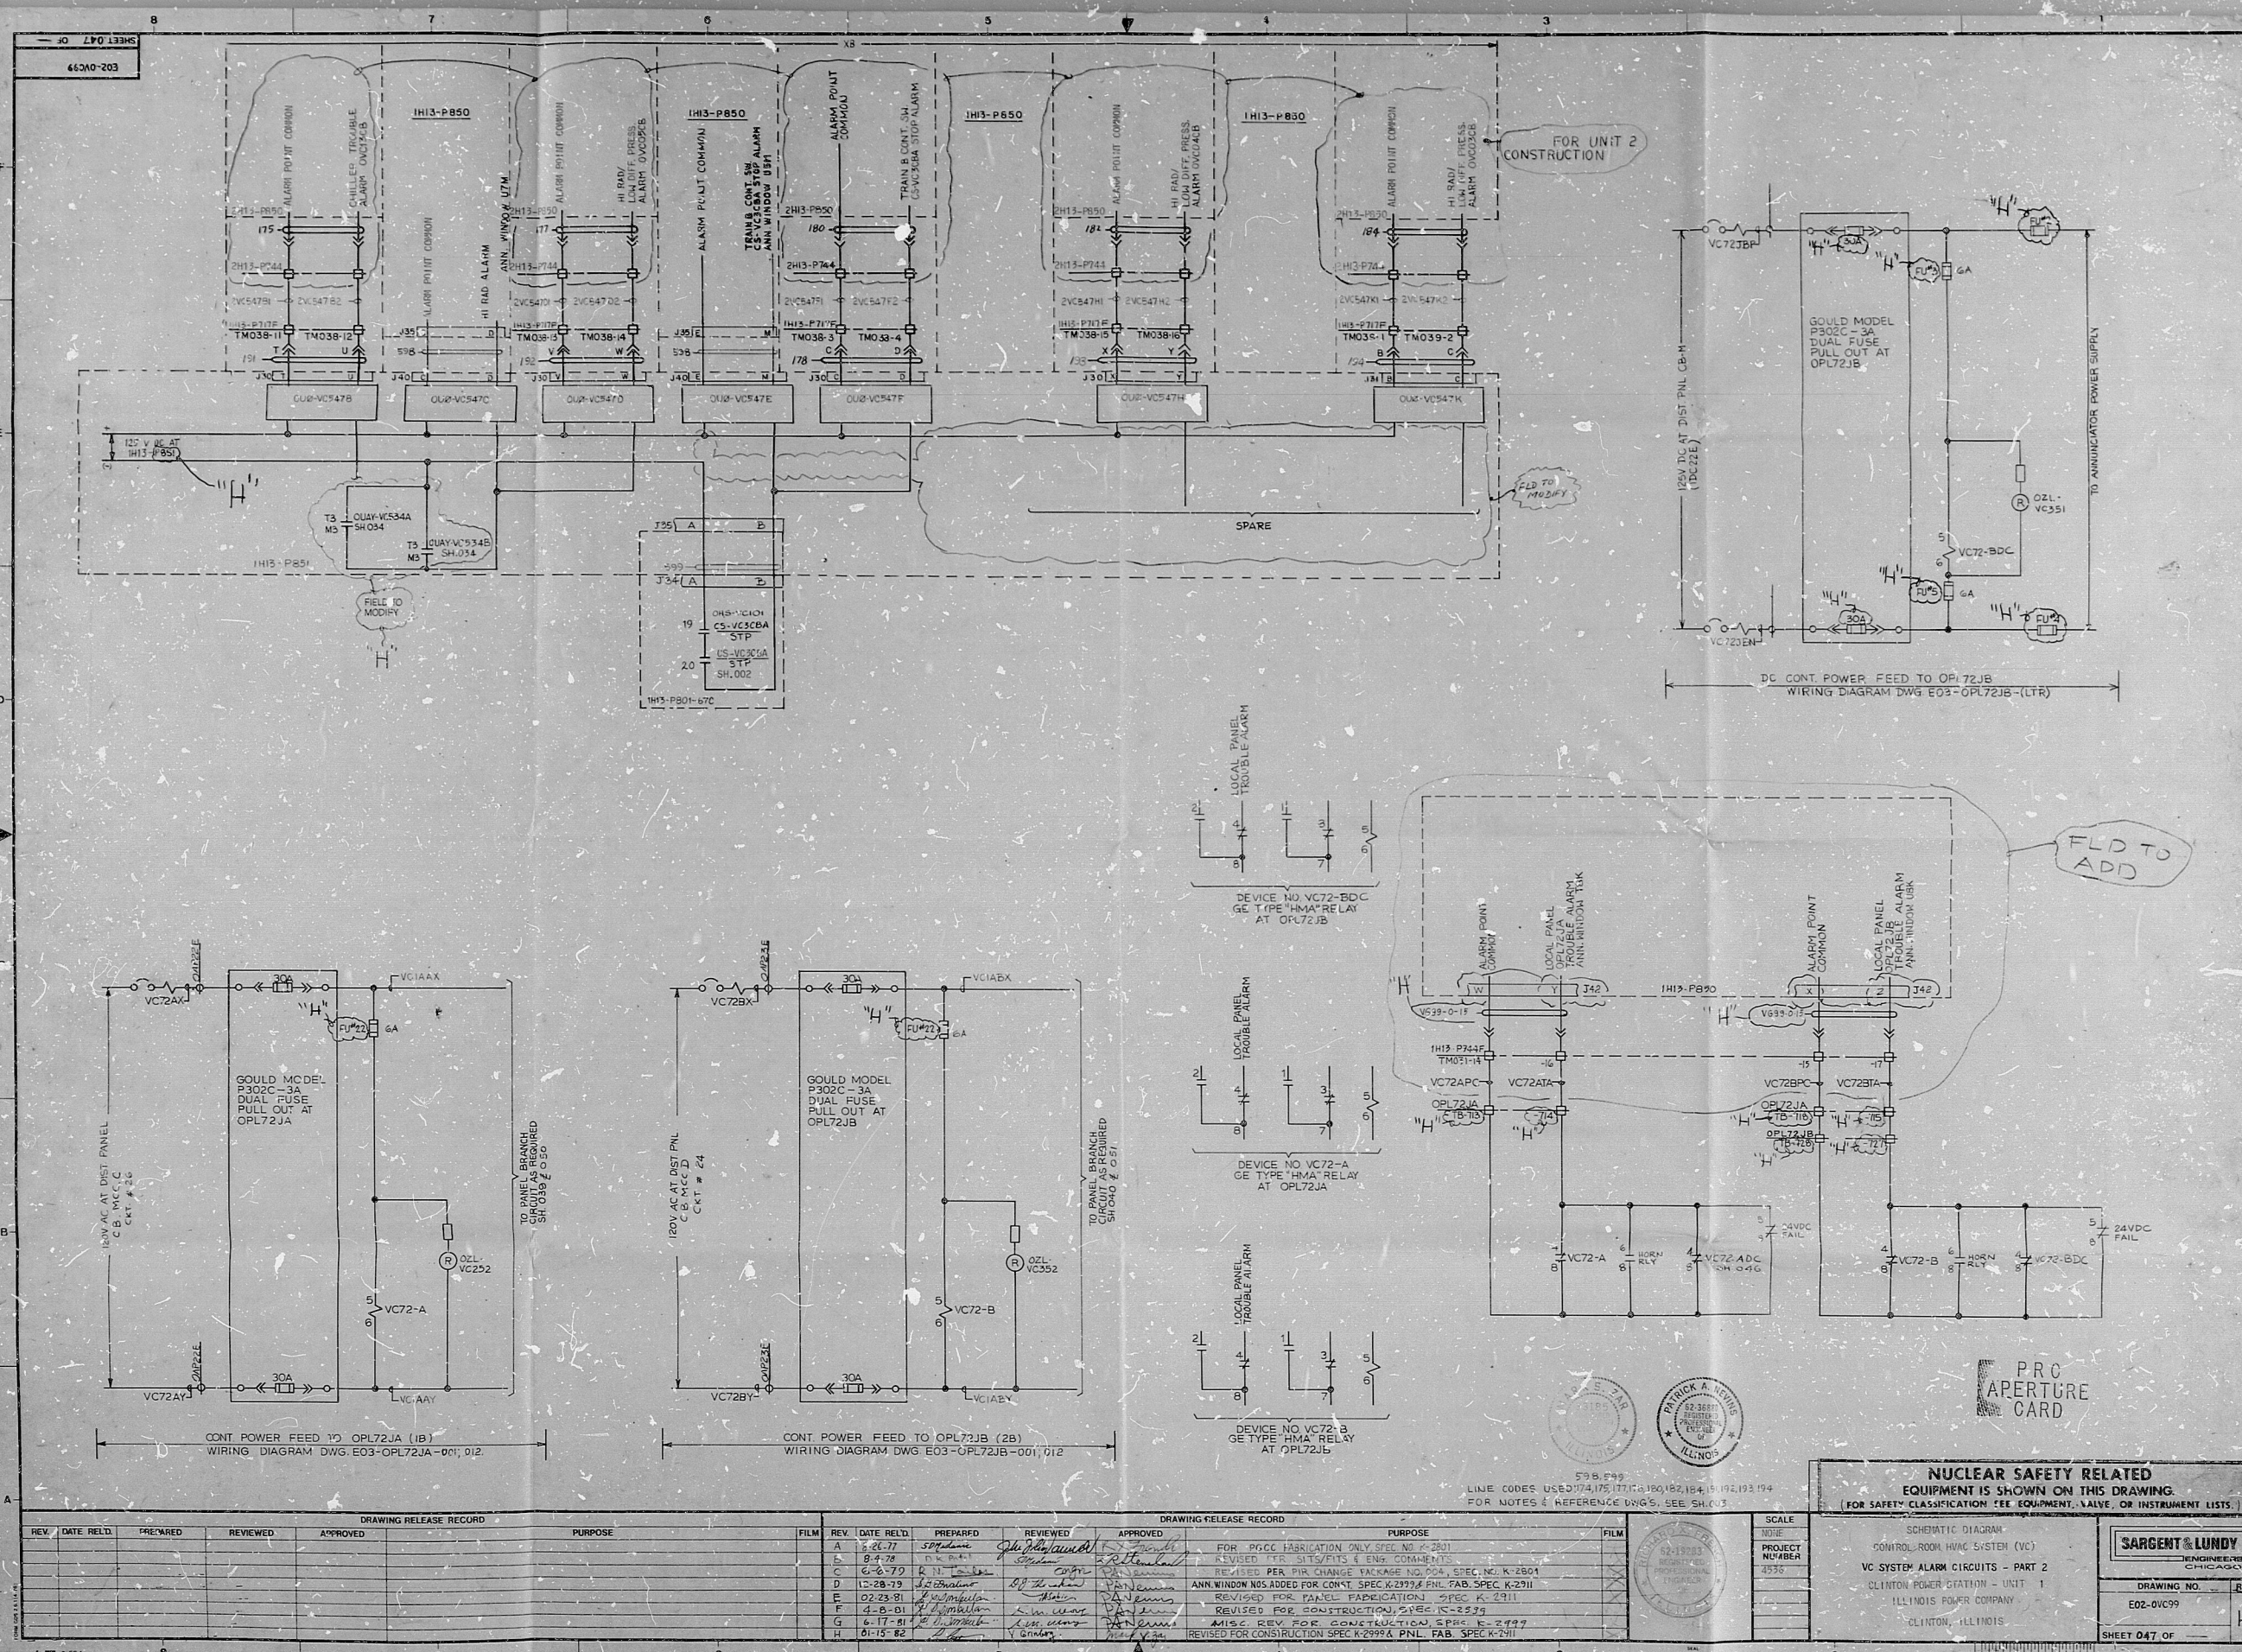

R113

8210220140

