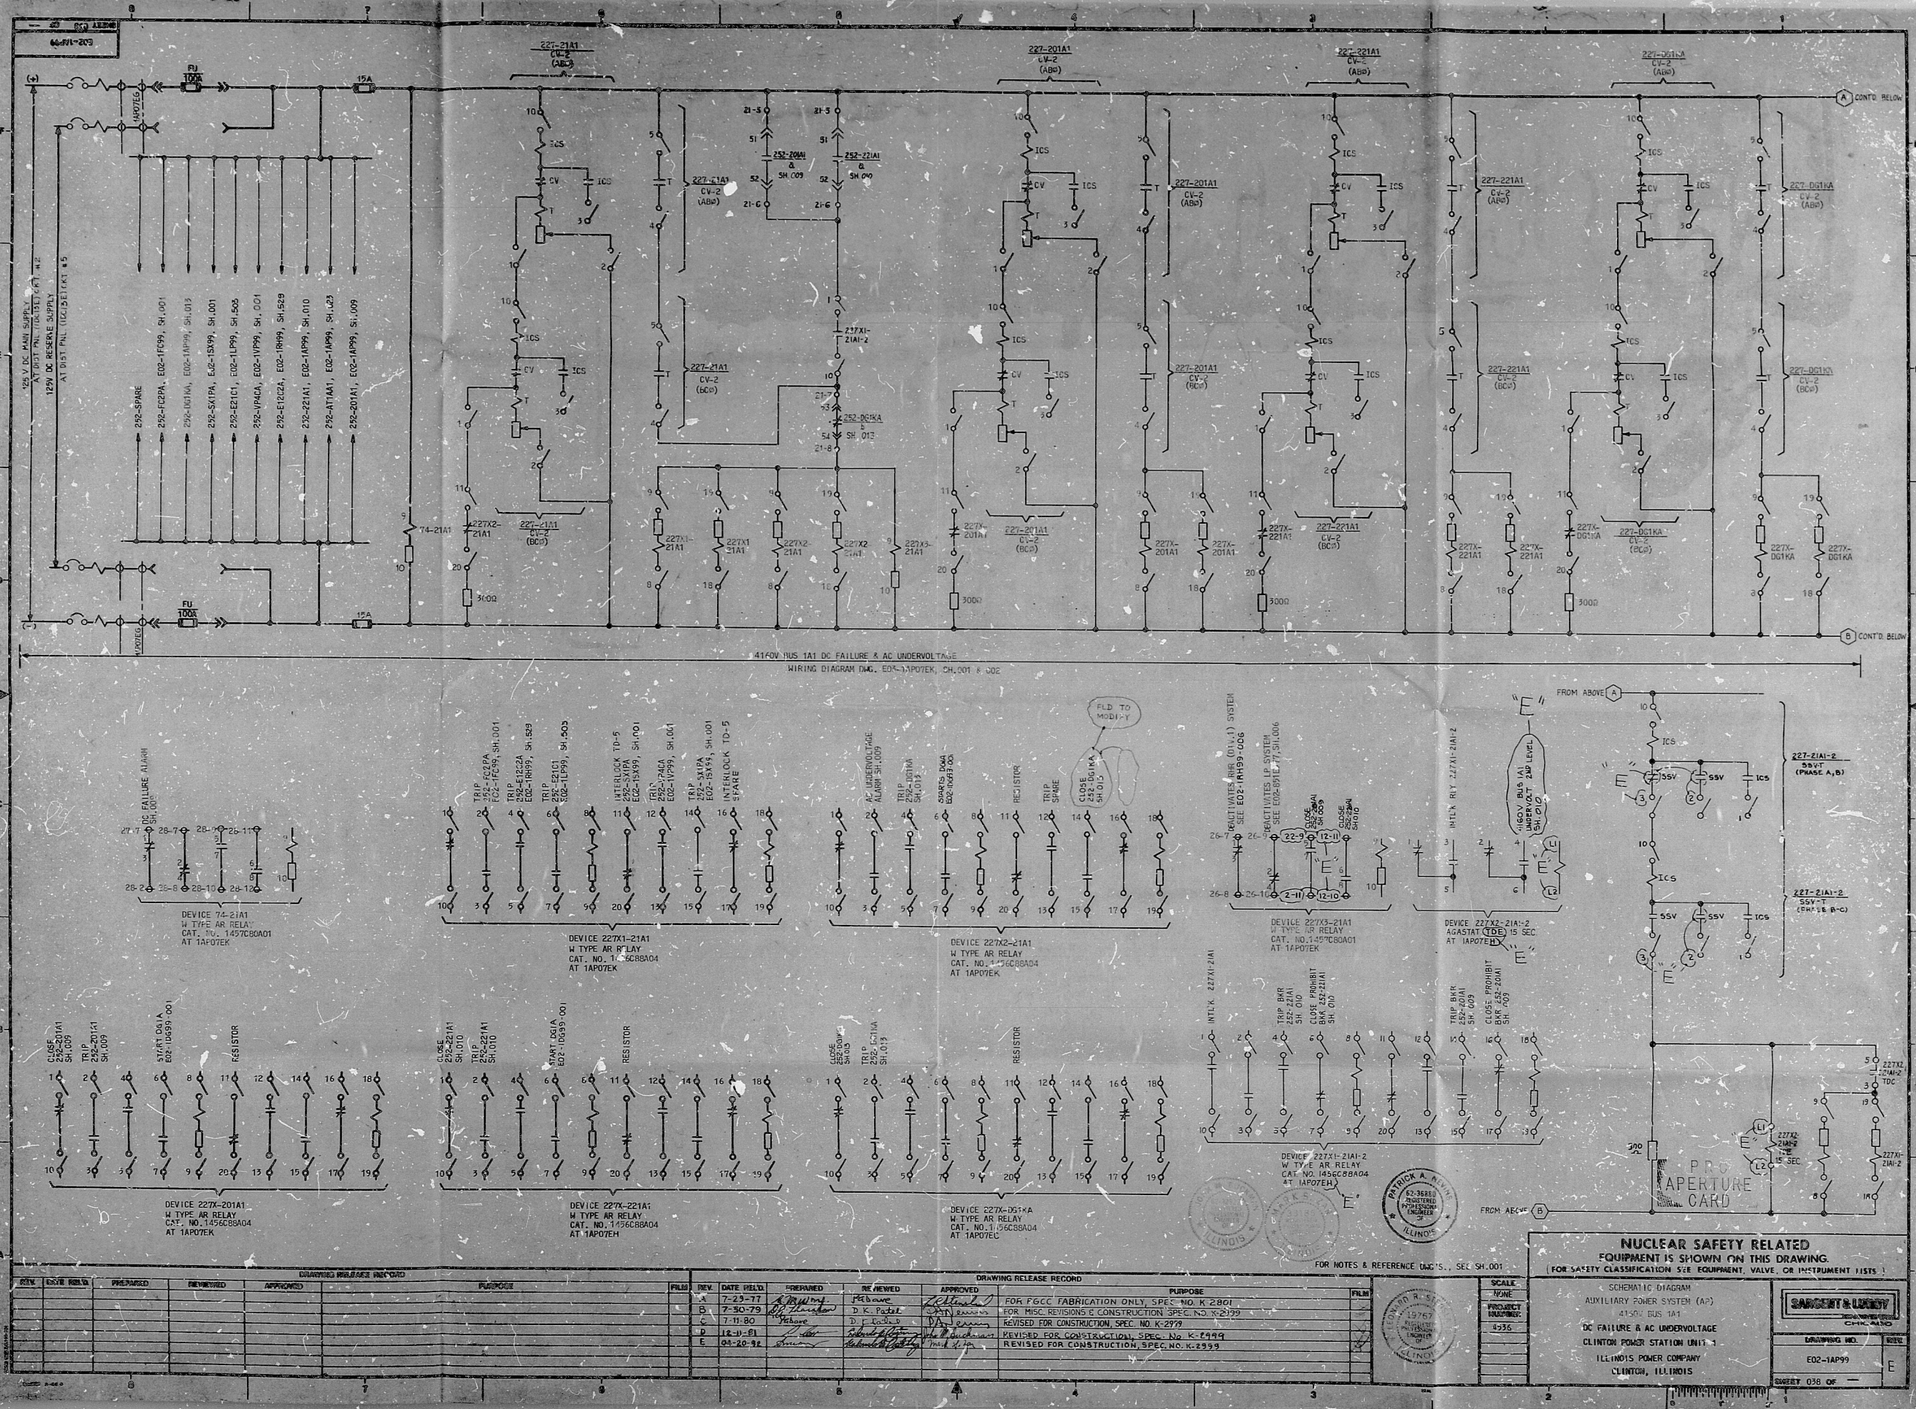

DRAWING RELEASE RECORD						
REV.	DATE ISSUED	PREPARED	REVIEWED	APPROVED	PURPOSE	FILM

DRAWING RELEASE RECORD						
REV.	DATE ISSUED	PREPARED	REVIEWED	APPROVED	PURPOSE	FILM
A	7-23-77				FOR FGCC FABRICATION ONLY, SPEC. NO. K-2801	
B	7-30-79		D. K. Porter		FOR MISC. REVISIONS & CONSTRUCTION, SPEC. NO. K-2199	
C	7-11-80				REVISED FOR CONSTRUCTION, SPEC. NO. K-2979	
D	12-11-81				REVISED FOR CONSTRUCTION, SPEC. No. K-2999	
E	01-20-82				REVISED FOR CONSTRUCTION, SPEC. NO. K-2999	

NUCLEAR SAFETY RELATED
EQUIPMENT IS SHOWN ON THIS DRAWING.
(FOR SAFETY CLASSIFICATION SEE EQUIPMENT, VALVE, OR INSTRUMENT LISTS.)

SCALE: NONE
PROJECT MAJ/MIN: 4-536

SCHEMATIC DIAGRAM
AUXILIARY POWER SYSTEM (AP)
4160 BUS 1A1
DC FAILURE & AC UNDERVOLTAGE
CLINTON POWER STATION UNIT 1
ILLINOIS POWER COMPANY
CLINTON, ILLINOIS

SARGENT & LUNDY ENGINEERS CHICAGO

DRAWING NO. E02-1AP99 REV. E
SHEET 038 OF —

RIDS

8802220522

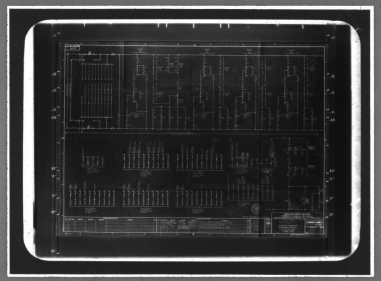

MMM 5824 — FILMSORT® Brand Aperture & Camera Cards and DUPLICARD® Brand Copy Cards — Product of 3M Company, St. Paul, Minn.