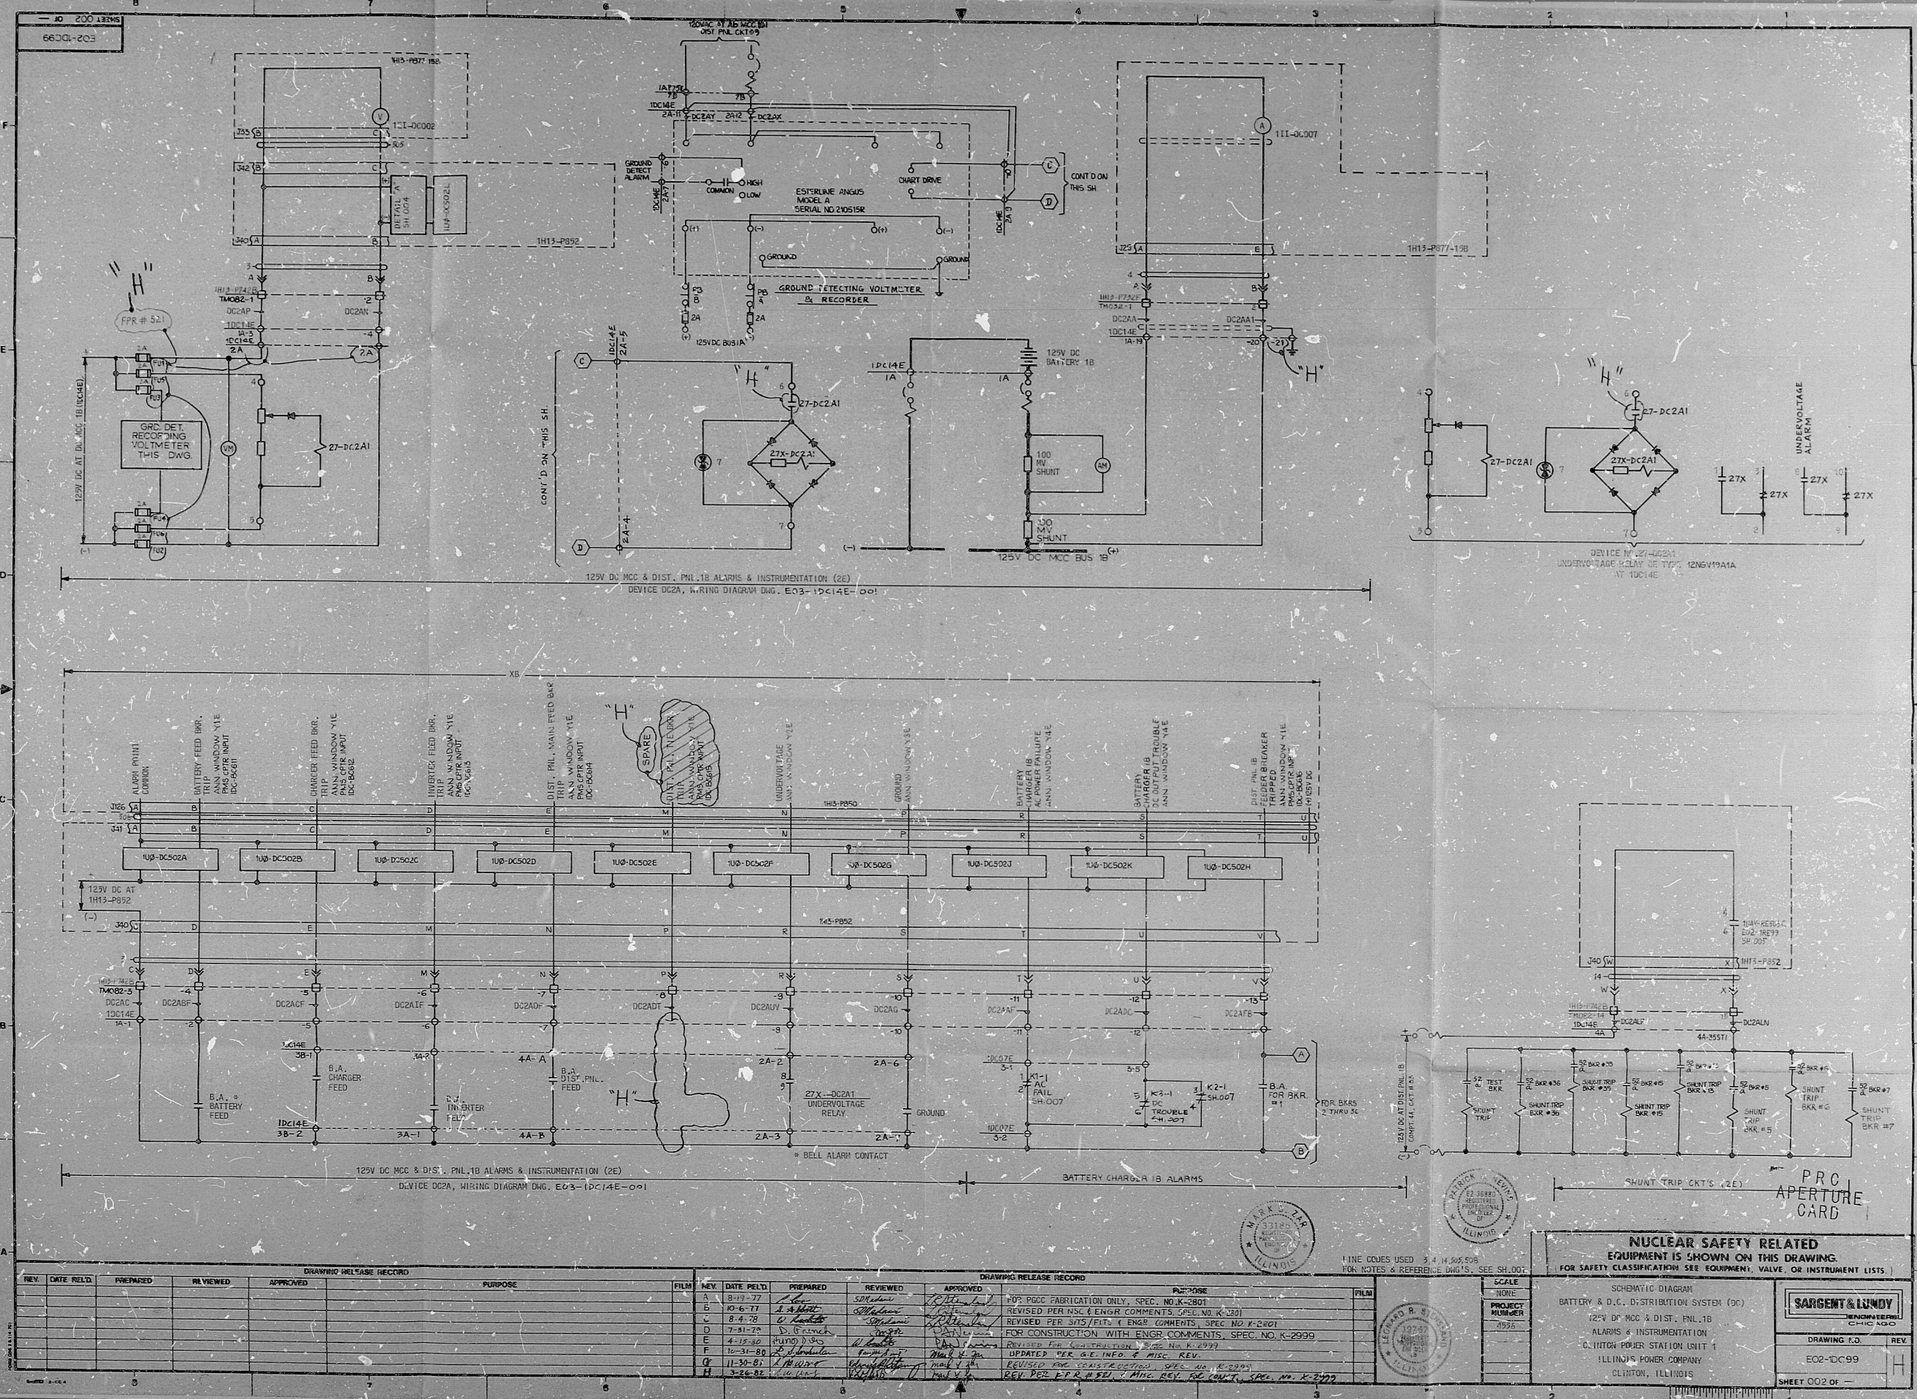
GRD. DET. RECORDING VOLTMETER THIS DWG.
GROUND DETECTING VOLTMETER & RECORDER
ESTERLINE ANGUS MODEL A SERIAL NO 210515R
125V DC MCC & DIST. PNL.1B ALARMS & INSTRUMENTATION (2E)
DEVICE DC2A, WIRING DIAGRAM DWG. E03-1DC14E-001
BATTERY CHARGER 1B ALARMS
SHUNT TRIP CKT'S (2E)
* BELL ALARM CONTACT
NUCLEAR SAFETY RELATED
EQUIPMENT IS SHOWN ON THIS DRAWING.
(FOR SAFETY CLASSIFICATION SEE EQUIPMENT, VALVE, OR INSTRUMENT LISTS.)
SCHEMATIC DIAGRAM
BATTERY & D.C. DISTRIBUTION SYSTEM (DC)
125V DC MCC & DIST. PNL.1B
ALARMS & INSTRUMENTATION
CLINTON POWER STATION, UNIT 1
ILLINOIS POWER COMPANY
CLINTON, ILLINOIS
SARGENT & LUNDY ENGINEERS CHICAGO
DRAWING NO. E02-1DC99
REV. H
SHEET 002 OF —
DRAWING RELEASE RECORD
PRC APERTURE CARD

RIDS

8210260027

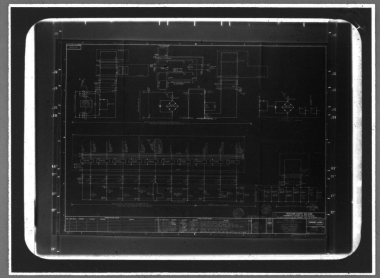

MMM 5824 — FILMSORT® Brand Aperture & Camera Cards and DUPLICARD® Brand Copy Cards — Product of 3M Company, St. Paul, Minn.