



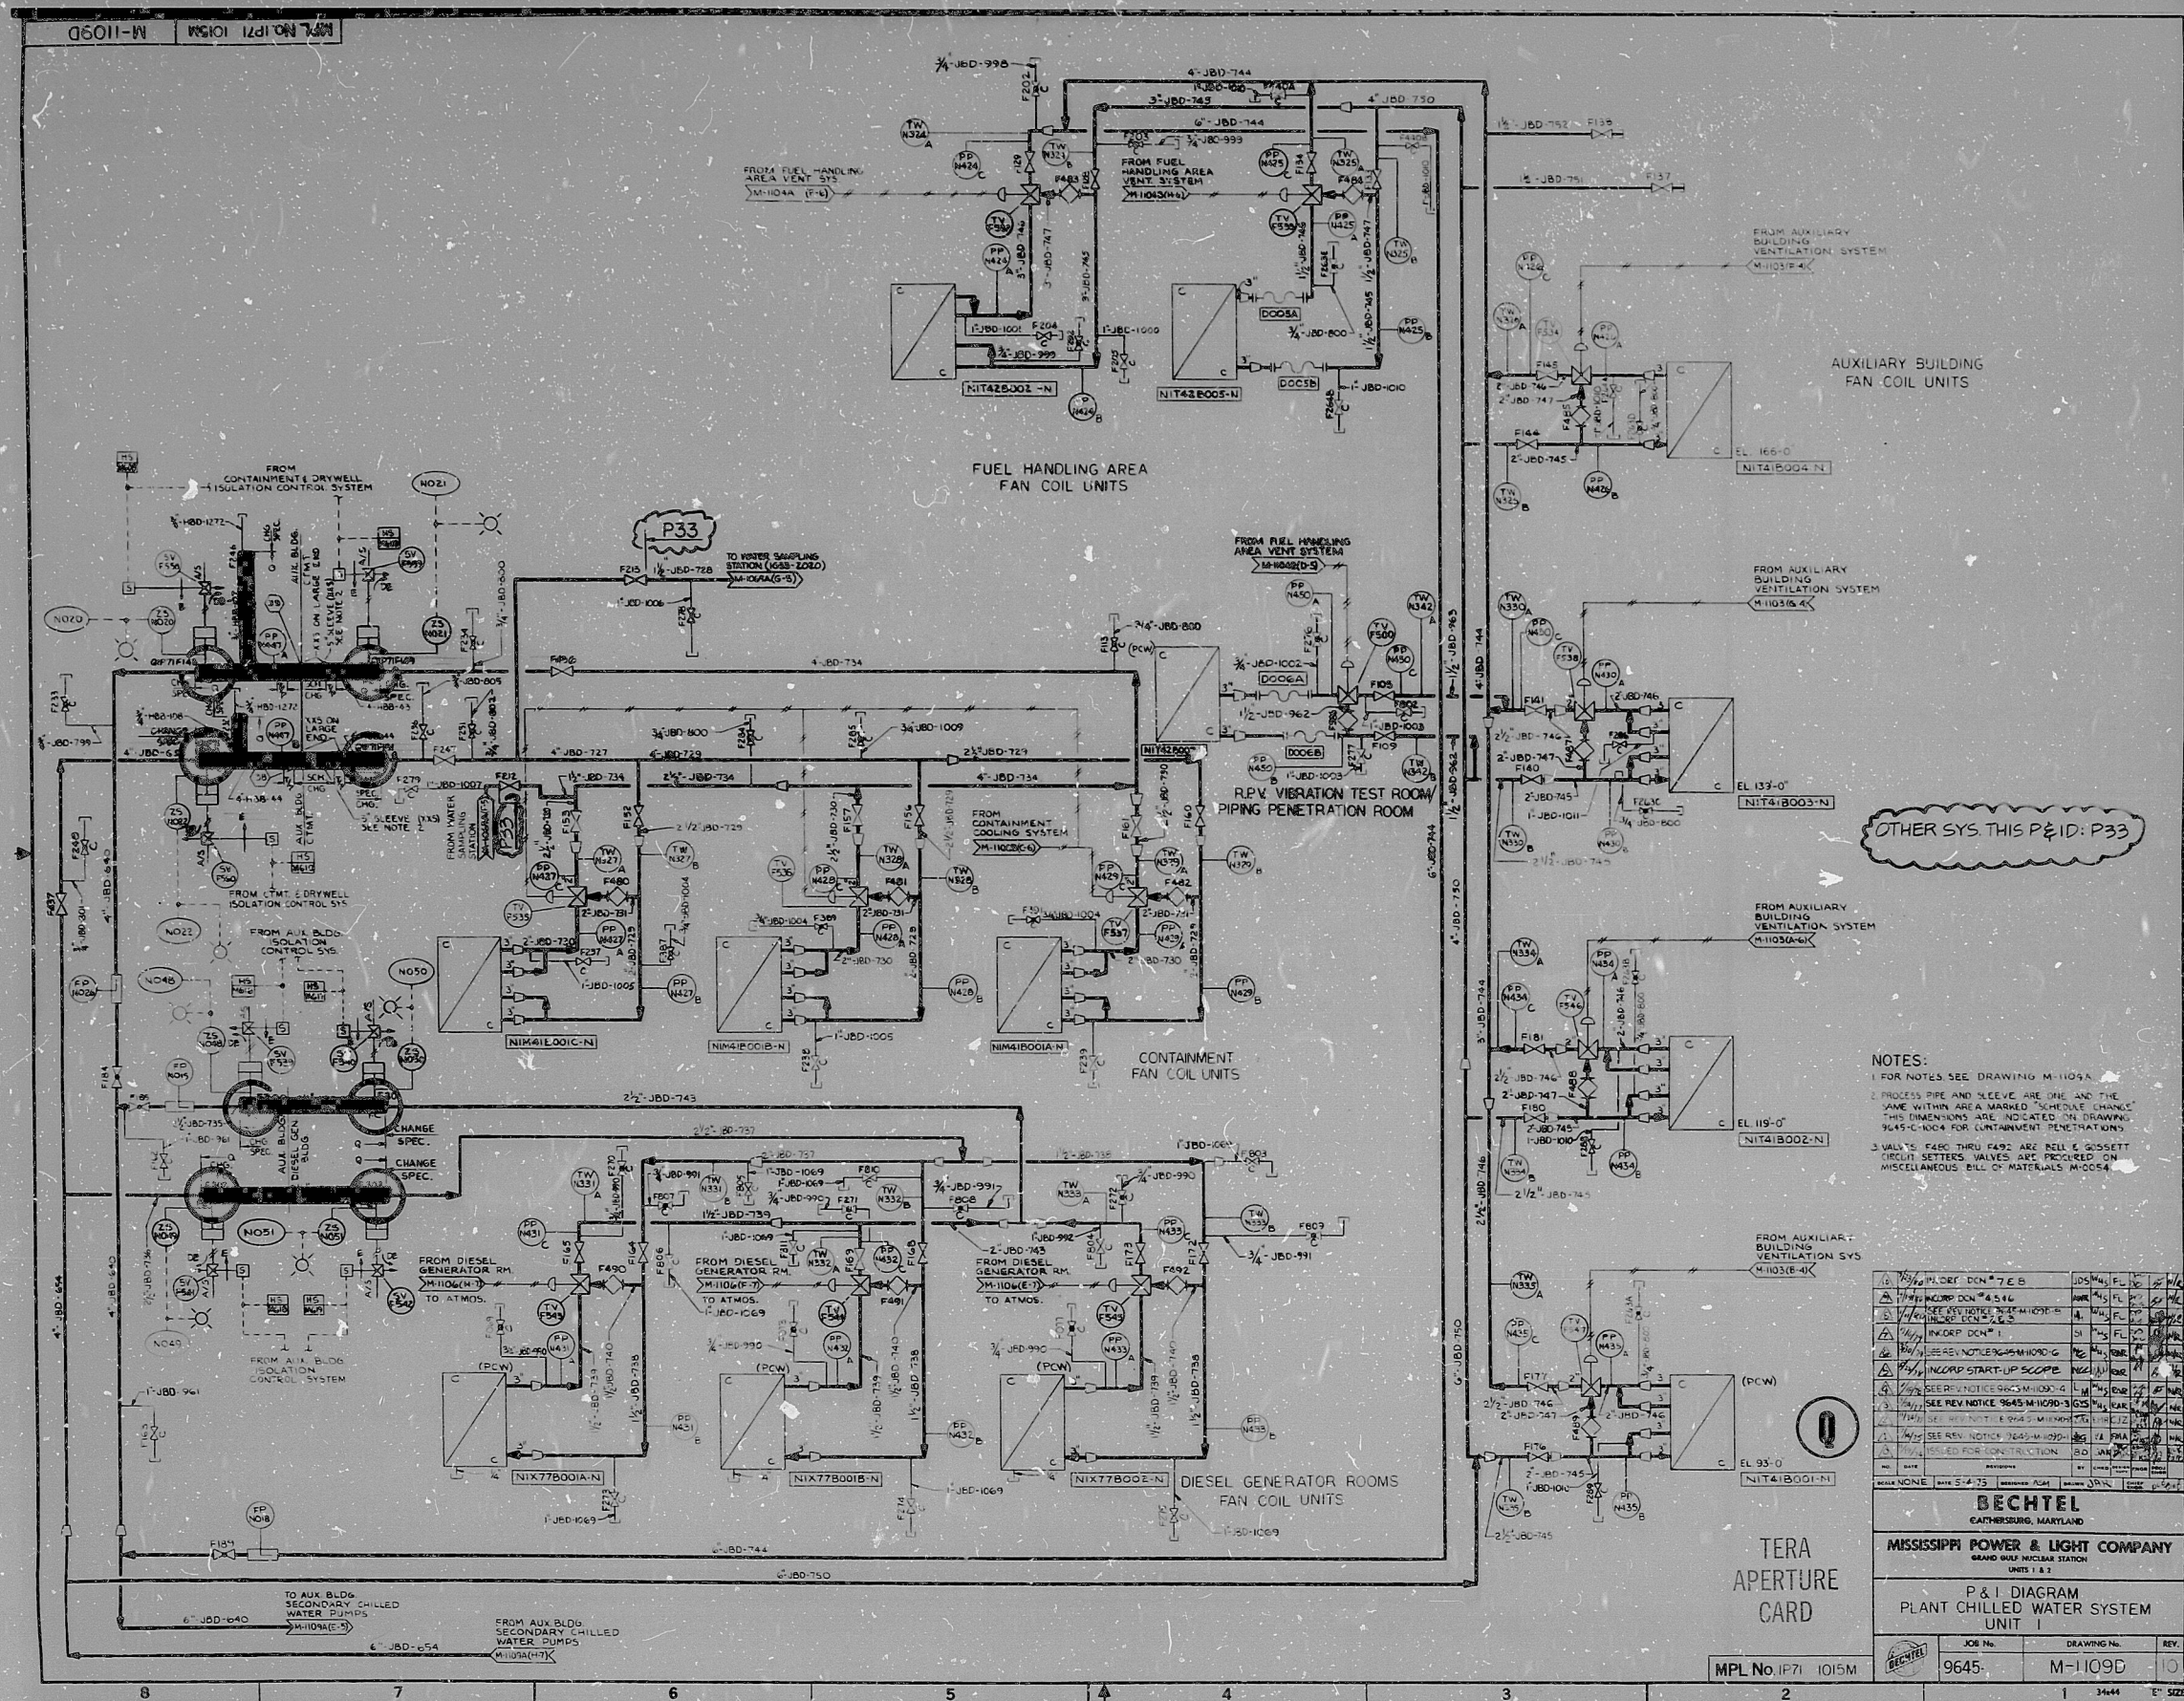

NO.	DESCRIPTION	DATE	BY	CHKD.
1	ISSUED FOR CONSTRUCTION	10/1/73	JAN	JAN

BECHTEL	
MISSISSIPPI POWER & LIGHT COMPANY	
UNITS 1 & 2	
P&I DIAGRAM	
PLANT CHILLED WATER SYSTEM	
UNIT 1	
NO.	DATE
9645	M-1109D
3444	1" SIZE

RIDS-PDR

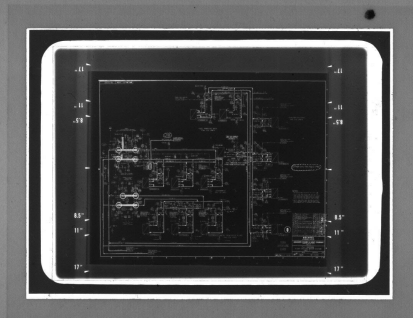

8104160818