


DIESEL GENERATOR 1A FCCC / REMOTE SHUTDOWN INTERFACE PART 1 (1E)
 DEVICE 10001A, WIRING DIAGRAM NO. E03-IP730E-001 & E03-IP741A-001

CONTACTS AND LOCATION (MAIN - END)		BLOCK SYMBOL	POSITIONS		SHEET NO.
FRONT	BACK		(NORMAL)	STOP	
A1	A2	A	N	X	003
B1	B2	B	N	X	001
B1	B2	B	N	X	003
B1	B2	B	N	X	001

X - DENOTES CONTACT CLOSED
 MOMENTARY CONTACT
 C.E. TYPE C1994D

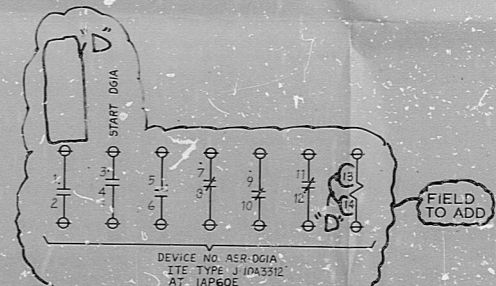

PRO APERTURE CARD

REV	DATE	RELD	PREPARED	REVIEWED	APPROVED	PURPOSE

REV	DATE	RELD	PREPARED	REVIEWED	APPROVED	PURPOSE
B	11-30-79		L. B. Dandrea			REDRAWN FOR CONSTRUCTION SPEC K-2999
C	11-26-80					REVISED PER VENDOR CHG. REV. & ENG. COMMENTS. SPEC NO. K-2999
D	9-2-81					WIDE REV. FOR CONSTRUCTION SPEC NO. K-2999

REV	DATE	RELD	PREPARED	REVIEWED	APPROVED	PURPOSE

LINE CODES USED: 3, 5, 7, 9, 21
 FOR NOTES & REFERENCE D-W'S SEE SH 002

NUCLEAR SAFETY RELATED EQUIPMENT IS SHOWN ON THIS DRAWING.
 FOR SAFETY CLASSIFICATION SEE EQUIPMENT, VALVE, OR INSTRUMENT LISTS

SCHEMATIC DIAGRAM
 DIESEL GENERATOR SYSTEM (DC)
 DIESEL GENERATOR 1A FCCC/RS INTERFACE
 PART 1
 CLIFTON POWER STATION UNIT 1
 ILLINOIS POWER COMPANY
 CLIFTON, ILLINOIS

SARGENT & LUNDY
 ENGINEERS
 CHICAGO

DRAWING NO. REV.
 E02-10699
 SHEET 001 OF 001

RIDS

8210260037

