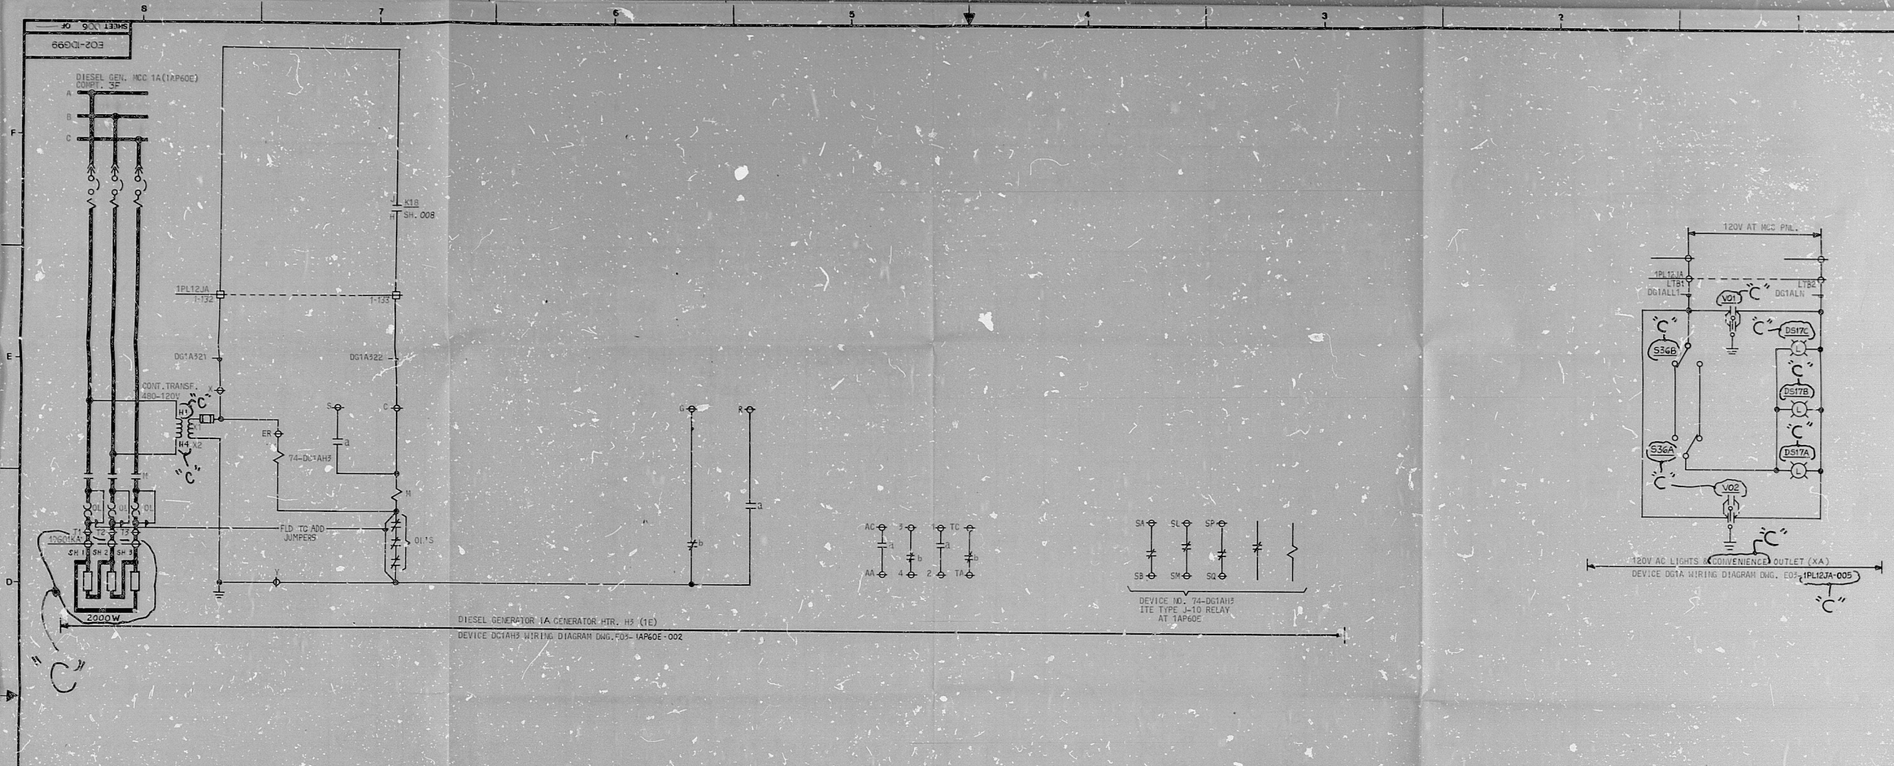

DRAWING RELEASE RECORD

REV.	DATE REL'D.	PREPARED	REVIEWED	APPROVED	PURPOSE	FI'M

DRAWING RELEASE RECORD

REV.	DATE REL'D.	PREPARED	REVIEWED	APPROVED	PURPOSE	FILM
A	11-30-79	L.B. Hopkins	S.M. Lee	Mark V. Lee	RELEASED FOR CONSTRUCTION SPEC. NO. K-2999	
B	11-26-80	"	P. Lee	Mark V. Lee	REVISED PER VENDORS DWG. REV. & ENGR. COMMENTS, SPEC. NO. K-2999	
C	9-2-81	R. Rivera	Lee Lee	Mark V. Lee	MISC. REV. FOR CONSTRUCTION SPEC. NO. K-2999	

MARK S. LEE
93185
REGISTERED
PROFESSIONAL
ENGINEER
ILLINOIS

SCALE: NONE
PROJECT NUMBER: 4536

FOR NOTES & REFERENCE DWG'S SEE SH 002

REDRAWN FROM STEWART & STEVENSON SERVICES
DWG. NO. 670 4 SH.001 REV.B

NUCLEAR SAFETY RELATED
EQUIPMENT IS SHOWN ON THIS DRAWING.
FOR SAFETY CLASSIFICATION SEE EQUIPMENT, VALVE, OR INSTRUMENT LISTS.

SCHEMATIC DIAGRAM
DIESEL GENERATOR SYSTEM (DG)
DIESEL GENERATOR 1A
GENERATOR HEATER H3
CLINTON POWER STATION UNIT 1
ILLINOIS POWER COMPANY
CLINTON, ILLINOIS

SARGENT & LUNDY ENGINEERS CHICAGO

DRAWING NO. E02-1DG99 REV. C

SHEET 006 OF

PRO APERTURE CARD

RCL-78

RIDS

8210260043

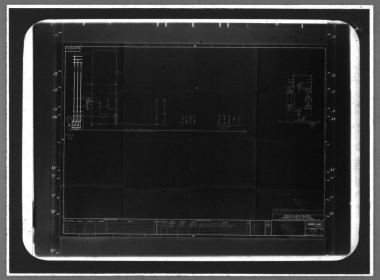

MMM 5824 — FILMSORT® Brand Aperture & Camera Cards and DUPLICARD® Brand Copy Cards — Product of 3M Company, St. Paul, Minn.