


NOTES:
FOR SUPPORT INFORMATION SEE REFERENCE MSK DWG

REFERENCE DWGS:
 P105
 11825-FM-25B-11, 11825-FM-25B-12
 SUPPLY LOCATION DWGS
 MIX FF-67A, MIX FF-67C
 REL.ONG ISOMETRICS
 TITZ. SYSTEM CS, CHT (CS)
 SPOOL SHEETS

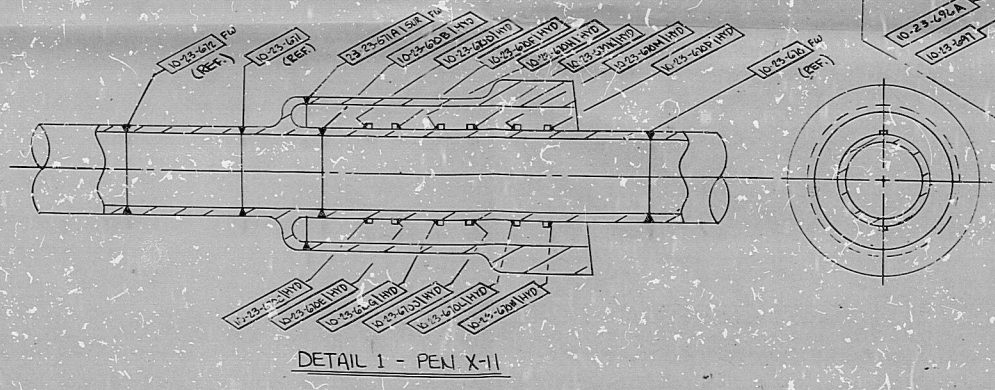

NO.	DATE	DESCRIPTION	BY	CHKD.
3	10/1/68	COMPLETION OF THIS REVISION	LL	CS
2	10/1/68	REVISION FOR MSK	LL	CS
1	10/1/68	ISSUE BULLETIN 79-22/07/19	LL	CS
0	10/1/68	ISSUED FOR IS ONLY	LL	CS
Me. Date		Revised by		
Scale	As Designed	Drawn by	LL	CS

GENERAL PHYSICS CORPORATION
 COLUMBIA, MARYLAND

SYSTEM No.
 ISI SYS-23

JAMES A. FITZPATRICK NUCLEAR POWER PLANT
 POWER AUTHORITY OF THE STATE OF NEW YORK

PUMP ROOMS
HPCI SYSTEM

Contract No. **41E0007** Drawing No. **B6**

THIS DRAWING CONTAINS LINES:
 10' SHIP-902-19A, 10' SHIP-902-19
 10' SHIP-902-24

TT
 APERTURE
 CARJ

PDR

85L0290557

