14.5X

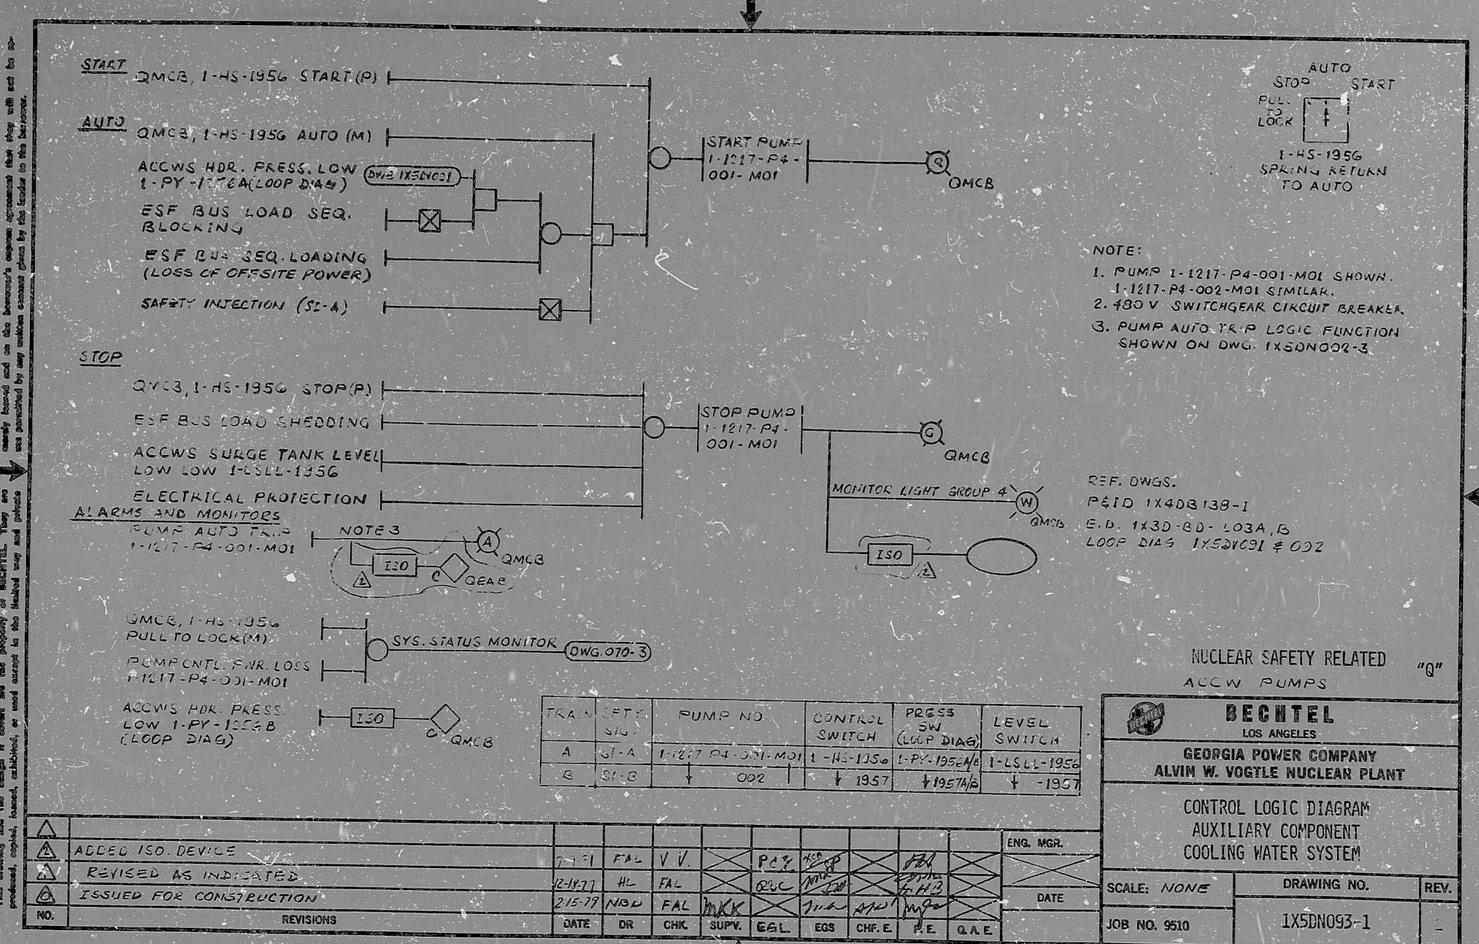


NUCLEAR SAFETY RELATED "Q"
ACCW PUMPS

NO.	REVISIONS	DATE	DR	CHK.	SUPV.	EGL	EGS	CHF. E.	P.E.	Q.A.E.	ENG. MGR.
0	ISSUED FOR CONSTRUCTION	2-15-79	NBD	FAL	MKK						

BECHTEL
LOS ANGELES
GEORGIA POWER COMPANY
ALVIN W. VOGTLE NUCLEAR PLANT
CONTROL LOGIC DIAGRAM
AUXILIARY COMPONENT
COOLING WATER SYSTEM

SCALE: NONE	DRAWING NO.	REV.
JOB NO. 9510	1X5DN093-1	-

SIZE B 11 x 17

This drawing and the design it covers are the property of BECHTEL. They are not to be used in connection with any work or project except that for which they were produced, copied, loaned, exhibited, or used except by the Bechtel corp and parties duly authorized and to the extent specifically authorized by the Bechtel corp. Any such use not specifically authorized by the Bechtel corp is prohibited and the Bechtel corp assumes no responsibility and shall be held harmless for any such use.

I CERTIFY THAT THE IMAGE CONTAINED ON THIS FRAME WAS MADE IN THE NORMAL AND REGULAR COURSE OF BUSINESS, ON THE DATE STATED BELOW AND THAT IT IS AN ACCURATE REPRODUCTION OF THE DOCUMENT SUBMITTED TO MICROGRAPHICS.
DATE: 7-13-81 CAMERA OPERATOR Richard L. Turner SECTION SUPERVISOR Frances Jacobs
LAO-2501 8/79

I CERTIFY THAT THE IMAGE CONTAINED ON THIS FRAME WAS MADE IN THE NORMAL AND REGULAR COURSE OF BUSINESS, ON THE DATE STATED BELOW AND THAT IT IS AN ACCURATE REPRODUCTION OF THE DOCUMENT SUBMITTED TO MICROGRAPHICS.
DATE: 7-13-81 CAMERA OPERATOR Richard L. Turner SECTION SUPERVISOR Frances Jacobs
LAO-2501 8/79

PRC APERTURE CARD

RIDS

8309280179

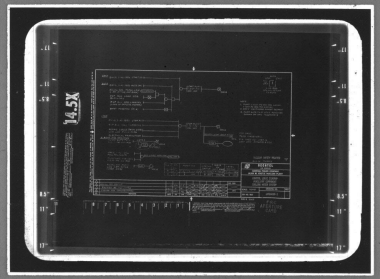

MMM 5824 — FILMSORT® Brand Aperture & Camera Cards and DUPLICARD® Brand Copy Cards — Product of 3M Company, St. Paul, Minn.