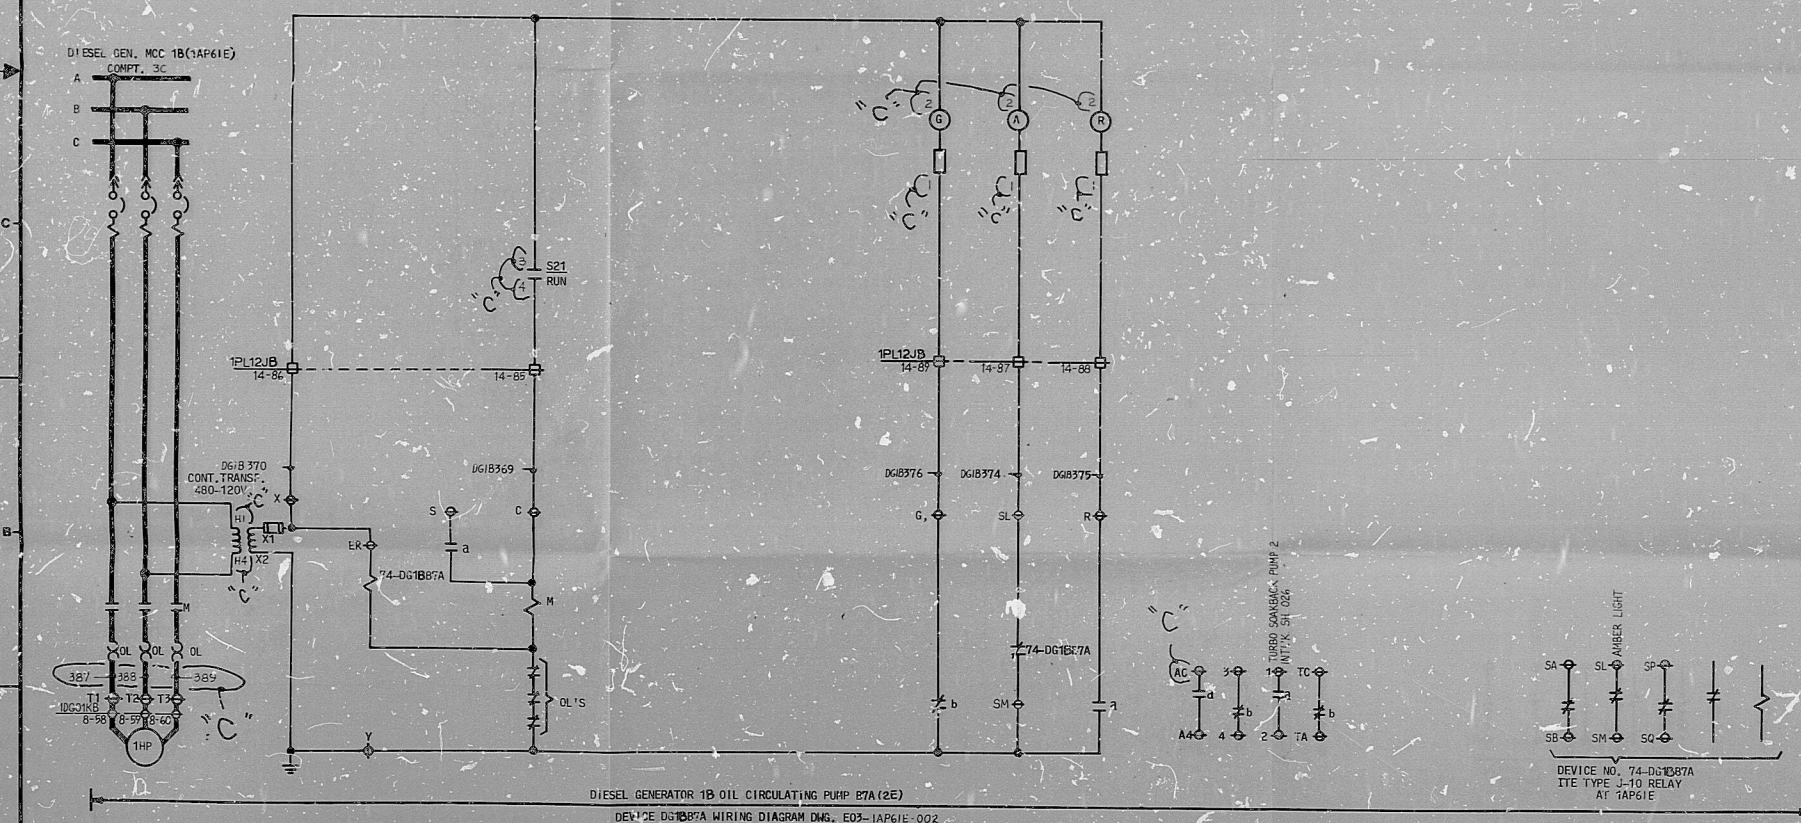


[illegible]

FOR NOTES & REFERENCE DRAWINGS SEE SH 002

REDRAWN FROM STEWART AND STEVENSON SERVICES DWG. NO. 6104 SH 001 & 002 REV. B
--

NUCLEAR SAFETY RELATED
EQUIPMENT IS SHOWN ON THIS DRAWING.
(FOR SAFETY CLASSIFICATION SEE EQUIPMENT VALVE OR INSTRUMENT :ISTS

SCHEMATIC DIAGRAM
DIESEL GENERATOR SYSTEM (DG)
DIESEL GENERATOR 1B OIL CIRC. PUMP B7 & B7A
CLINTON POWER STATION UNIT 1
ILLINOIS POWER COMPANY
CLINTON, ILLINOIS

SARGENT & LUNDY
ENGINEERS
CHICAGO

DRAY/ING NO.	
EO2-1DG99	

SHEET 021 OF ———

RIDS

9
8210260058

