


This drawing and the design it covers are the property of BECHTEL. They are hereby loaned and used as the licensee's express agreement that they will not be reproduced, copied, modified, or used in any way without the express written consent of the licensor.

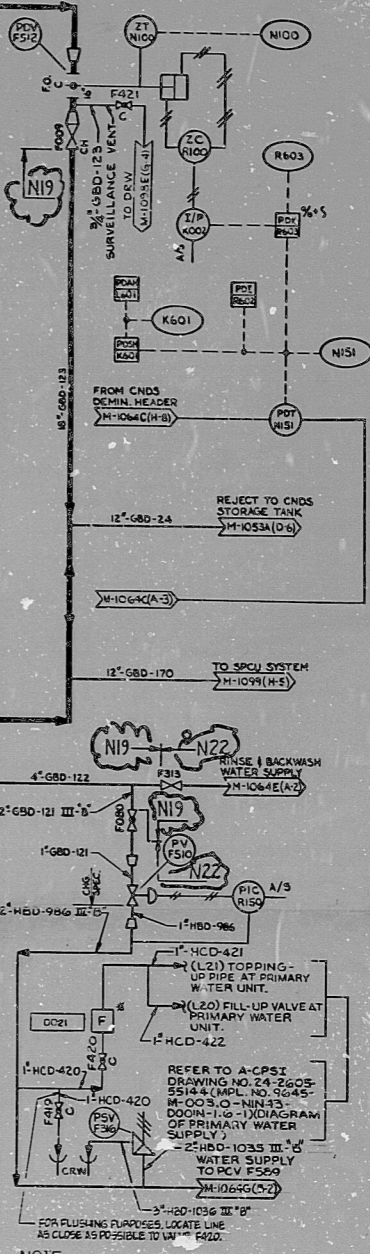

NOTE  
1. FOR NOTES SEE DRAWING M-1064C

OTHER SYS. THIS P & ID: N19  
PRIMARY WATER LINES: HCD-100, HCD-101, HCD-102, NO.	DESCRIPTION	DATE	BY	CHECKED
1	INCORP. START-UP SCOPE	10/11/77	J. K.	P. S.
2	THIS DWG SUPERSEDES DWG M-1064C, REV. 3, DATED 3/10/76, ISSUED TO INCORP. VENDORS' BLACK BOX INFO. AND ALSO APPLICABLE INFO. PREVIOUSLY SHOWN ON M-1064C, REV. 4.	10/11/77	J. K.	P. S.

**BECHTEL**  

**MISSISSIPPI POWER & LIGHT COMPANY**  
GRAND GULF NUCLEAR STATION  
UNIT 1 & 2

**P & I DIAGRAM**  
**CONDENSATE CLEANUP SYSTEM**  
**(CONDENSATE DEMINERALIZERS) UNIT 1**

JOB No. 9645-  
DRAWING No. M-1064D  
6


30X

8105010458

APERTURE CARD

RIDS-PDR

8105010458

