


34"  
22"  
17"  
11"  
8.5"  
8.5"  
11"  
17"  
22"  
34"

34"  
22"  
17"  
11"  
8.5"  
8.5"  
11"  
17"  
22"  
34"

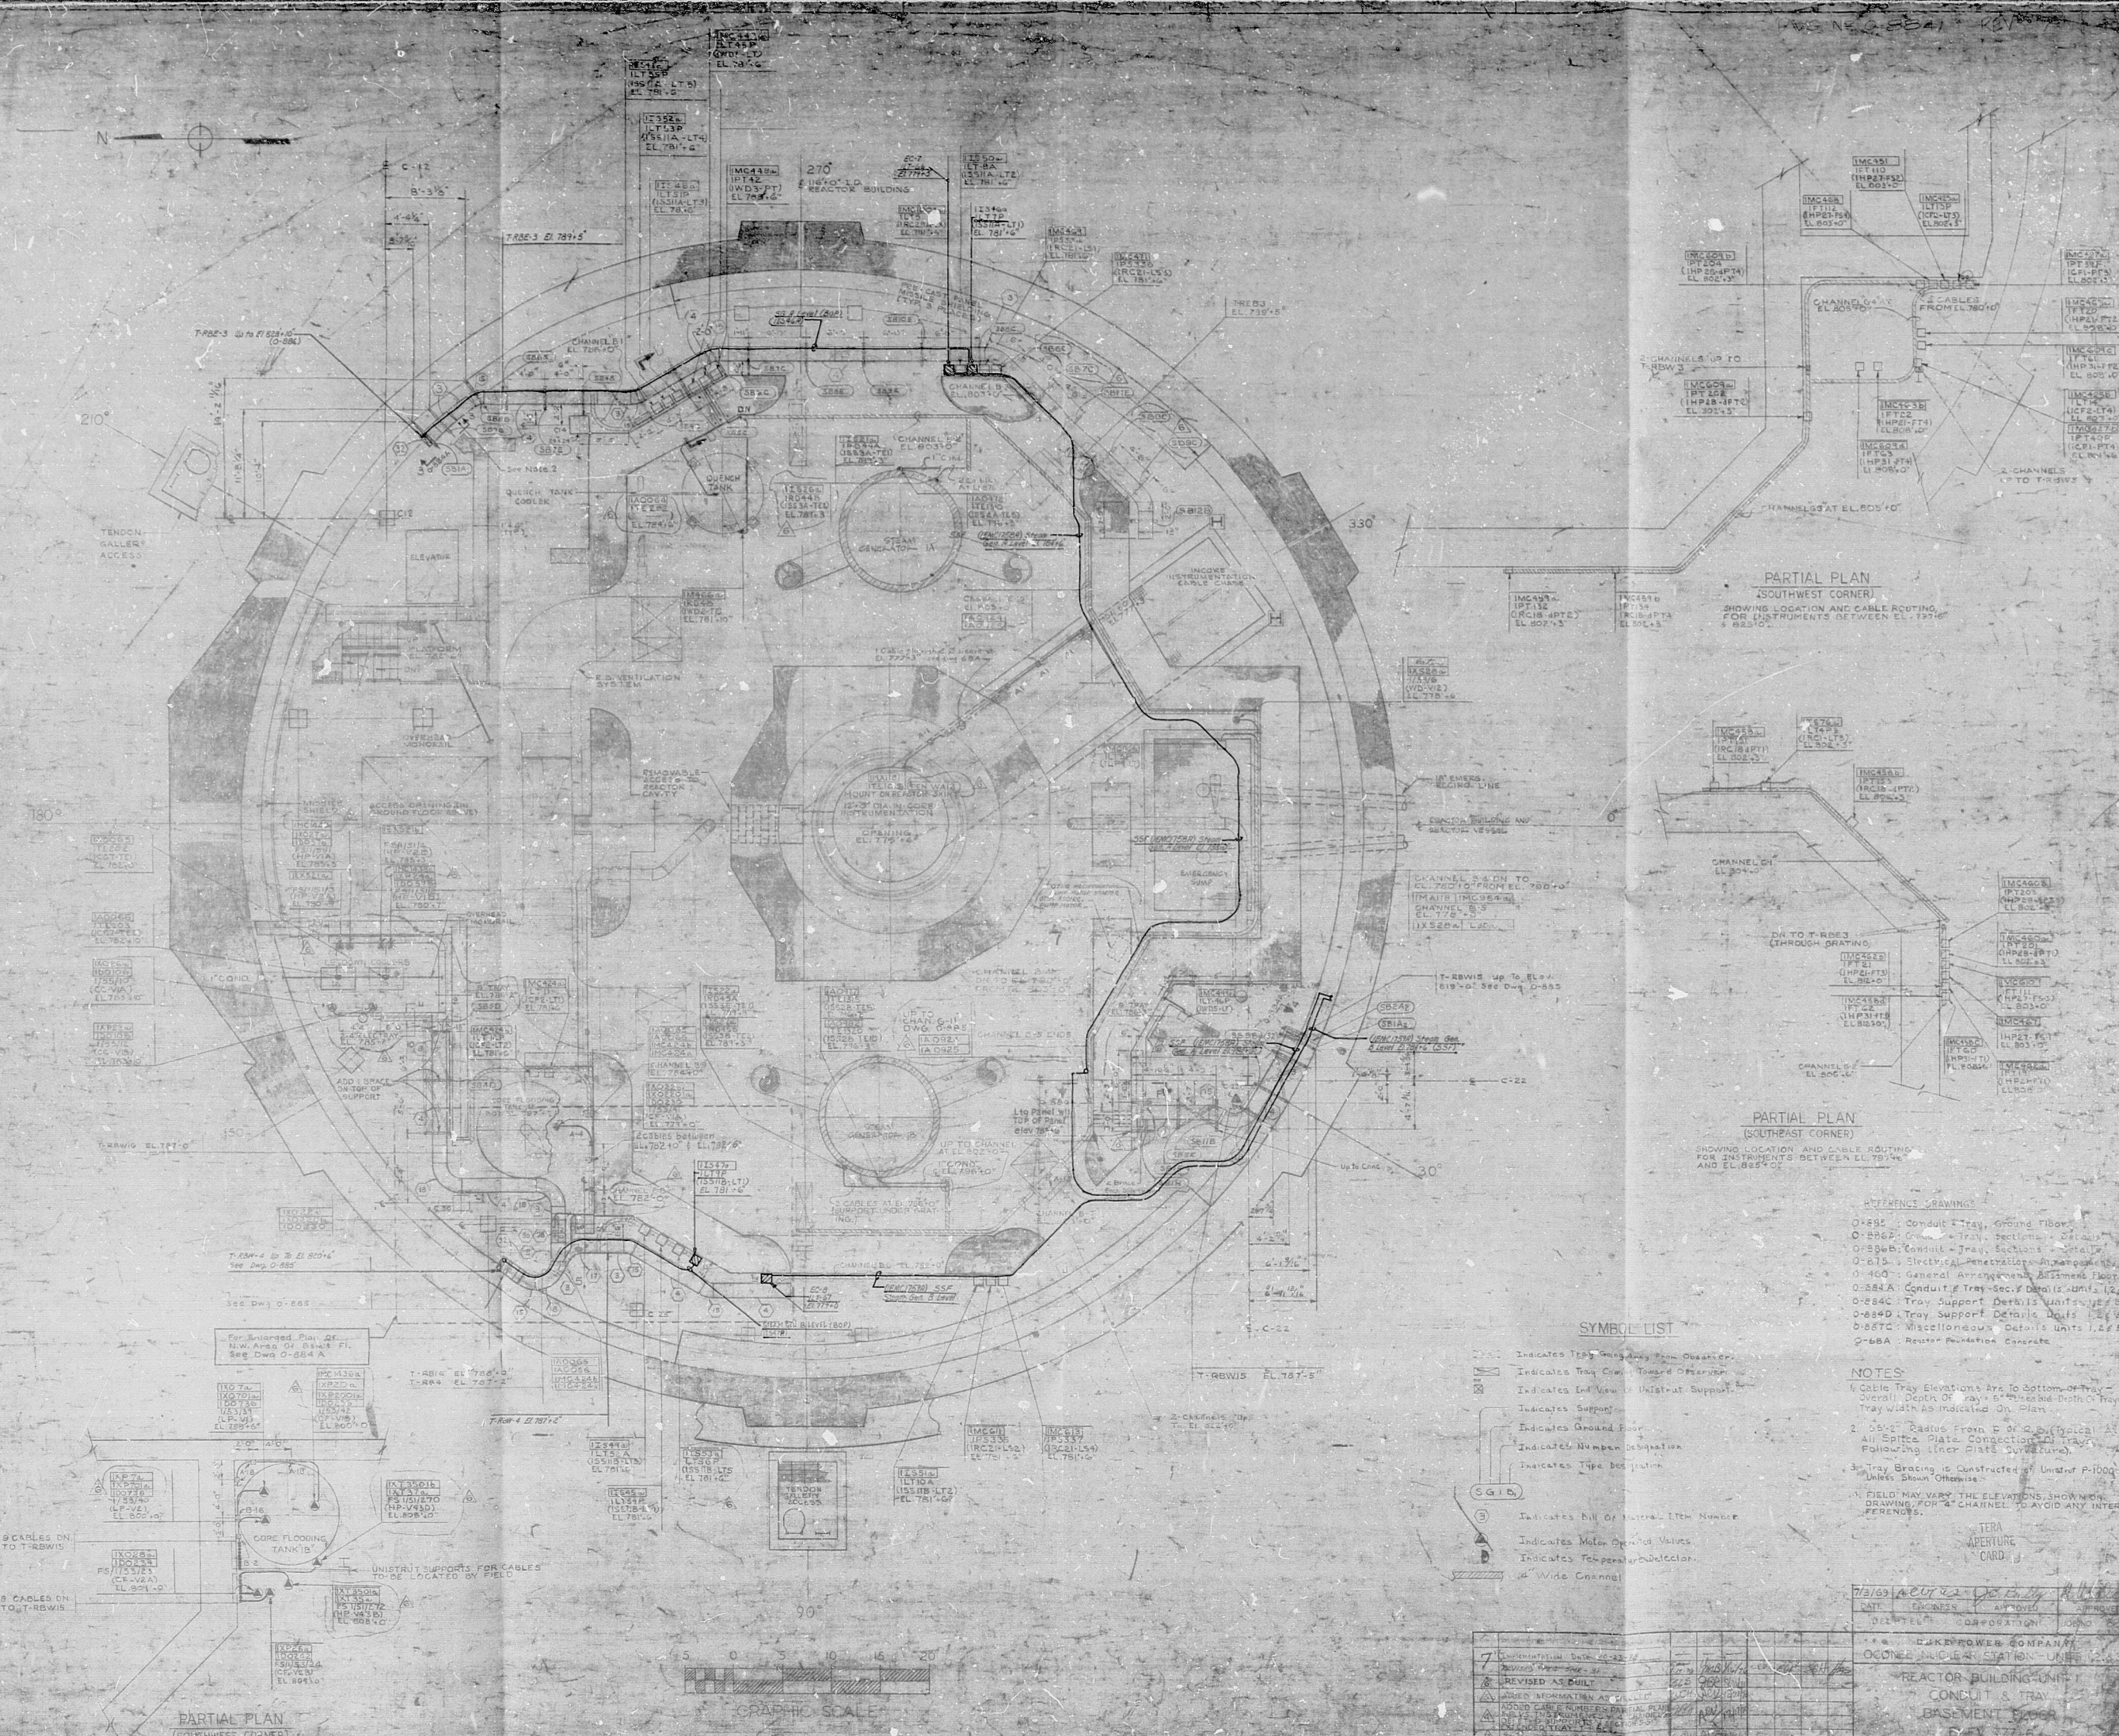

PARTIAL PLAN  
(SOUTHWEST CORNER)  
SHOWING LOCATION AND CABLE ROUTING  
FOR INSTALLMENTS BETWEEN EL. 791'-0" AND EL. 825'-0"

PARTIAL PLAN  
(SOUTHEAST CORNER)  
SHOWING LOCATION AND CABLE ROUTING  
FOR INSTALLMENTS BETWEEN EL. 791'-0" AND EL. 825'-0"

SYMBOL LIST

- Indicates Tray Going Away from Observer.
- Indicates Tray Coming Toward Observer.
- Indicates End View of Unistrut Support.
- Indicates Support.
- Indicates Ground Floor.
- Indicates Number Designation.
- Indicates Type Designation.
- Indicates Bill of Material Item Number.
- Indicates Major Operating Values.
- Indicates Temperature Indicator.
- Wire Channel.

REFERENCE DRAWINGS

- O-495: Conduit Tray, Ground Floor.
- O-496: Conduit Tray, Sections, Detail.
- O-497: Conduit Tray, Sections, Detail.
- O-475: Electrical Penetration in Walls.
- O-400: General Arrangement, Basement Floor.
- O-584A: Conduit Tray-sec. Detail, Units 1, 2, 3.
- O-584C: Tray Support Details, Units 1, 2, 3.
- O-584D: Tray Support Details, Units 1, 2, 3.
- O-587C: Miscellaneous Details, Units 1, 2, 3.
- O-68A: Reactor Foundation Concrete.

NOTES

1. Cable Tray Elevations Are to Bottom of Tray. Overall Depth of Tray = 5". Unistrut Depth of Tray Width As Indicated On Plans.
2. 5/8" Radius From E. of O. (Typical). All Splice Plate Connections on Trays Following Inner Plate Surfaces.
3. Tray Bracing is Constructed Under P-1000 Unless Shown Otherwise.
4. FIELD MAY VARY THE ELEVATIONS SHOWN ON DRAWING FOR A CHANNEL TO AVOID ANY INTERFERENCE.

TERA APERTURE CARD

NO.	DESCRIPTION	DATE	BY	CHECKED



PIDS-PDR

8105050718

