

34"

34"

22"

22"

17"

17"

11"

11"

8.5"

8.5"

11"


11"

17"

17"

22"

22"

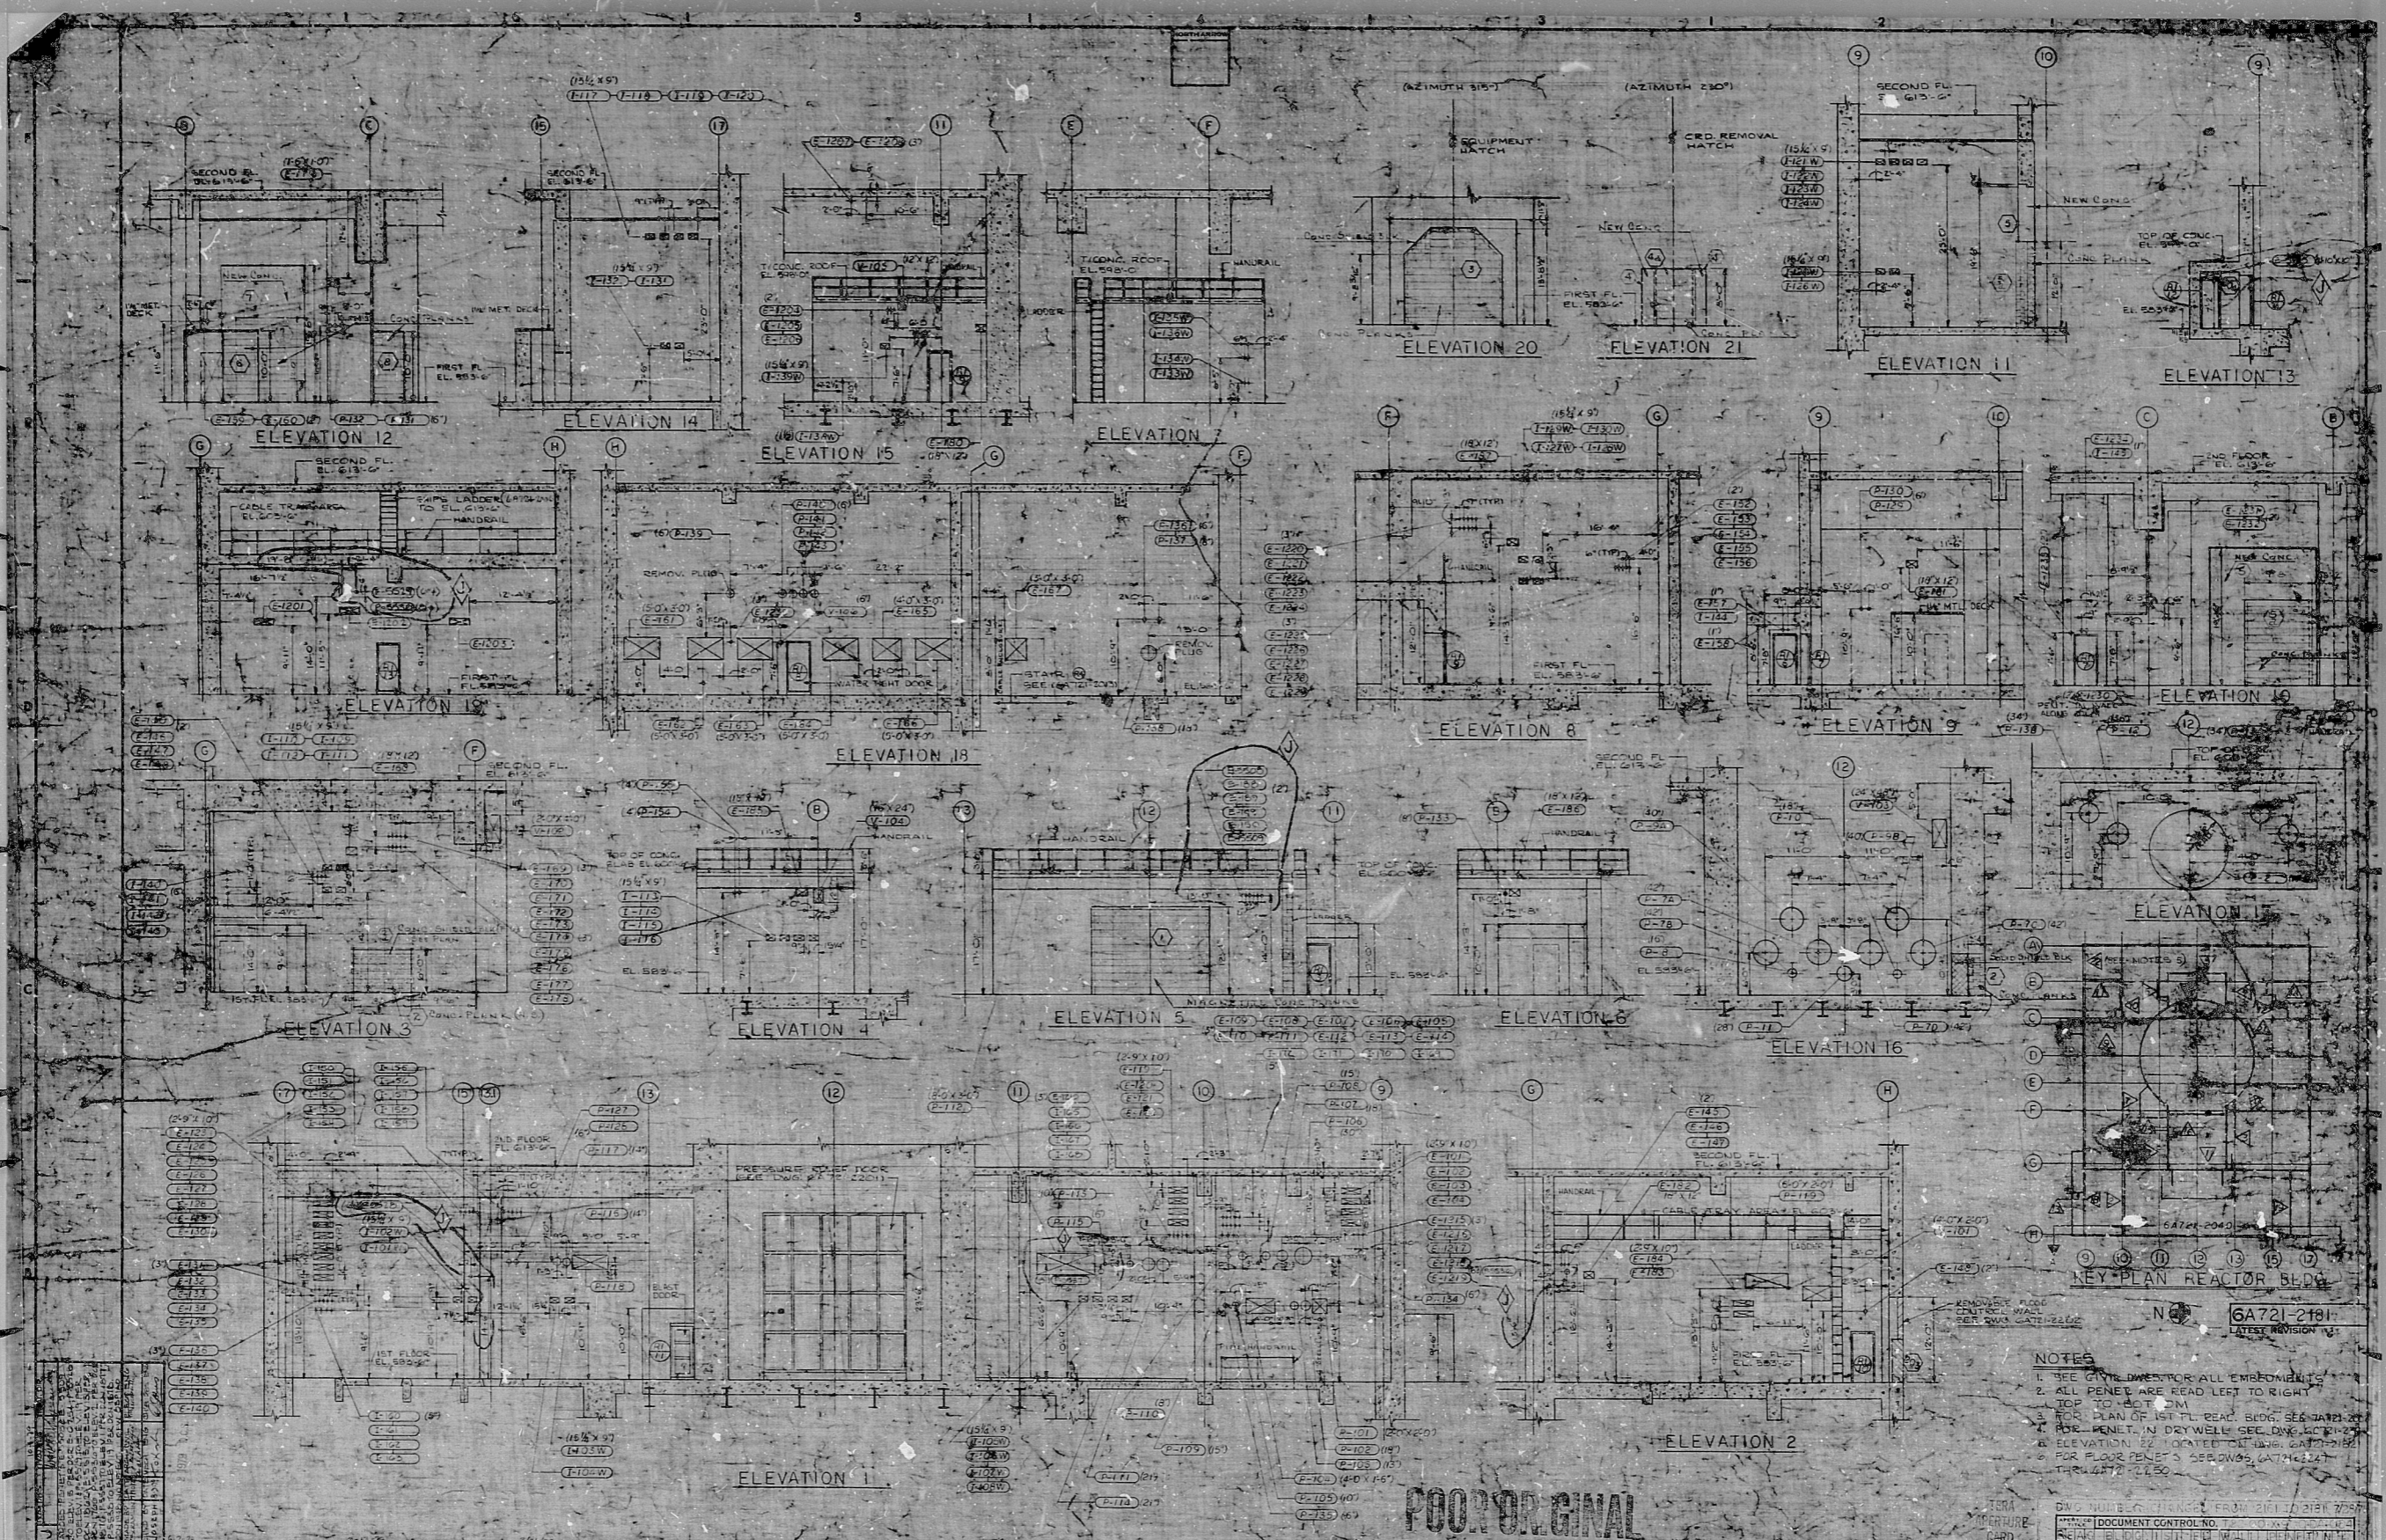

NOTES

1. SEE GRID DIMS FOR ALL EMBEDMENTS
2. ALL PENETS ARE READ LEFT TO RIGHT TOP TO BOTTOM
4. PENETS IN DRYWELL SEE DWG 6A721-218
5. ELEVATION 12 LOCATED ON DWG 6A721-218
6. FOR FLOOR PENETS SEE DWG 6A721-218 THROUGH 2180

6A721-218  
LATEST REVISION

34"

34"

RIDS-PDR

8105050736

