

..98

..98

..22

..22

..11

..11

..11

..11

..58

..58

8.5"

8.5"

11"

11"

17"


17"

22"

22"

34"

34"

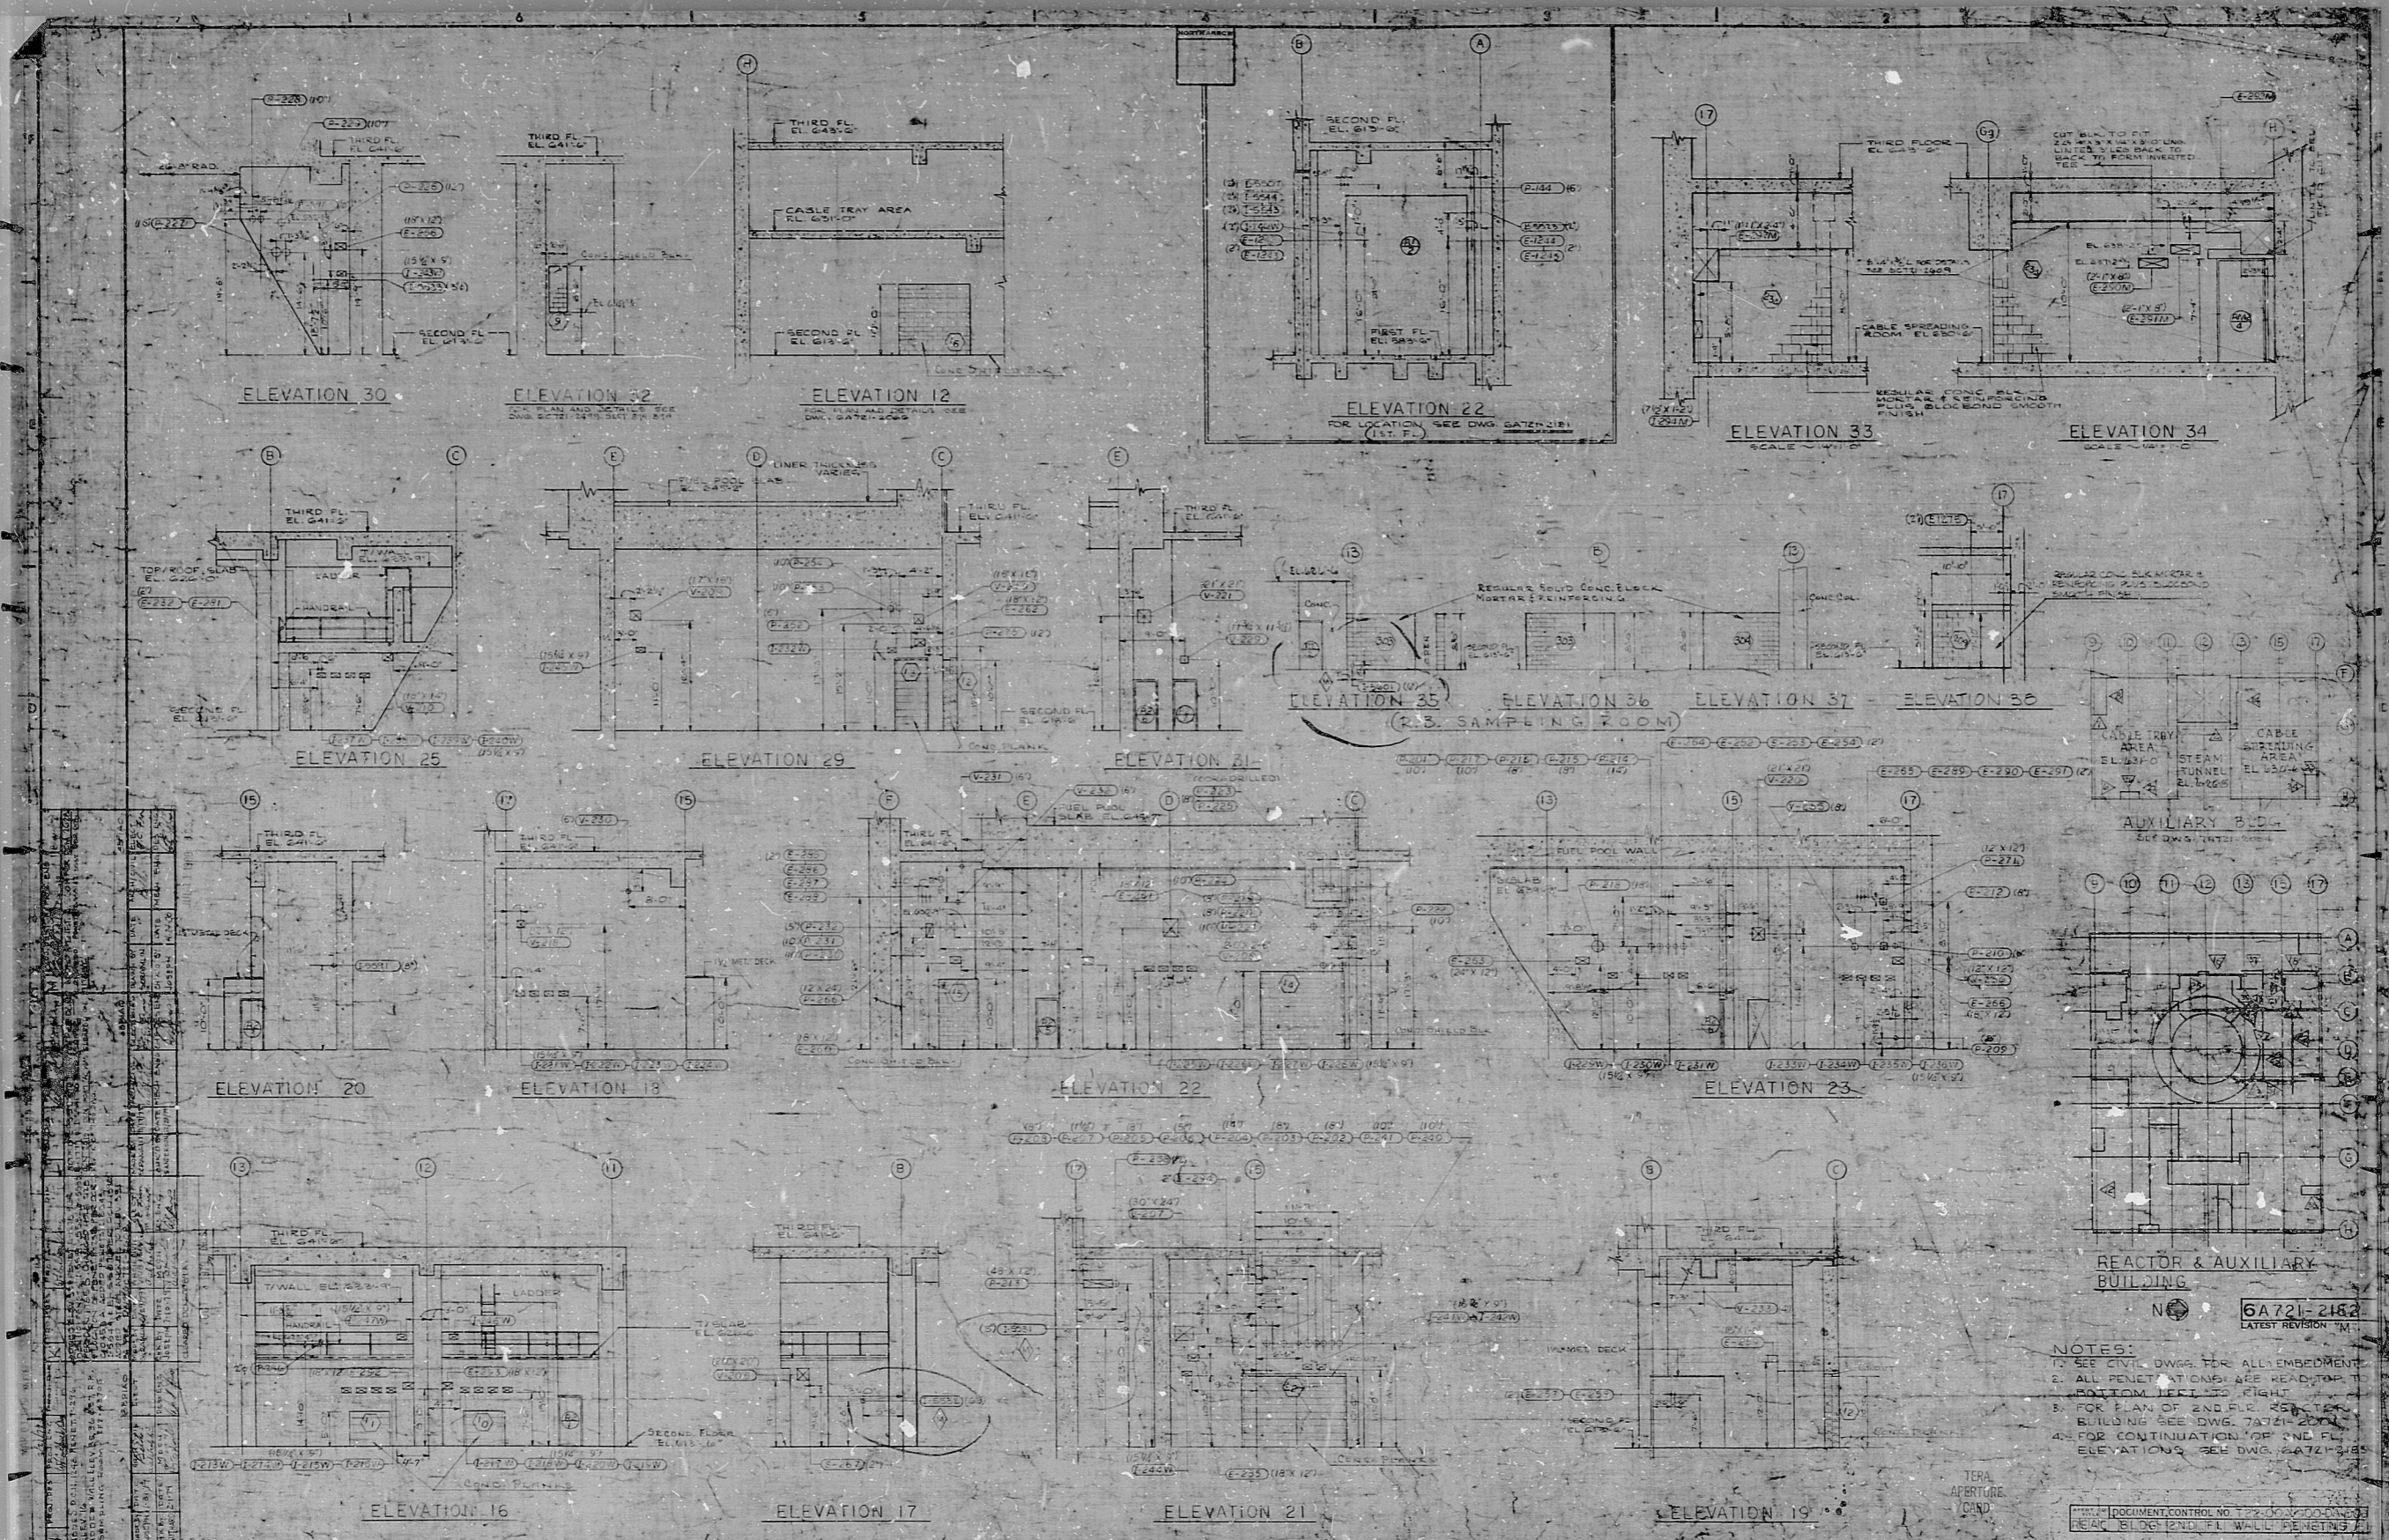

RDS-PDR

8105050742

