

34"

22"

17"

11"

8.5"


8.5"

11"

17"


22"

34"

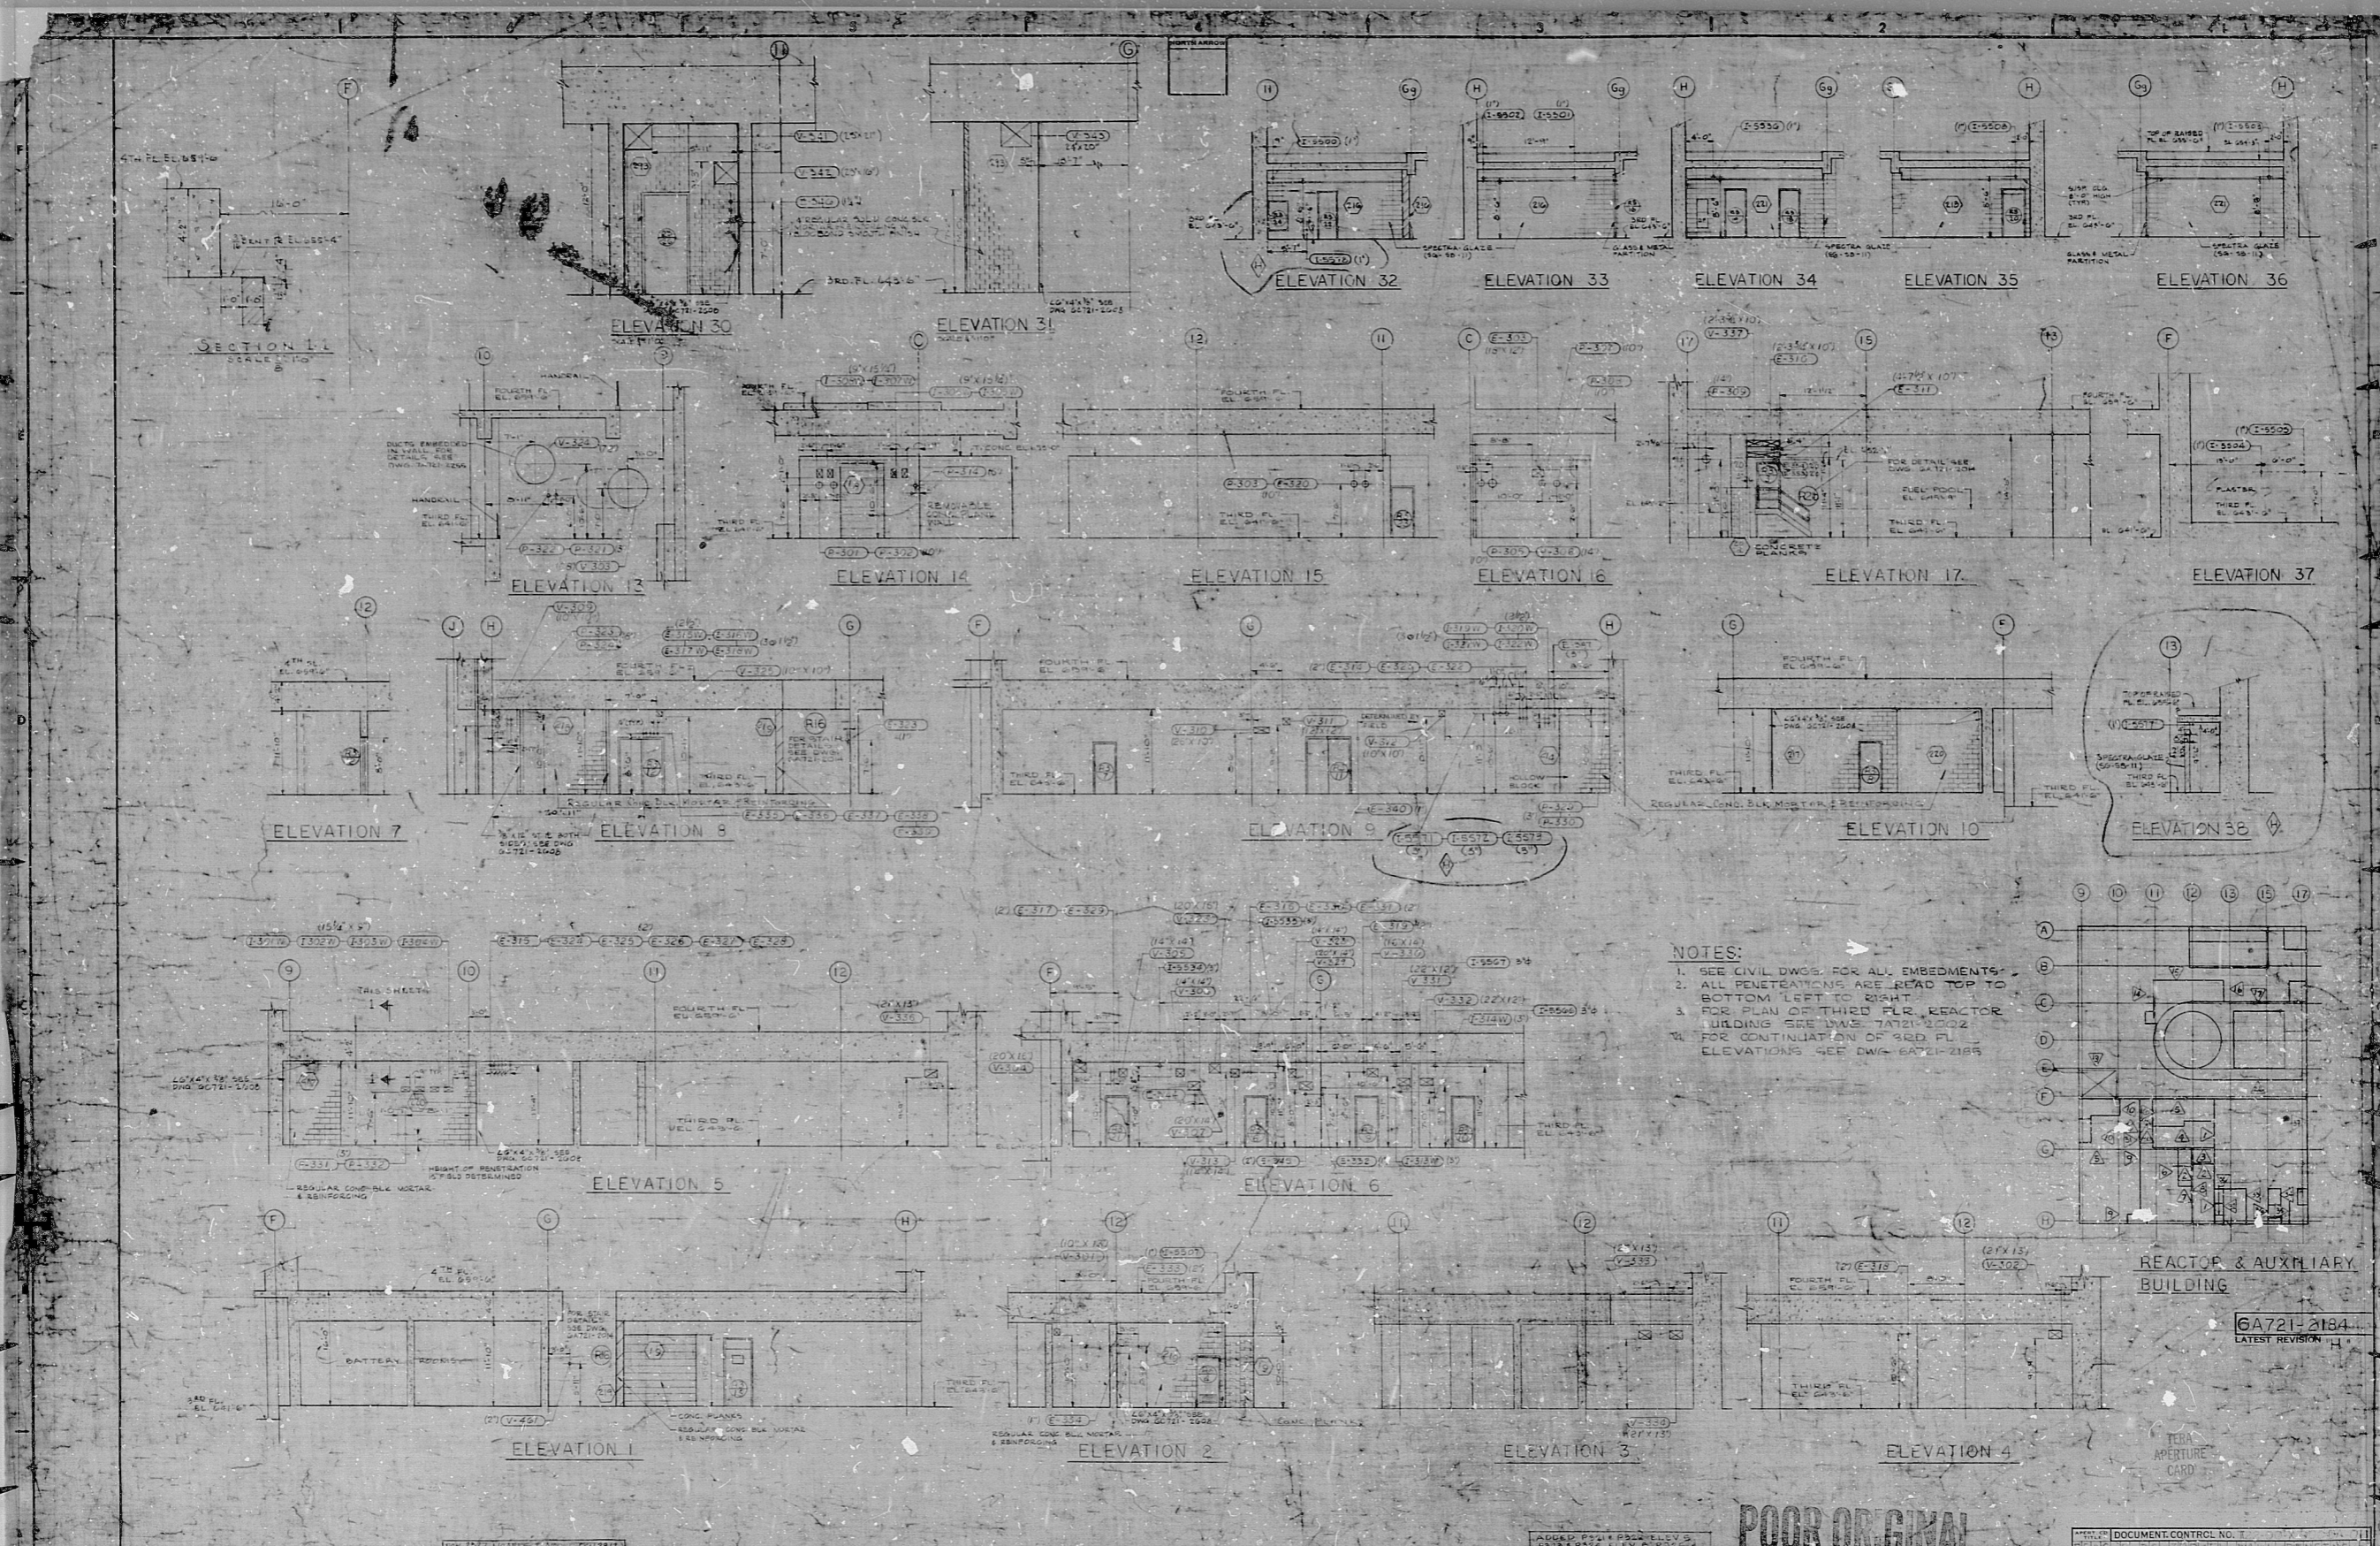

NOTES:

1. SEE CIVIL DWGS. FOR ALL EMBEDMENTS.
2. ALL PENETRATIONS ARE READ TOP TO BOTTOM LEFT TO RIGHT.
3. FOR PLAN OF THIRD FLR. REACTOR BUILDING SEE DWG. 7471-2002.
4. FOR CONTINUATION OF 3RD FL. ELEVATIONS SEE DWG. 6A721-2189.

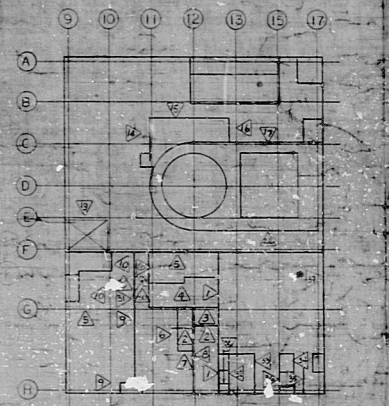

REACTOR & AUXILIARY BUILDING

6A721-2184
LATEST REVISION 11


POOR ORIGINAL


DOCUMENT CONTROL NO. 11
 REACTOR BLDG. AND FLOOR WALL PENETRATIONS ELEVATIONS 1-38
 ENRICH FERRIS ARCH. BK.
 6A721-2184
 11/15/50

34"

RIDS-PDR

8105050751

