


ENLARGED PLAN OF INTERMEDIATE FLOOR WEST AREA
SCALE 3/8"=1'-0"
(DWG. 2886) (E-7)

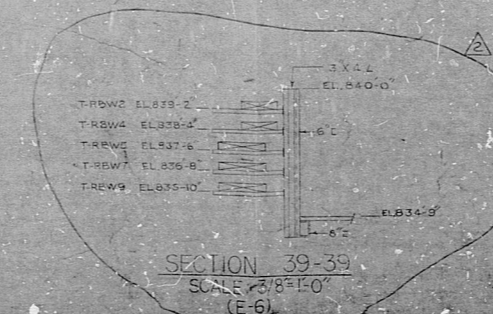

- SYMBOL LIST**
- Indicates Tray Gang Awry from Observer
 - Indicates Tray Gang Awry from Observer
 - Indicates End View of Directed Support
 - Indicates Unit V
 - Indicates Support
 - Indicates Intermediate Floor
 - Indicates Number Designation
 - Indicates Type Designation

- REFERENCE DRAWINGS**
- 2-211 Electrical Distribution Arrangement Unit
 - 2-212 Electrical Distribution Unit
 - 2-213 Electrical Distribution Unit
- NOTES**
1. TRAY BRACES ARE CONSTRUCTED OF UNISTRUT R-1000 UNLESS OTHERWISE SHOWN.

NO.	DESCRIPTION	DATE	BY	CHECKED	APPROVED
1	ISSUED FOR CONSTRUCTION	10/1/68	J. H. [Signature]	[Signature]	[Signature]
2	ISSUED FOR CONSTRUCTION	10/1/68	J. H. [Signature]	[Signature]	[Signature]
NUCLEAR SAFETY RELATED

DATE: 10/1/68
ENGINEER: J. H. [Signature]
APPROVED: [Signature]

DUKE POWER COMPANY
OCONEE NUCLEAR STATION UNITS 1, 2 & 3
REACTOR BUILDING UNIT-3
CONDUIT AND TRAY
SECTION AND DETAILS
INTERMEDIATE FLOOR-EL 825'-0"

8105050753

12IDS-ROR

8105050755

