

34"

34"

22"

22"

17"

17"

11"

11"

8.5"

8.5"

8.5"

8.5"

11"

11"

17"


17"

22"

22"

34"

34"

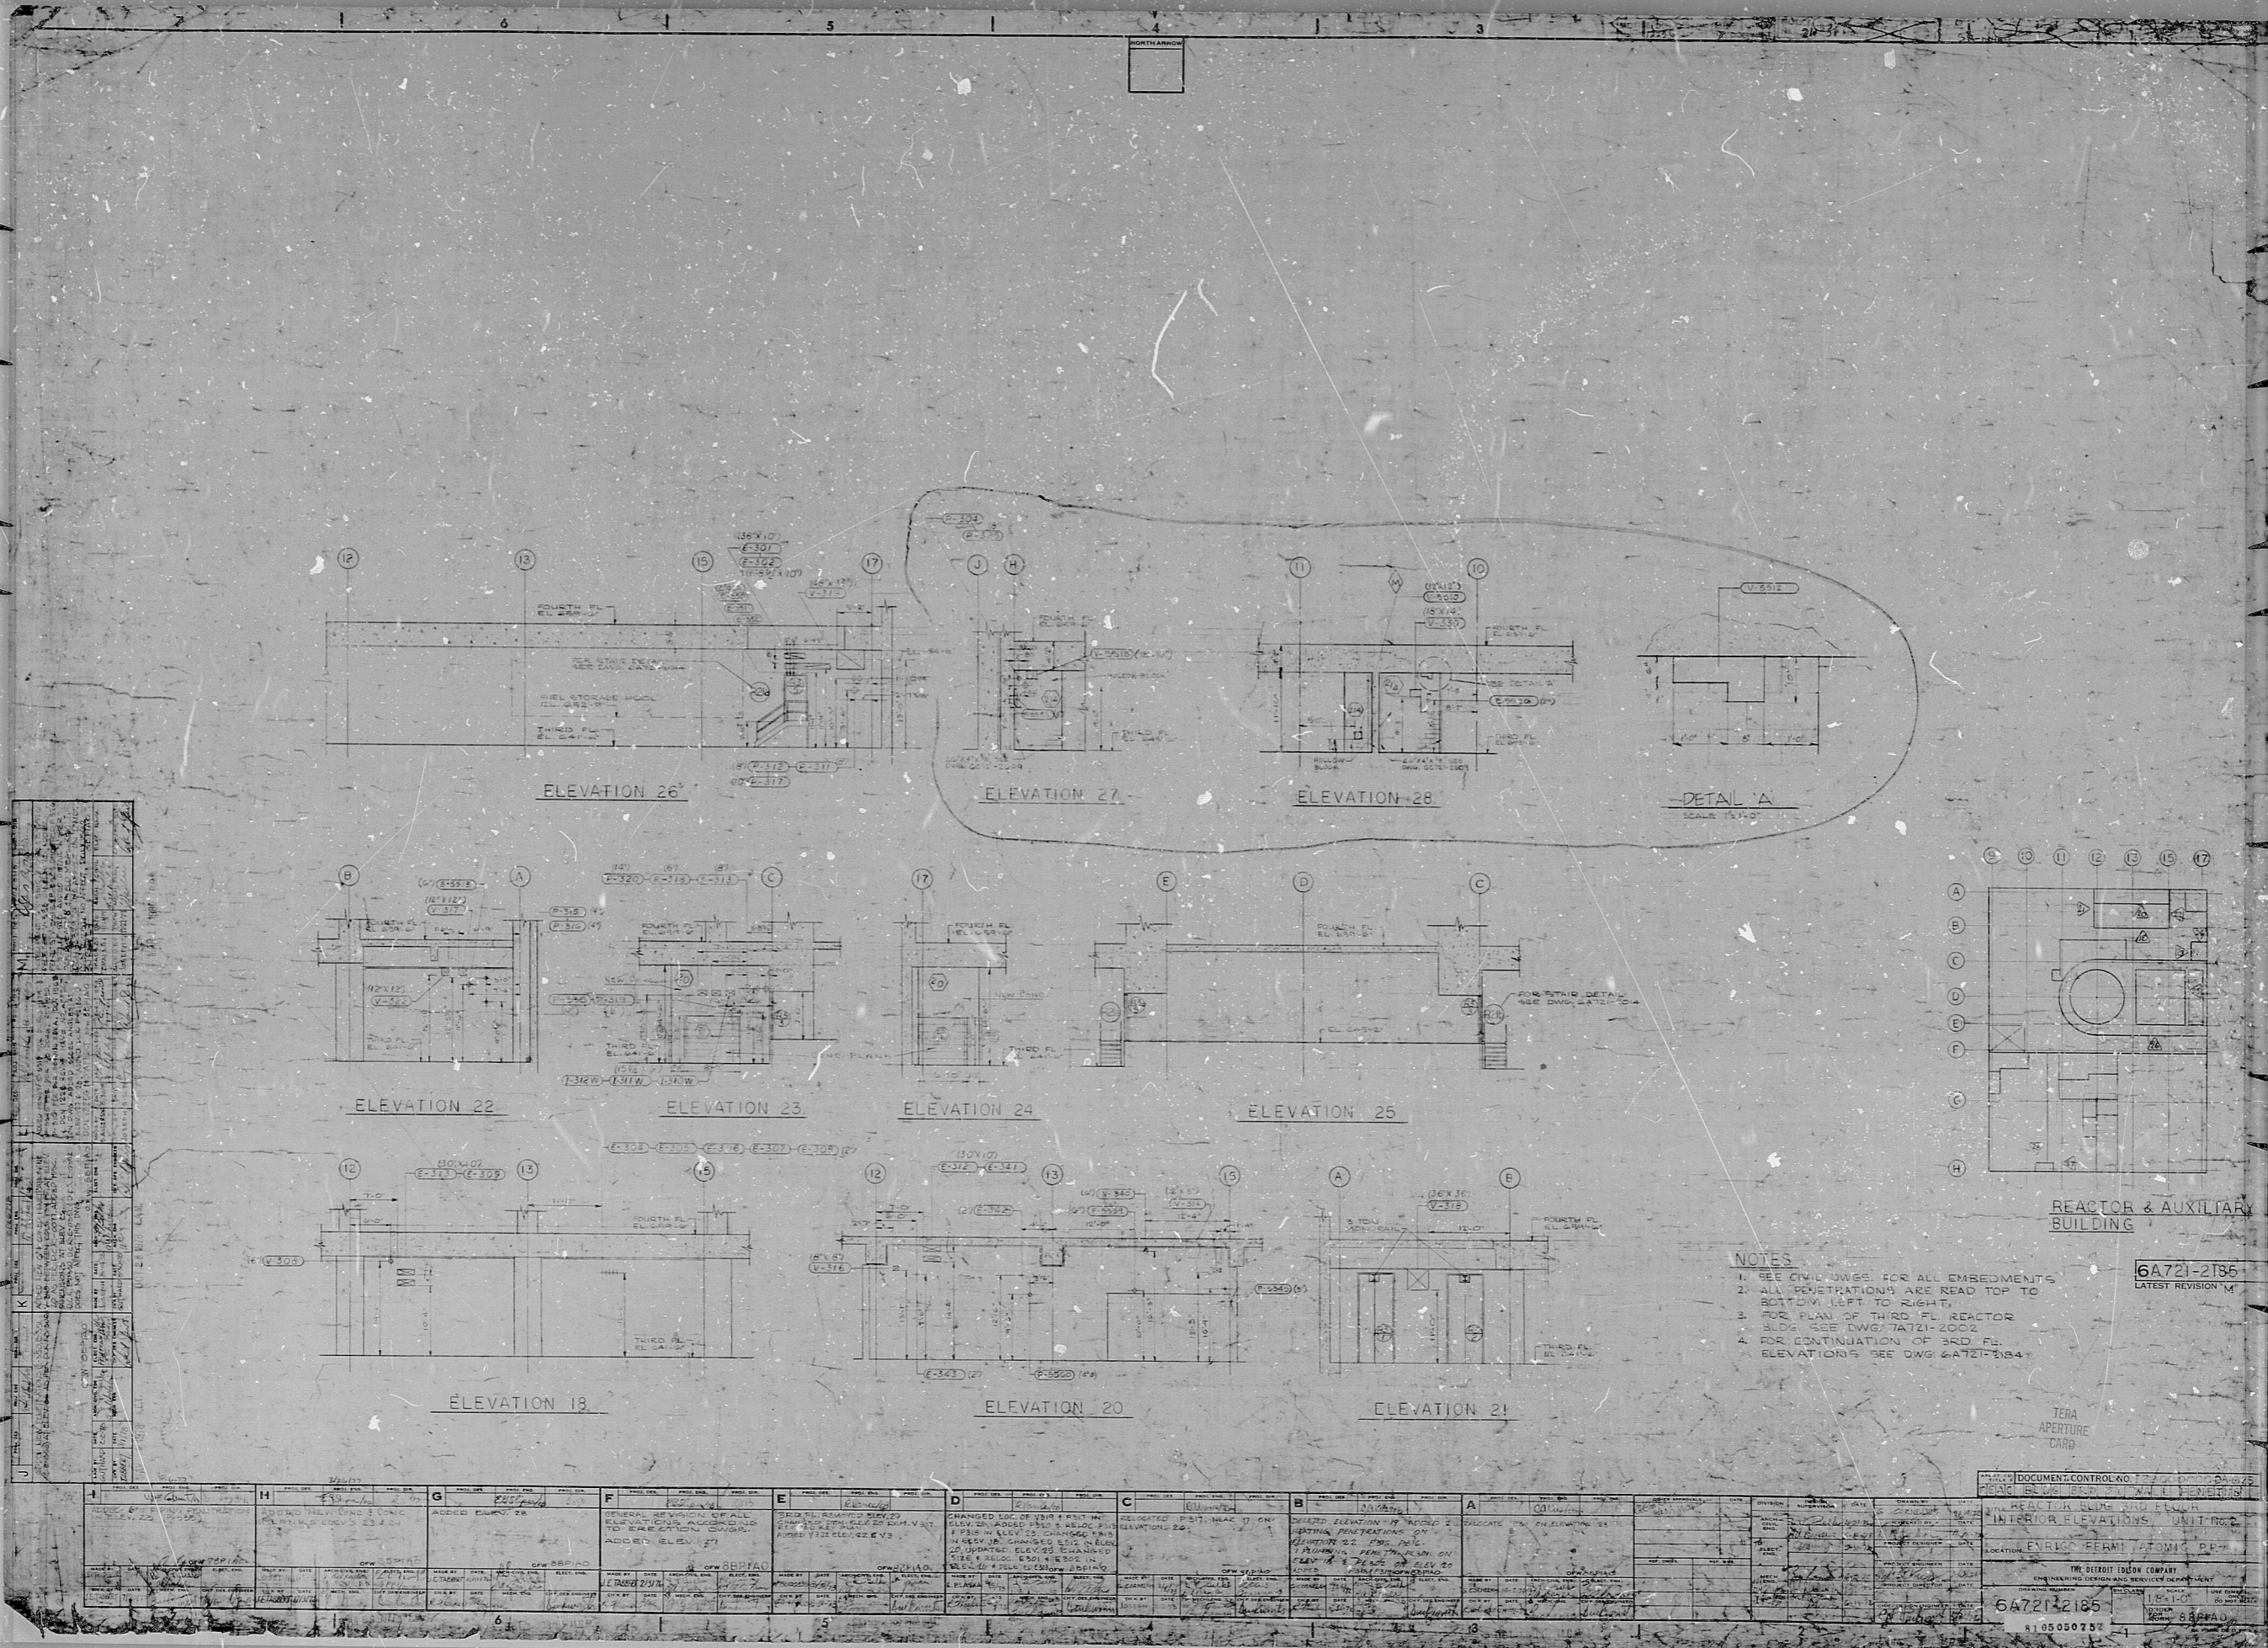

- NOTES
1. SEE CIVIL DWGS. FOR ALL EMBEDMENTS
 2. ALL PENETRATIONS ARE READ TOP TO BOTTOM, LEFT TO RIGHT.
 3. FOR PLAN OF THIRD FL. REACTOR BLDG. SEE DWG. 7A721-2002
 4. FOR CONTINUATION OF 3RD FL. ELEVATIONS SEE DWG. 6A721-2184

DOCUMENT CONTROL NO.		DATE	
REACTOR & AUXILIARY BUILDING INTERIOR ELEVATIONS UNIT NO. 2 REACTOR & AUXILIARY BUILDING			

RIDS-PDR

8105030757

