

34"

34"

22"

22"

17"

17"

11"

11"

5.8"

5.8"

8.5"

8.5"

11"

11"

17"


17"

22"

22"

34"

34"

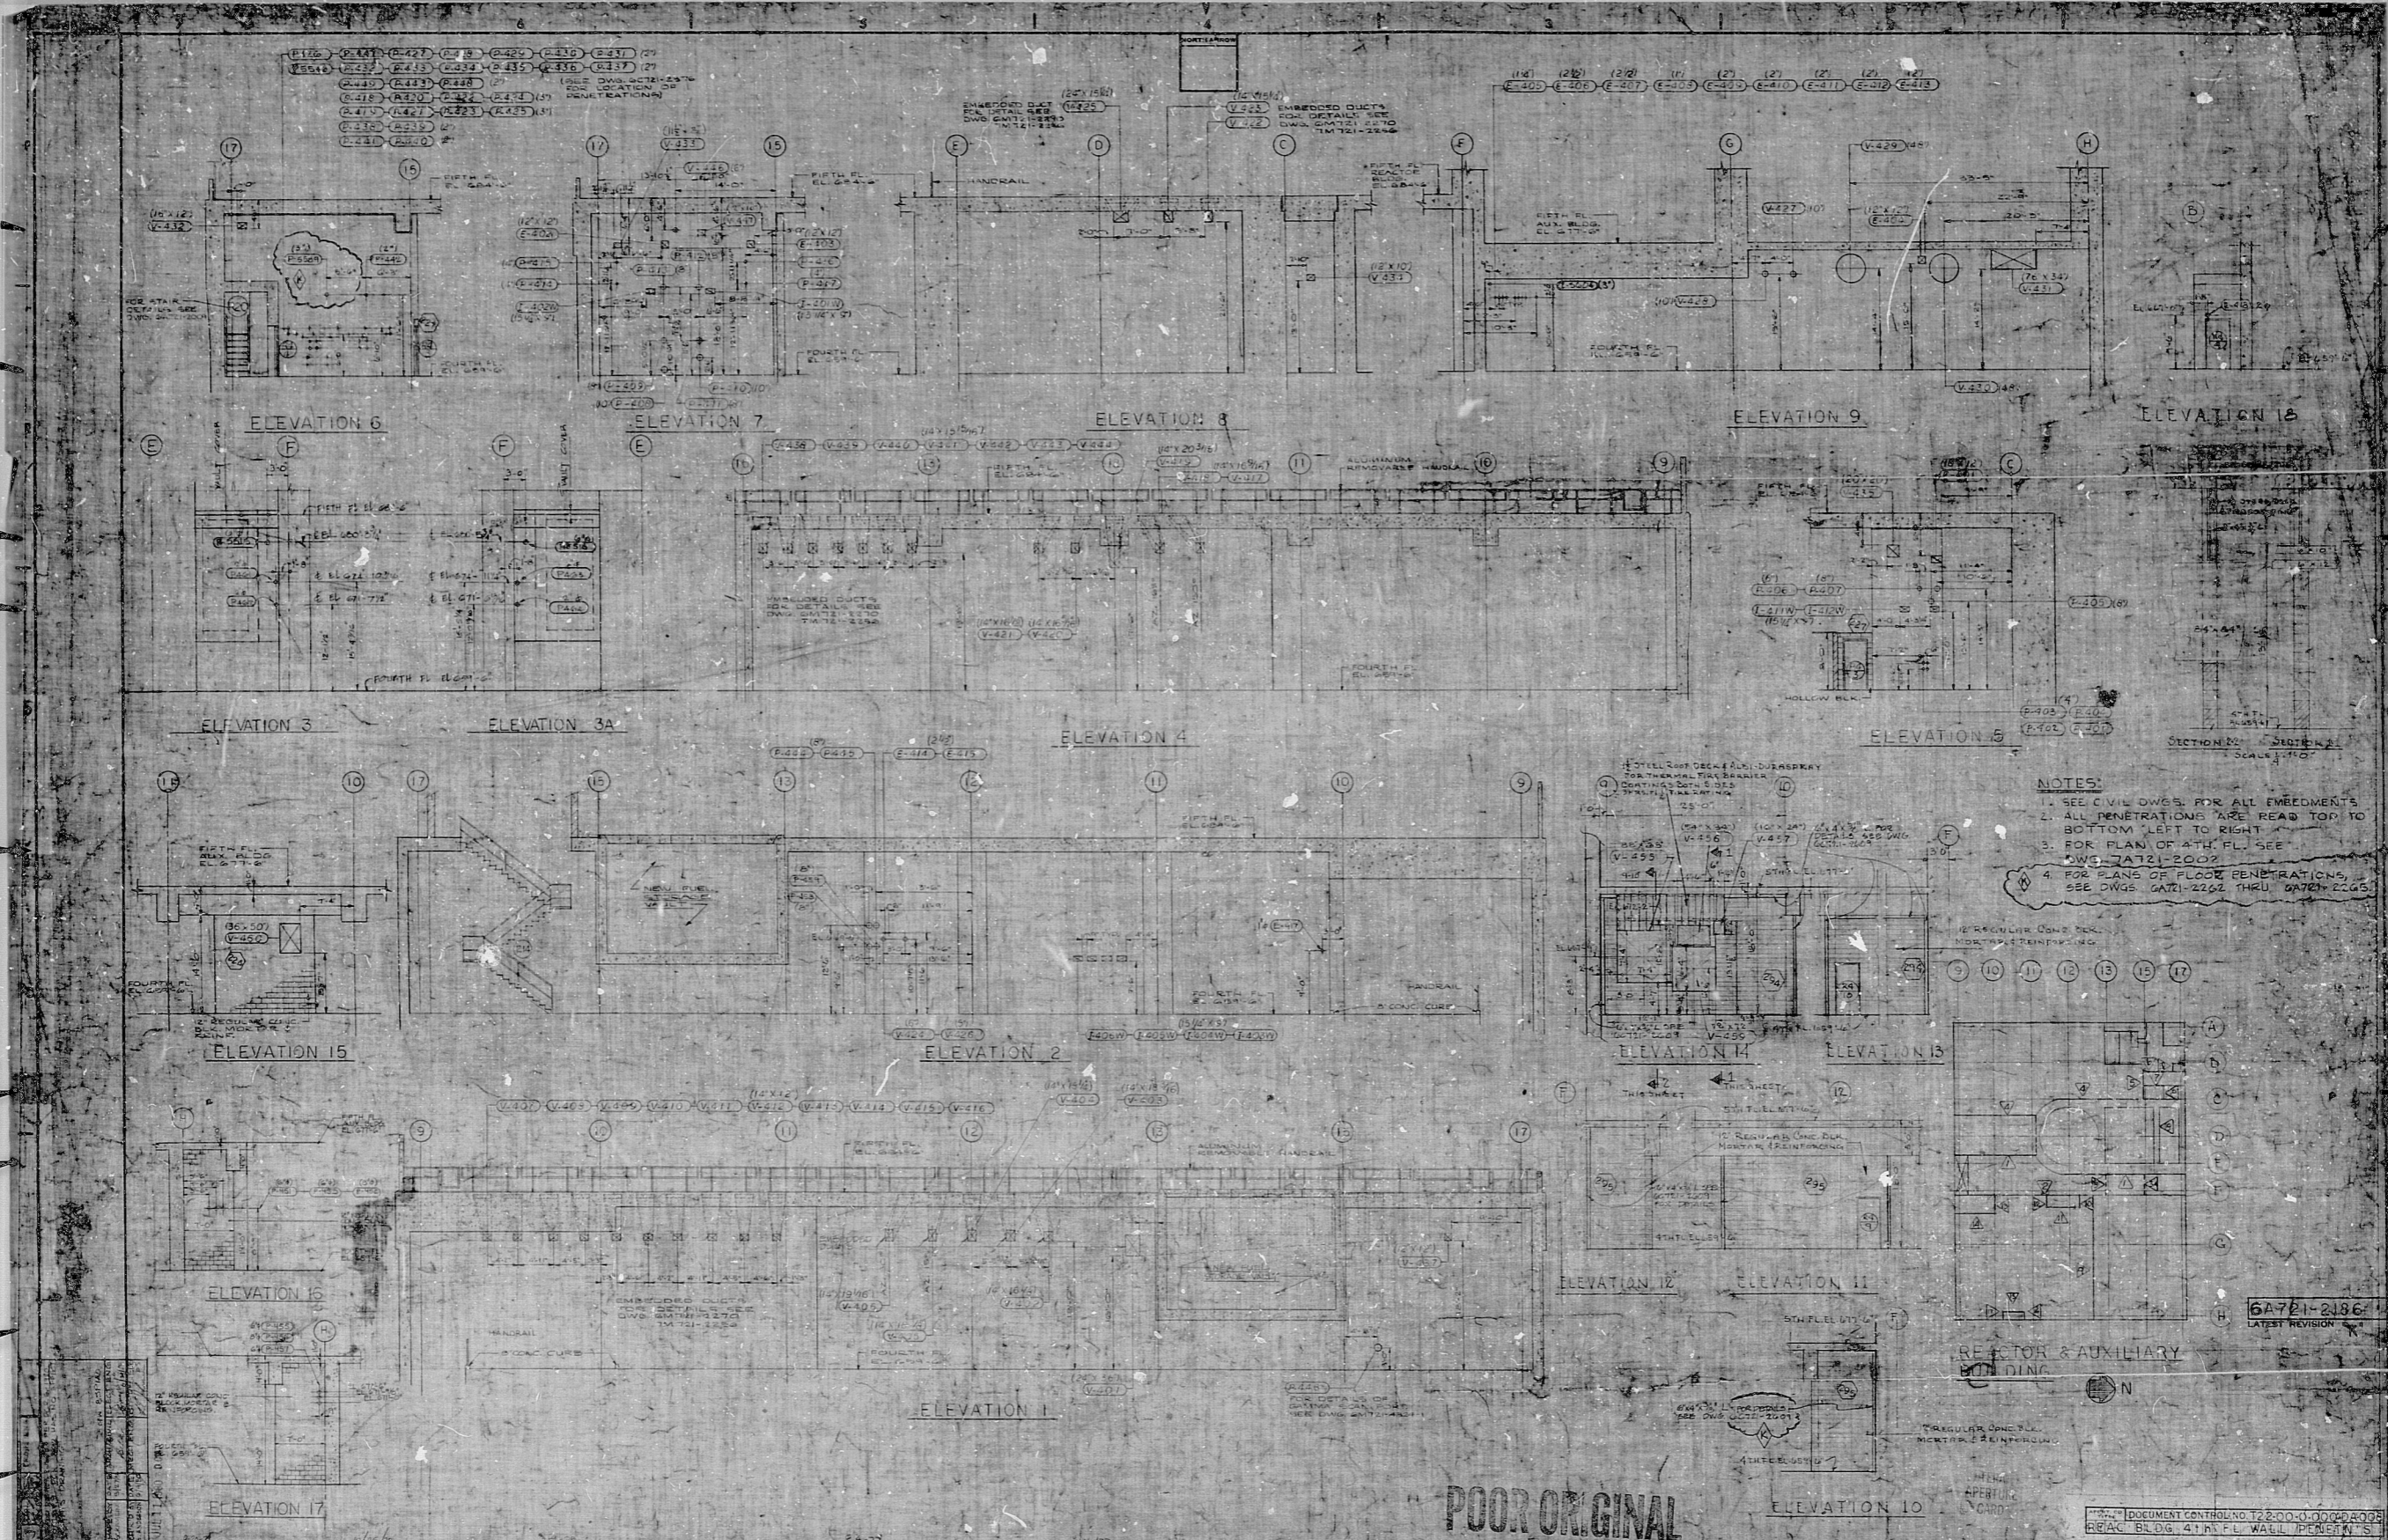

- NOTES:
1. SEE CIVIL DWGS. FOR ALL EMBEDMENTS
 2. ALL PENETRATIONS TAKE READ TO BOTTOM LEFT TO RIGHT
 3. FOR PLAN OF 4TH FL. SEE DWG. 7A721-2007
 4. FOR PLANS OF FLOOR PENETRATIONS, SEE DWGS. 7A721-2202 THRU 7A721-2205

6A721-2186
LATEST REVISION


DOCUMENT CONTROL NO. 12-00-10000-0005
REAC. BLDG. 4TH FL. WALL PENETRATIONS

REACTOR BLDG. 4TH FLOOR
INTERIOR WALL ELEVATIONS
UNIT No. 2

LOCATION: ENRIE FERM. 470M1 (P) 11A

6A721-2186

518050790

RIDS-PDR

8105050760

