


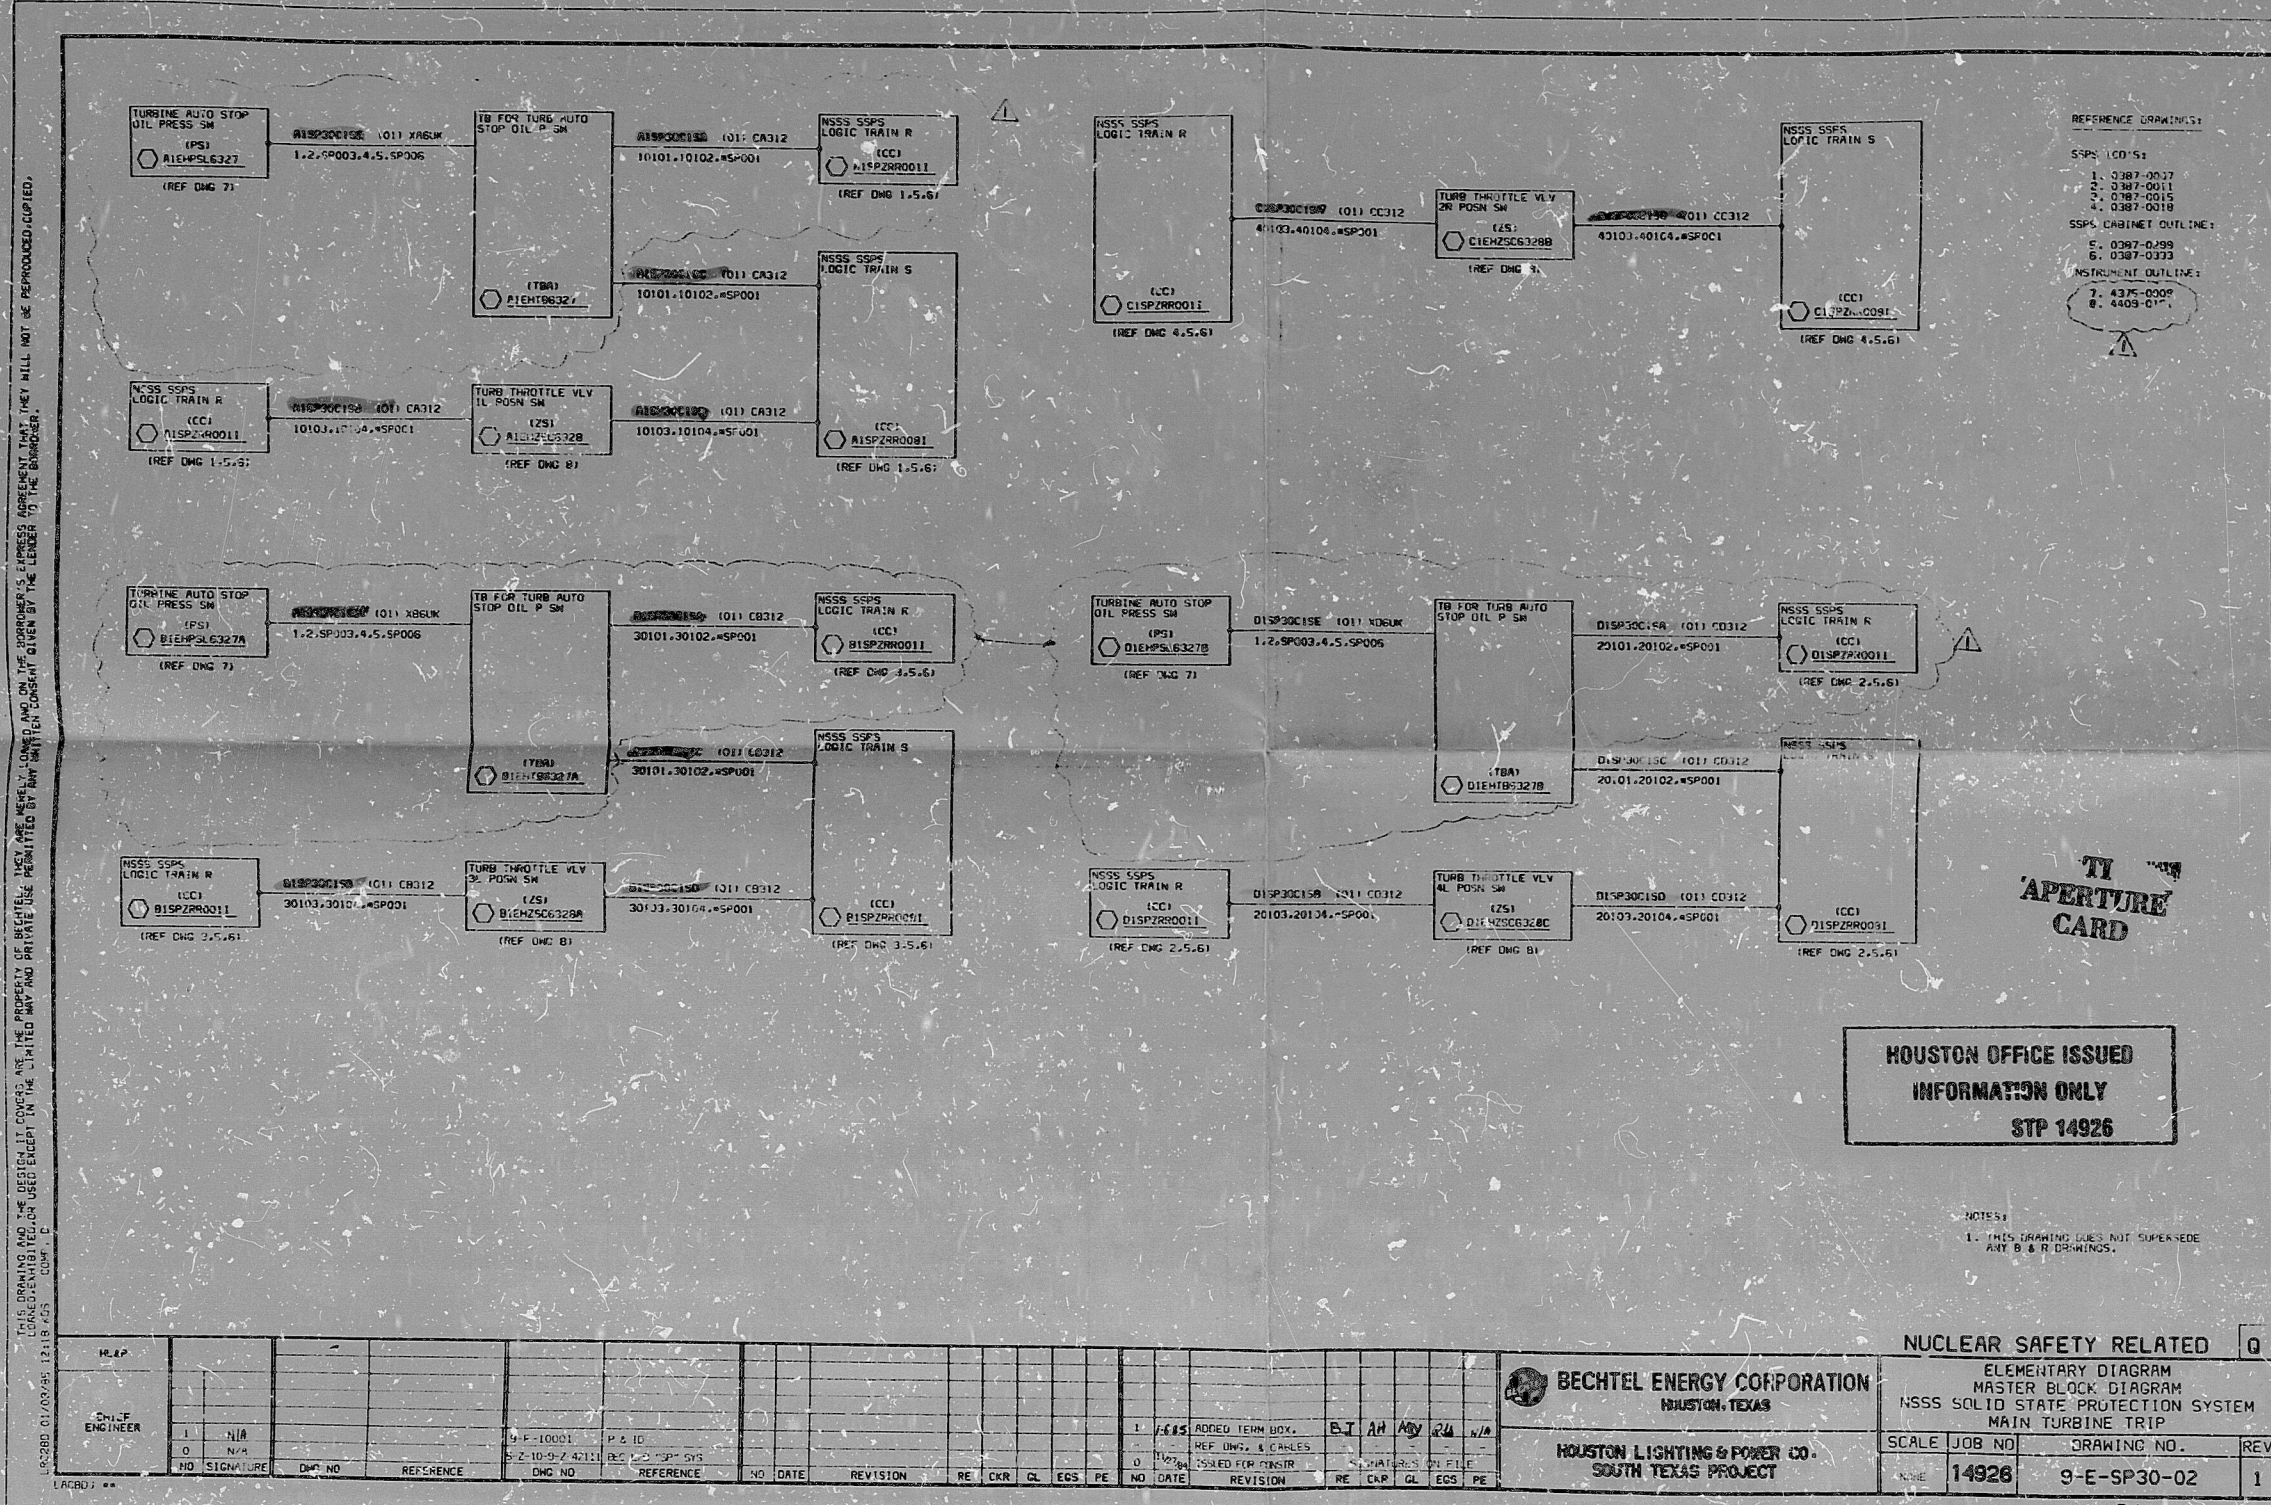

TI
APERTURE
CARD

HOUSTON OFFICE ISSUED
INFORMATION ONLY
STP 14926

NOTES:
1. THIS DRAWING DOES NOT SUPERSEDE
ANY B & R DRAWINGS.

NO.	DATE	REVISION	BY	CHK	CL	EGS	PE	NO.	DATE	REVISION	BY	CHK	CL	EGS	PE

BECHTEL ENERGY CORPORATION HOUSTON, TEXAS		NUCLEAR SAFETY RELATED	
HOUSTON LIGHTING & POWER CO. SOUTH TEXAS PROJECT		ELEMENTARY DIAGRAM MASTER BLOCK DIAGRAM NSSS SOLID STATE PROTECTION SYSTEM MAIN TURBINE TRIP	
SCALE	JOB NO.	DRAWING NO.	REV.
	14926	9-E-SP30-02	1

THIS DRAWING MUST BE WORKED
WITH THE FOLLOWING DOCUMENTS

DCN'S	FCN'S	FCN'S

ATTACHMENT
STP-14-SP-19-16
PAGE 1 OF 11

20 18 16 14.5 12

24X

12 14.5 16 18 20 22

8511040335

PDR RDS

8511040835

