


14.5X

I CERTIFY THAT THE IMAGE CONTAINED ON THIS FRAME WAS MADE IN THE NORMAL AND REGULAR COURSE OF BUSINESS, ON THE DATE STATED BELOW AND THAT IT IS AN ACCURATE REPRODUCTION OF THE DOCUMENT SUBMITTED TO MICROGRAPHICS.
DATE: 12-10-81 CAMERA OPERATOR: [Signature] SECTION SUPERVISOR: [Signature]

This drawing and the design it covers are the property of BECHTEL. They are loaned to you for your use only and are not to be reproduced, copied, loaned, exhibited, or used except in the limited way and for the purpose intended by the lender to the borrower.

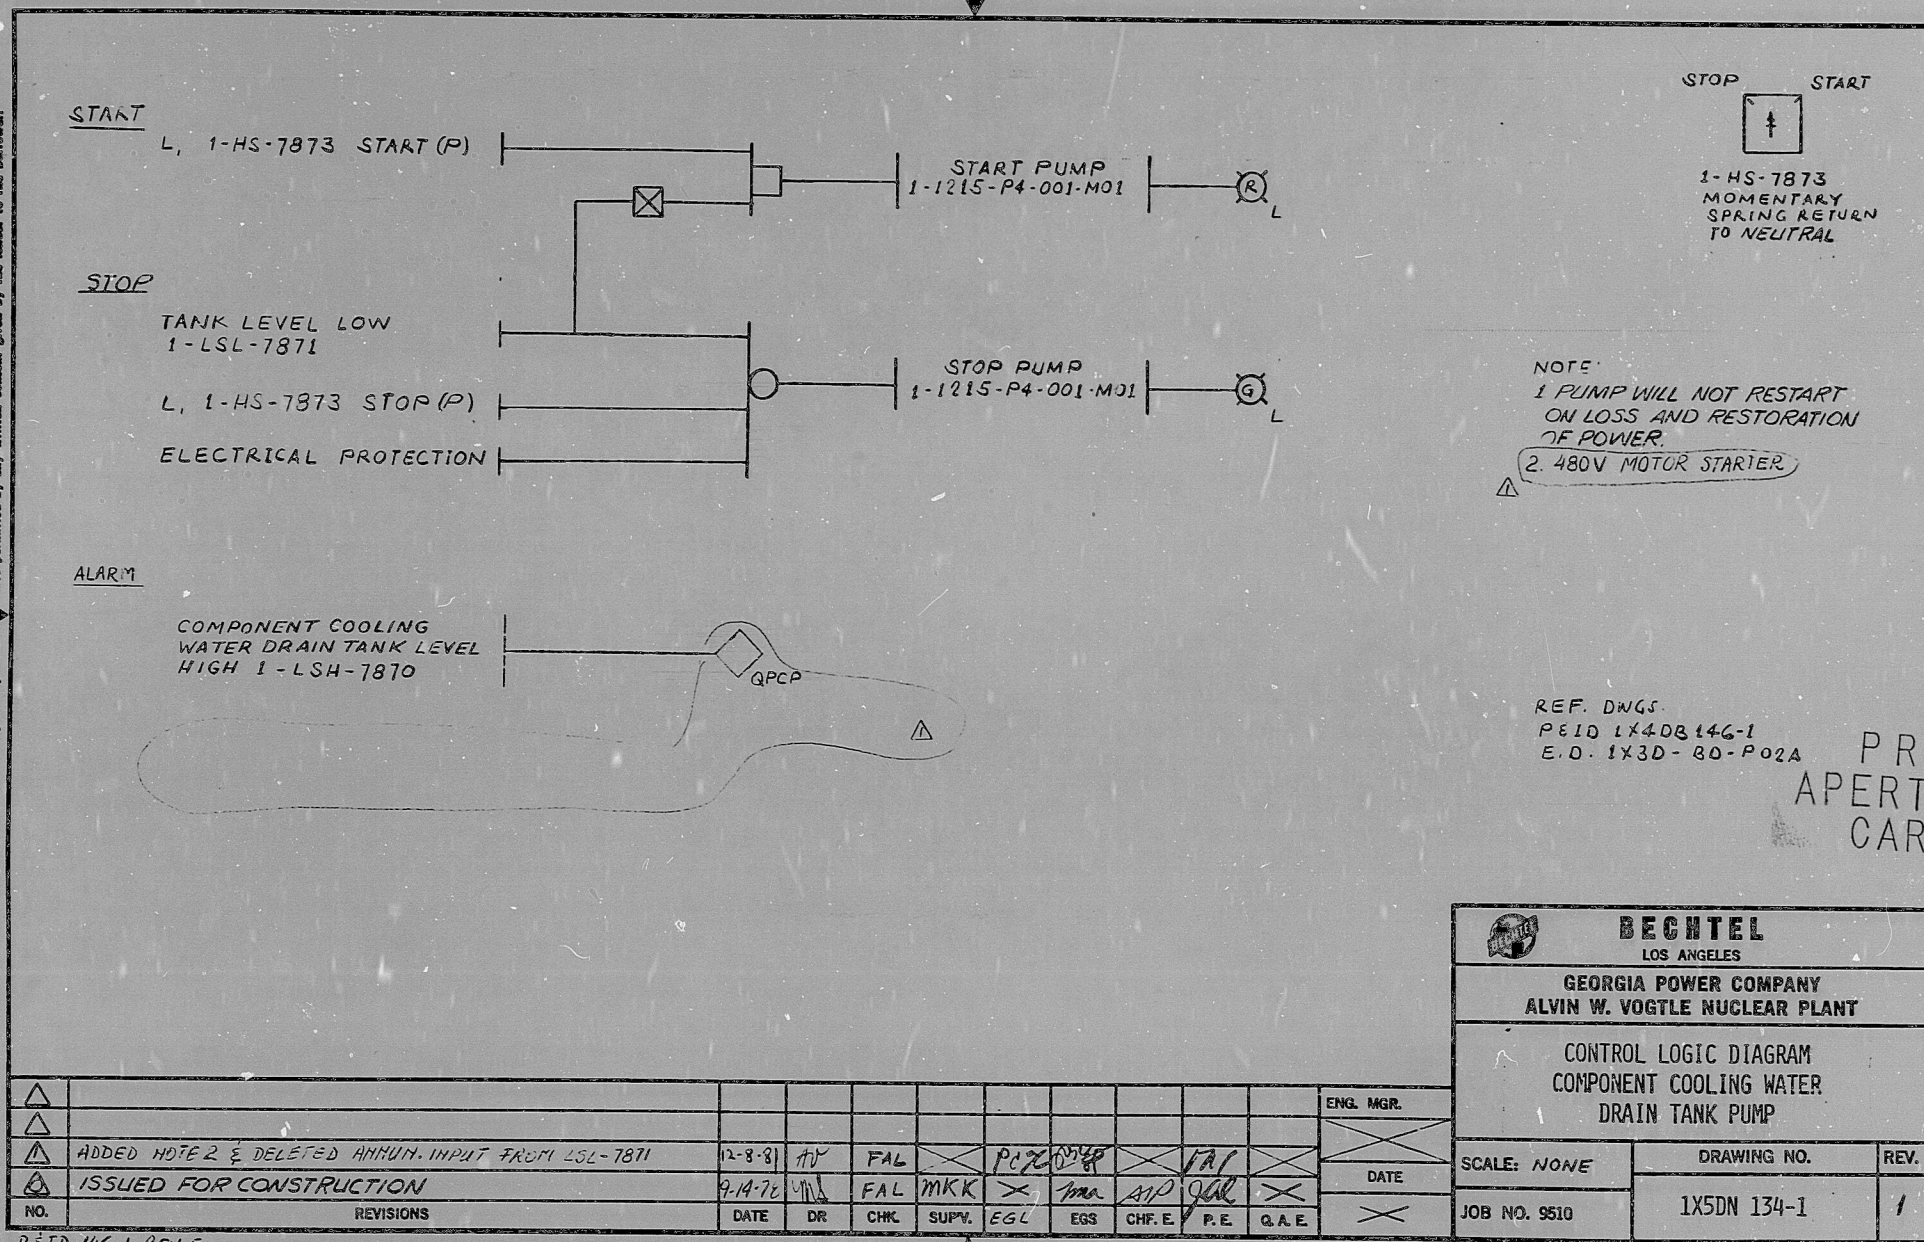

I CERTIFY THAT THE IMAGE CONTAINED ON THIS FRAME WAS MADE IN THE NORMAL AND REGULAR COURSE OF BUSINESS, ON THE DATE STATED BELOW AND THAT IT IS AN ACCURATE REPRODUCTION OF THE DOCUMENT SUBMITTED TO MICROGRAPHICS.
DATE: 12-10-81 CAMERA OPERATOR: [Signature] SECTION SUPERVISOR: [Signature]

8309280310

