
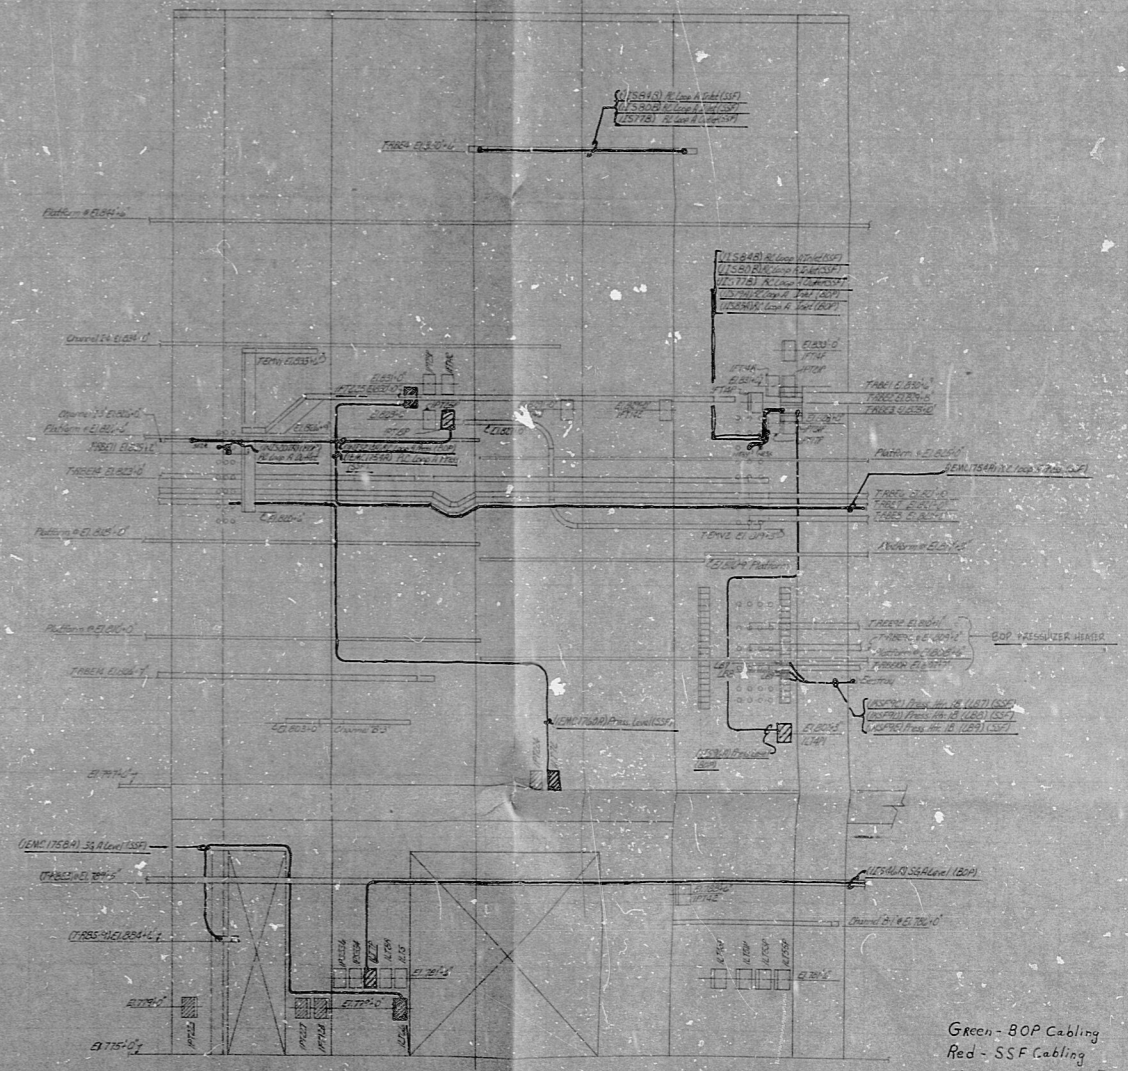


34" 22" 17" 11" 8.5" 8.5" 11" 17" 22" 34"

34" 22" 17" 11" 8.5" 8.5" 11" 17" 22" 34"

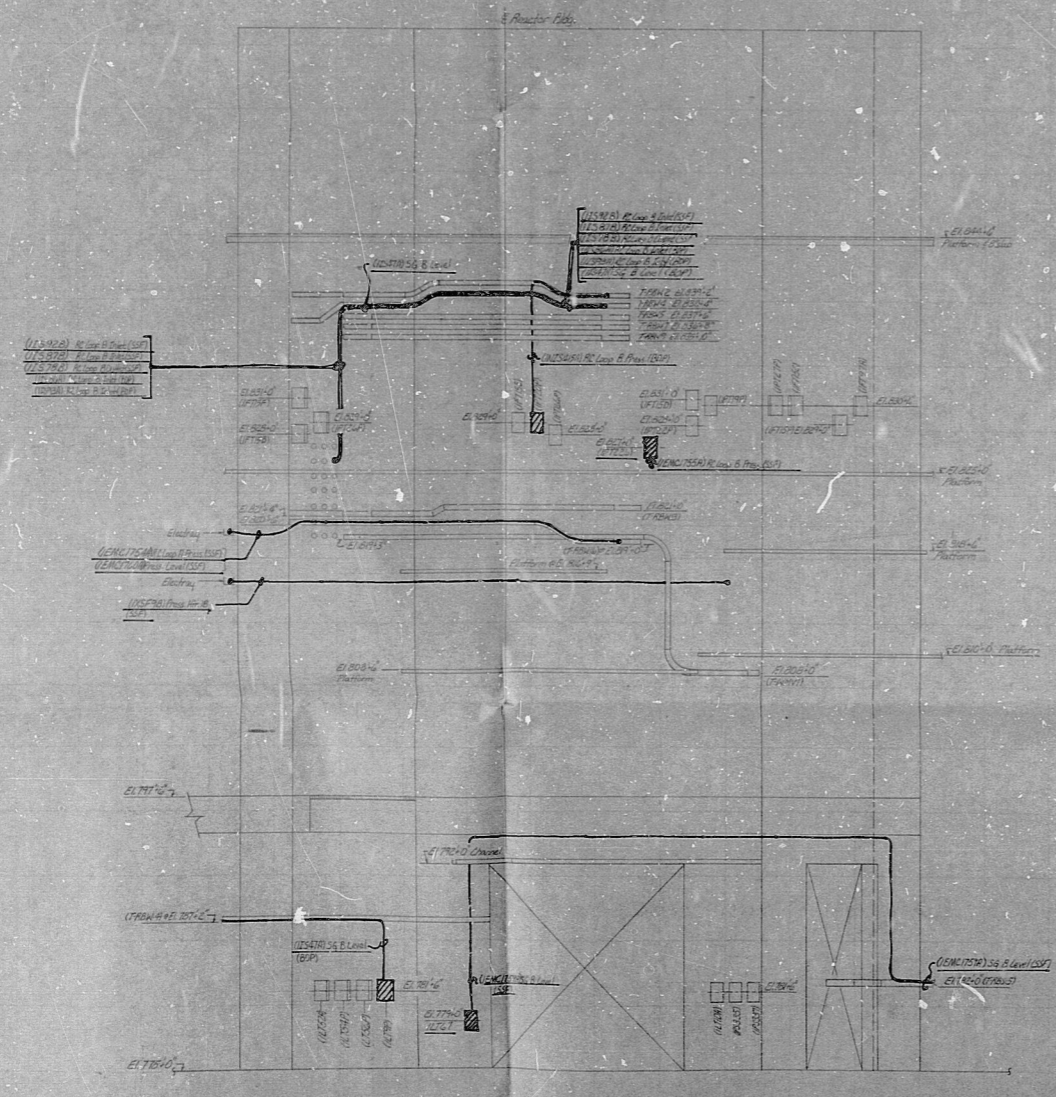

Green - BOP Cabling
Red - SSF Cabling

TERA APERTURE CARD

DUKE POWER COMPANY

UNIT 1

8105060735

NO.	REVISIONS	CHKD	DATE	APPR	DATE	CIVIL	ELEG	MECH	SCALE	INSPECTED	DATE	DWG. NO.

DESIGNER	DATE	INSP	DATE

RDS-PDR

7105050785

