


125 V.D.C. BATTERY BOARD #11  
3-29001-3

125 V.D.C. BATTERY BOARD #12

DC VALVE BOARD NO. II

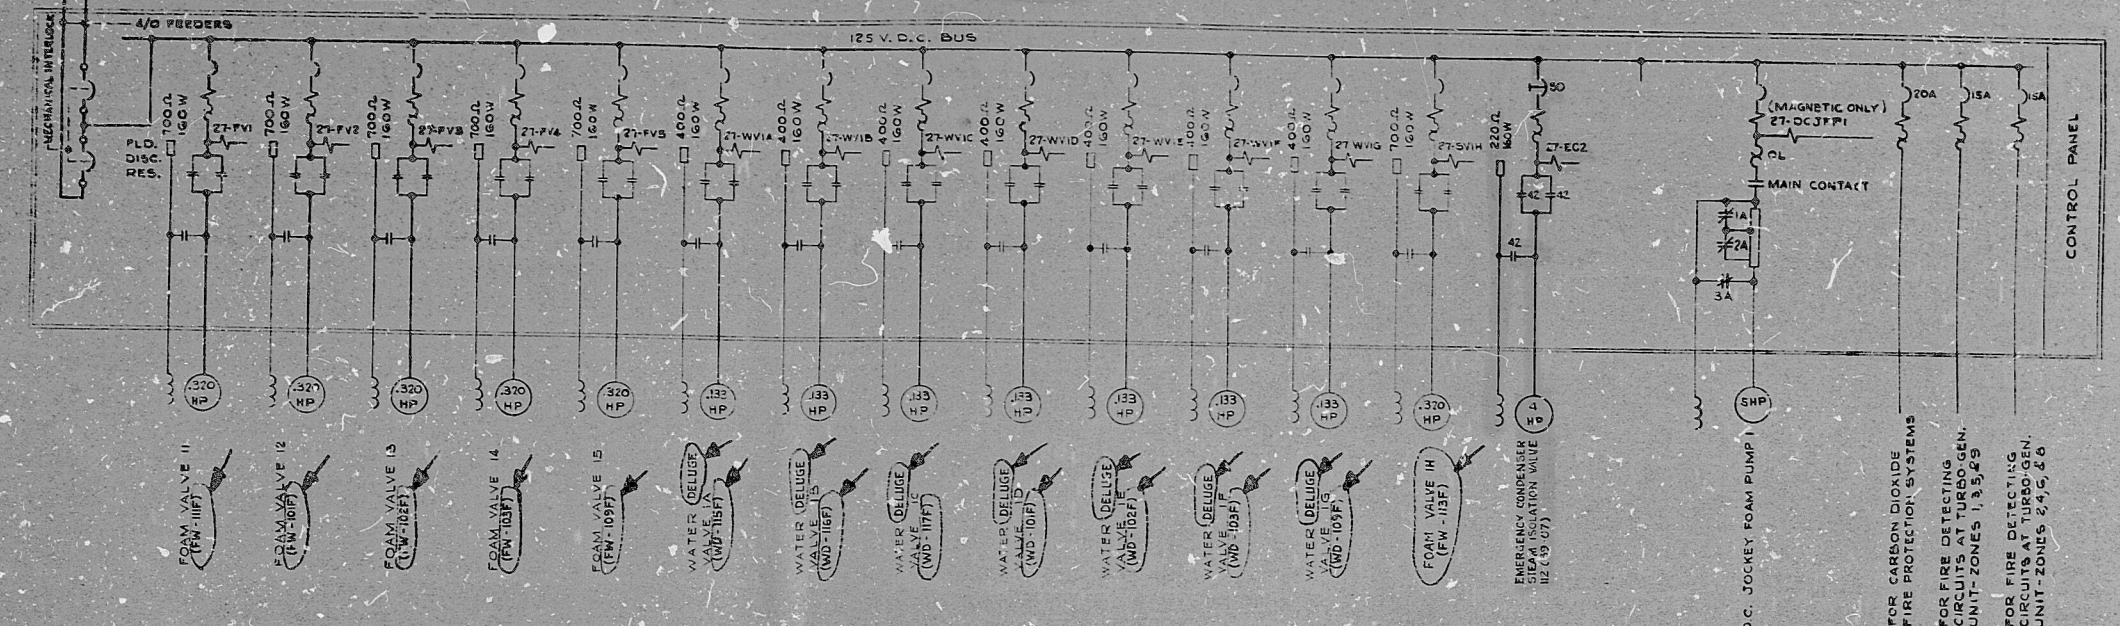


FOR CARBON DIOXIDE FIRE PROTECTION SYSTEMS  
FOR FIRE DETECTING CIRCUITS AT TURBIDEN. UNIT-ZONES 1, 3, 5, 6, 9  
FOR FIRE DETECTING CIRCUITS AT TURBIDEN. UNIT-ZONES 2, 4, 5, 6

DRIPPROOF ROOF

AD1	BO1	CO1	DO1	EO1	FO1	GO1
	GROUND	BUS				

CONDUITS SHALL ENTER BOARD FROM BOTTOM

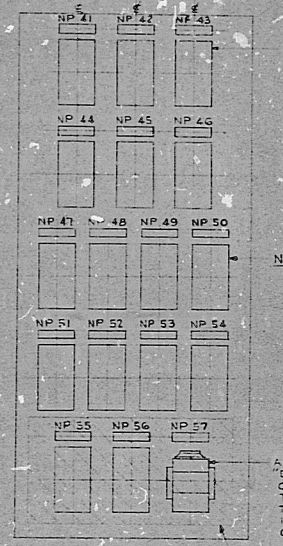

GE 60 TYPE 'HGA' RELAY, 125 V.D.C., FRONT CONTACTS WITHOUT COVER, CAT. # 12GAIN22 (16 RECD.)

PRO APERTURE CARD

NOTE 4 - RELAY ARRANGEMENT IS TENTATIVE, ITS MAIN PURPOSE BEING TO SHOW IDENTIFYING NAMEPLATES

NOTE 1 - SEE DWG. C-2200-C-314 (11) FOR WIRING OF CONTROL PANEL 'GO1'.  
NOTE 2 - FOR ELEMENTARY WIRING DIAGRAMS SEE DWG. C-34080-C-515 1-3 (1:50).  
NOTE 3 - VALVE MOTOR RATINGS  
HP FL. AMP. I.R. AMP. I.P.L.A.M. SH.FIBER.  
(a) 0.133 2.4 15.5 0.595 210.0  
(b) 0.320 3.6 24.0 0.294 425.0

AGSTAT 4000 SERIES TIMER. DELAY ON PULL-IN 0.001 TO 15 SECOND TIMING RANGE. TIMER TO BE SET TO TRANSFER ITS CONTACTS 3 SECONDS AFTER COIL IS ENERGIZED (1 REQ'D).

PHASED RELAYS WILL BE INSTALLED IN SECTION 'FO1' AS PER G.E.C.O. APPROVAL DWG. # SKGL-37727A SH. 6

POOR ORIGINAL

DWG. NO.	EN. NO.	INDEX	REFERENCE DWG. TITLE
C-34080-C	1-5	3-N2-E38	ELEMENTARY WIRING DIAGRAM-FOAM & TURBO-GENERATOR WATER SPRAY SYSTEMS
C-2230-C	1-6	3-N2-E21	INTERCONNECTON DIAGRAM 125 VOLTS D.C. VALVE BOARD # II
C-19837-C		3-N2-E6	125 VOLTS D.C. VALVE BOARD # II FLOOR PLAN & FRONT VIEW

FORMERLY DWG. # ME-751, SH. # 1

NO.	DATE	DESCRIPTION
1	10/27/77	DESIGN, DRAWING, AND CHECK BY ME
2	11/14/77	CORRECTED PER FIELD CHECK
3	12/22/77	CHANGED SH. NO. OF REF. DWG. IN NOTE #5
4	1/16/78	ADDED REFERENCE DRAWINGS
5	3/7/78	CHANGED MOTOR HP OF FOAM VALVES #14 & #15 FROM .133 TO .320 HP
6	3/7/78	CHANGED MOTOR HP OF FOAM VALVE #16 FROM .320 TO .133
7	4/2/78	REARRANGED STARTERS AT FRONT VIEW PER WORKING PANELS # 205 & 217

MEADARA MORGAN POWER CORPORATION  
NINE MILE POINT NUCLEAR STATION  
ONE LINE DIAGRAM AND FRONT VIEW  
D.C. VALVE BOARD NO. II

17"

8.5"

8.5"

11"

17"



RIDS

8210270040

