


- NOTES:**
 - 11) CHECKED BY: [Signature]

REACTOR PROTECTION SYSTEM			
SERVICE	CONDITION	SET POINT	ACTION

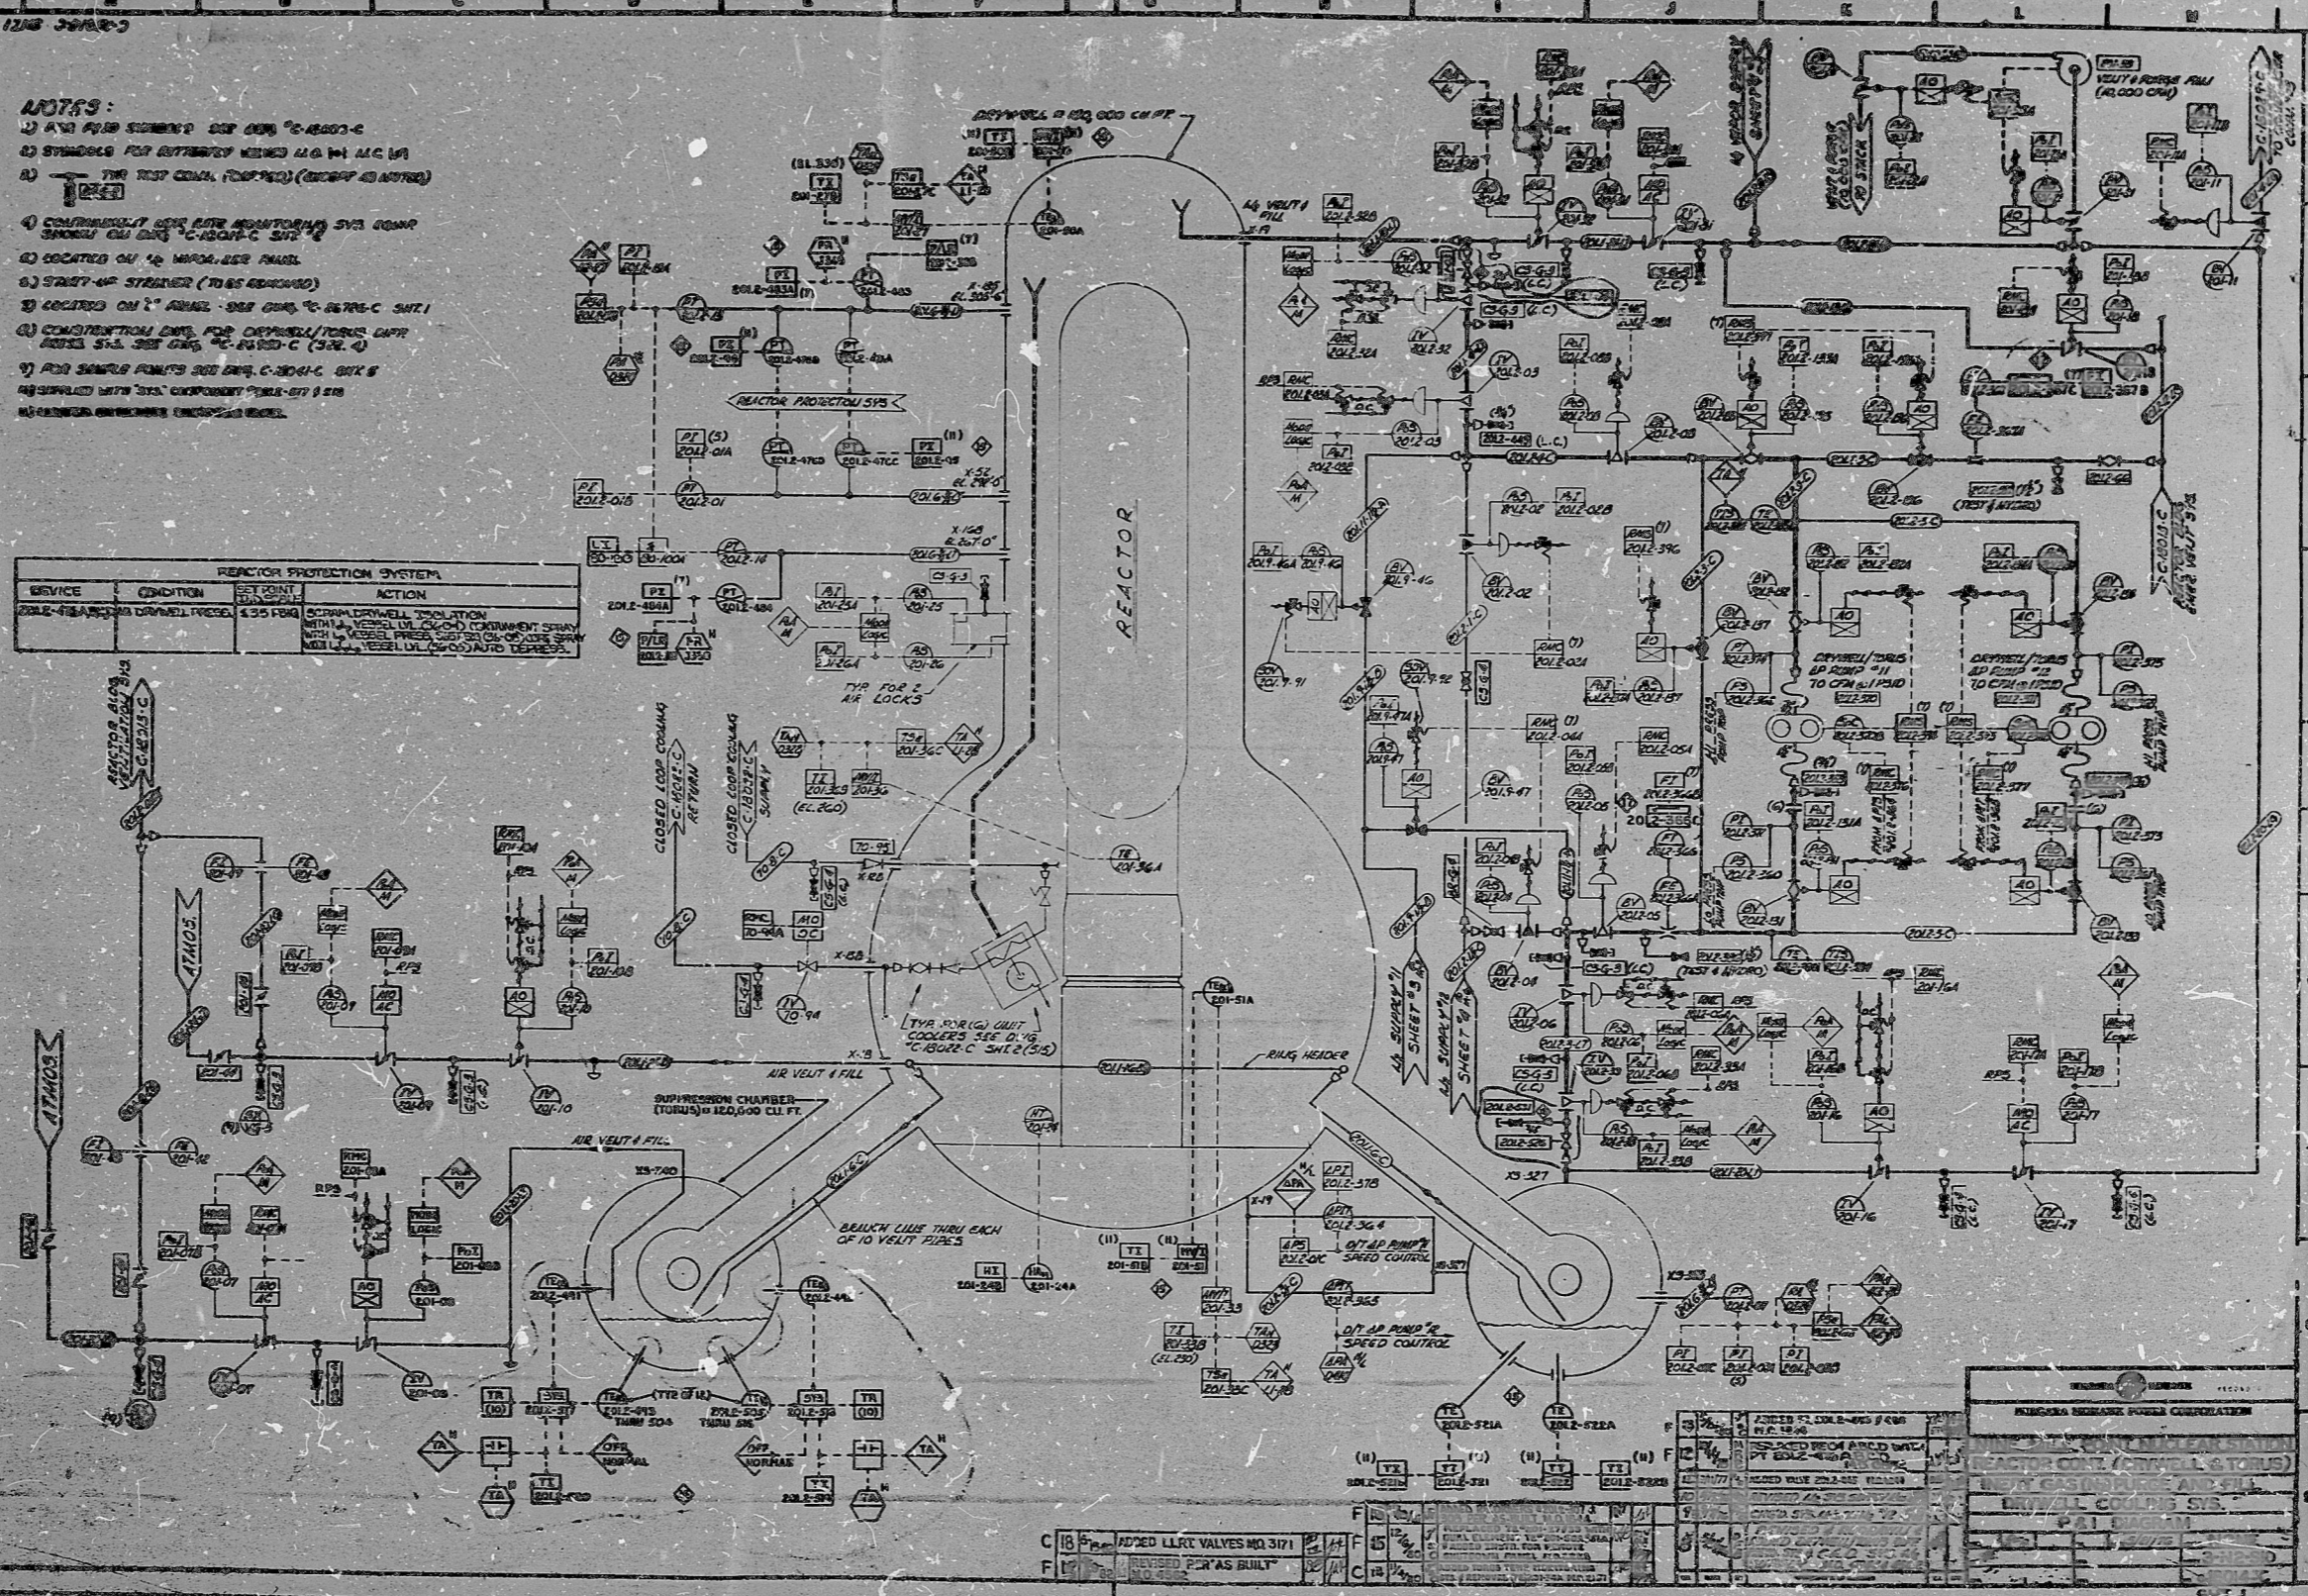

NO.	DESCRIPTION	DATE	BY	CHKD.
Roll #390
30X
POOR ORIGINAL
P&ID APERTURE CARD
CH 12 & 13

DDAPID
RIDS

82107 0065

