


8021


11

A B C D E F G H I J K L M

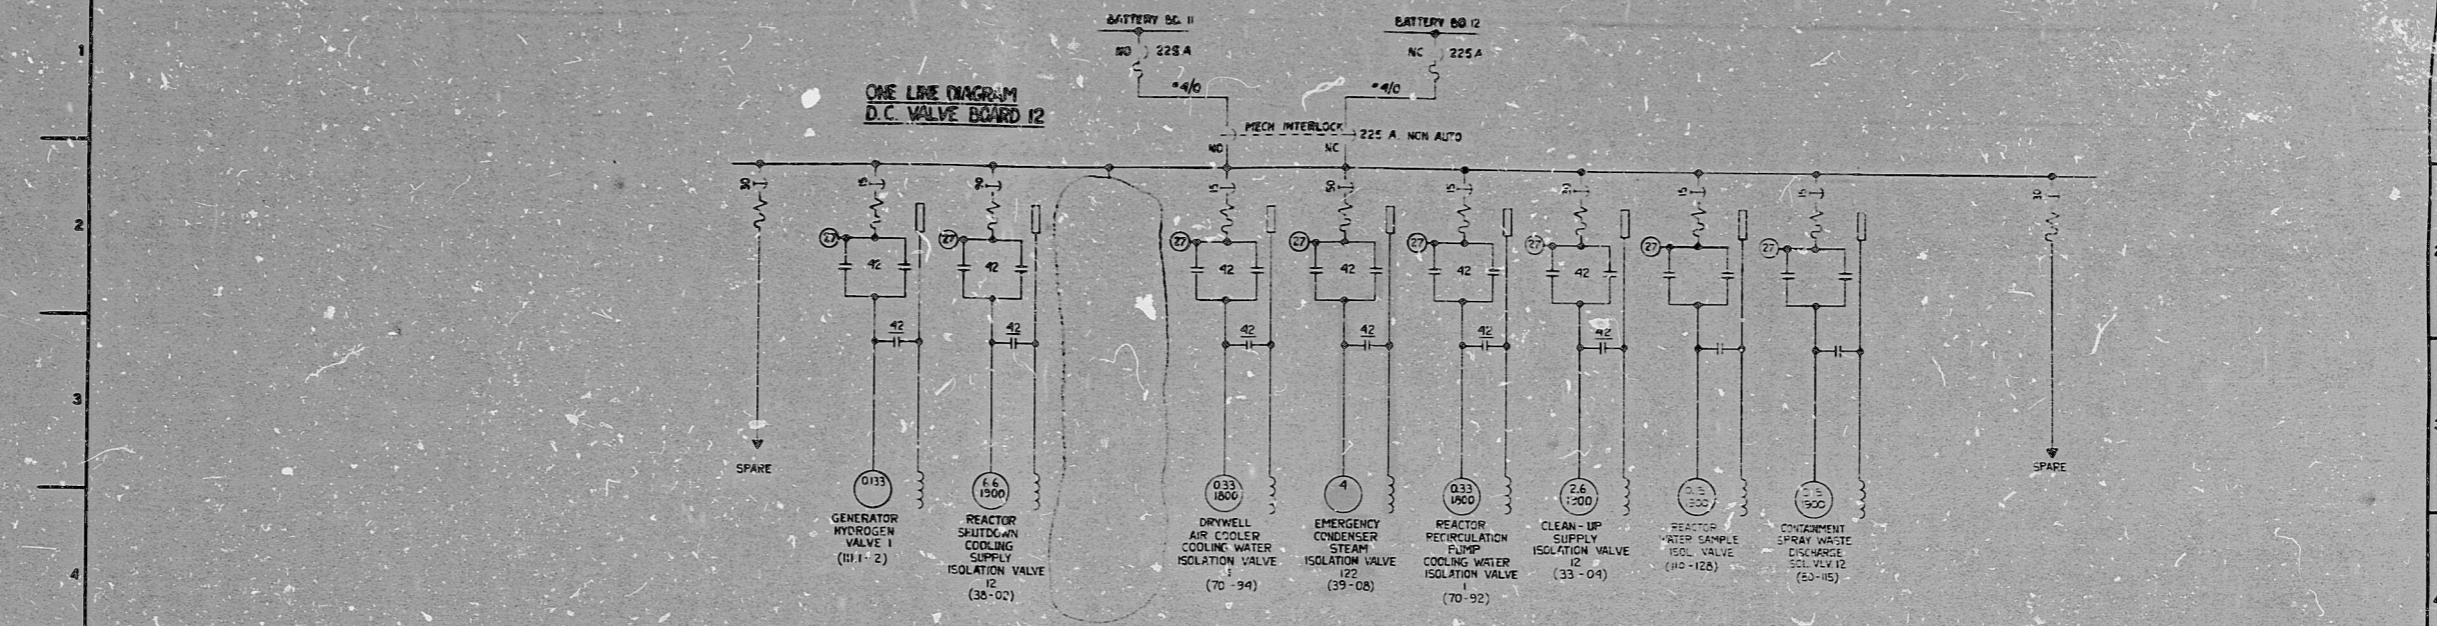

11

8.5

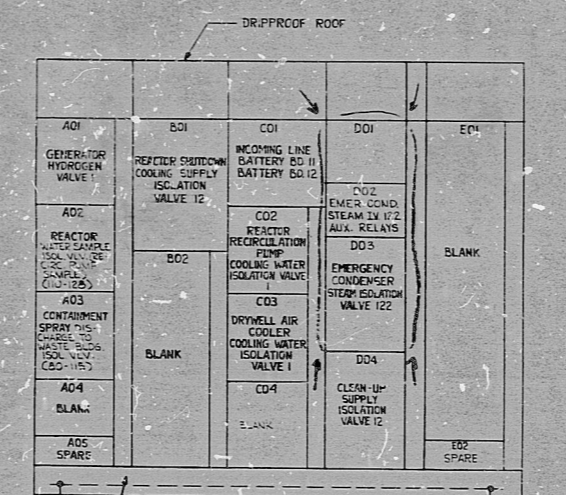

POOR ORIGINAL

PRC APERTURE CARD

*4/0 SOLID
FRONT VIEW
CONDUITS SHALL ENTER BOARD FROM BOTTOM

NIAGARA MOHAWK	
NIAGARA MOHAWK POWER CORPORATION	
MINE MILE POINT NUCLEAR STATION	
ELEMENTARY WIRING DIAGRAM	
D.C. VALVE BOARD 12	
REV	DATE
1	3-12-62
2	3-12-62
8.5

11

Boil 311
30-x

17

R. DS

8210270105

