


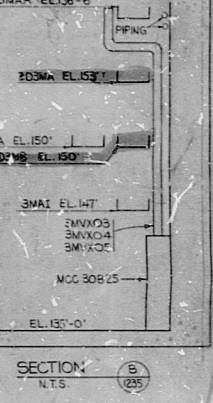
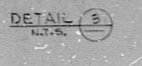
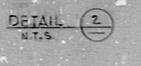
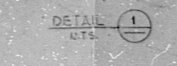


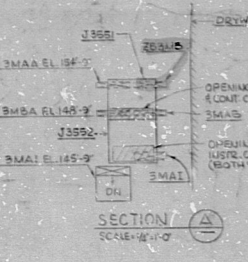

E-1235

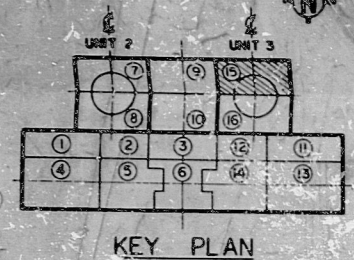

KEY PLAN

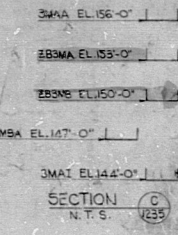



PROC APERTURE CARD
POOR ORIGINAL

BECHTEL
PEACH BOTTOM ATOMIC POWER STATION UNITS No. 2 & 3
REACTOR BUILDING UNIT 3 AREA 15EL165
E-1235 51
881030386

RIDS

8210270326

